

**CONSTRUCTION PLANS**  
**FOR**  
**HATFIELD & COMPANY, INC.**  
**DISCOVERY BLVD. & INNOVATION ST.**  
**ROCKWALL**  
**3.66 ACRES**  
**CITY OF ROCKWALL, ROCKWALL COUNTY, TEXAS**  
**DECEMBER 2011**

FOR



2708 TELECOM PARKWAY, SUITE 120, RICHARDSON TX 75082  
 (214) 299-4800, FAX: (214) 299-4444

OWNER




206 S. TOWN EAST BLVD. (972) 285-0115  
 MESQUITE, TX. 75149-2897 (800) 879-9191

PREPARED BY




8350 N. CENTRAL EXPWY., SUITE 1000 PH. 972.235.3031  
 DALLAS, TEXAS 75206 FAX 972.235.9544  
 TX REG. ENGINEERING FIRM F-469  
 TX REG. SURVEYING FIRM LS-100080-00

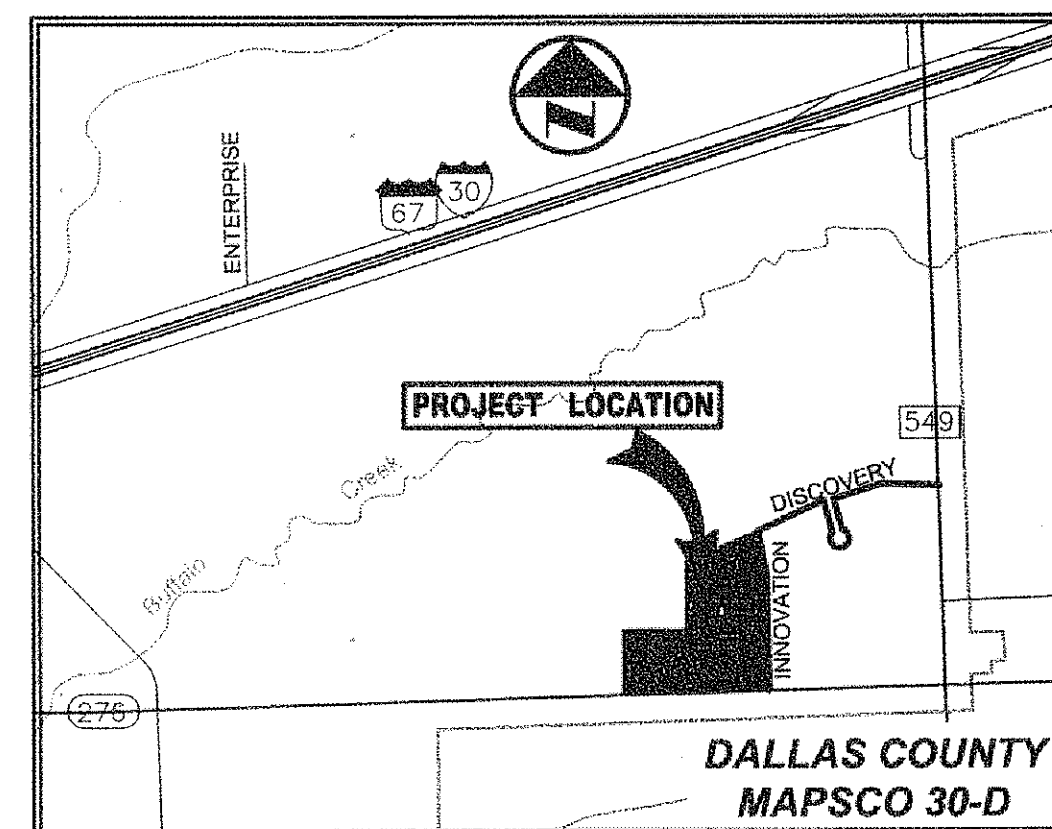

**VICINITY MAP**  
 (NOT TO SCALE)

**DRAWING SHEET INDEX**

<u>SHEET</u>	<u>DESCRIPTION</u>
C0.0	COVER SHEET
	REPLAT
SP-1	SITE PLAN
C1.1	DEMOLITION PLAN
C2.1	DIMENSIONAL CONTROL PLAN
C3.1	GRADING PLAN
C4.1	DRAINAGE AREA MAP
C4.2	STORM SEWER PLAN
C4.3	STORM SEWER PROFILES
C4.4	DETENTION PLAN
C4.5	DETENTION PLAN
C5.1	WATER AND SANITARY SEWER PLAN
C6.1	PAVING PLAN
C6.2	PAVING DETAILS
C7.1	EROSION CONTROL PLAN
C7.2	EROSION CONTROL DETAILS

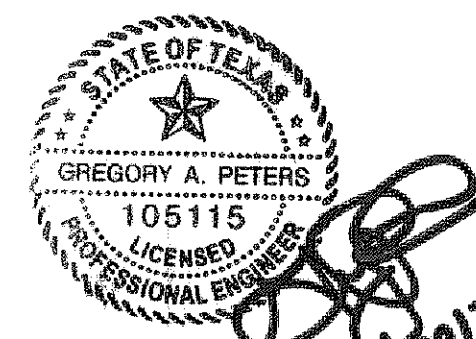

*Handwritten signature and date: 9/19/2012*

**RECORD DRAWING**  
 THIS DRAWING HAS BEEN REVISED TO REFLECT CONSTRUCTION RECORDS MAINTAINED AND PROVIDED BY THE CONTRACTOR FOR THIS PROJECT.  
 CONTRACTOR: HILL & WILKINSON  
 DATE REVISED: 08/30/2012

KINKLER 09/15/2012 3:02PM H:\Proj-20\_2058-11\_325.DWG (3D) 2058-11-325-CV.DWG

HATFIELD & COMPANY, INC.