




**1 STABILIZED CONSTRUCTION ENTRANCE**  
NOT TO SCALE

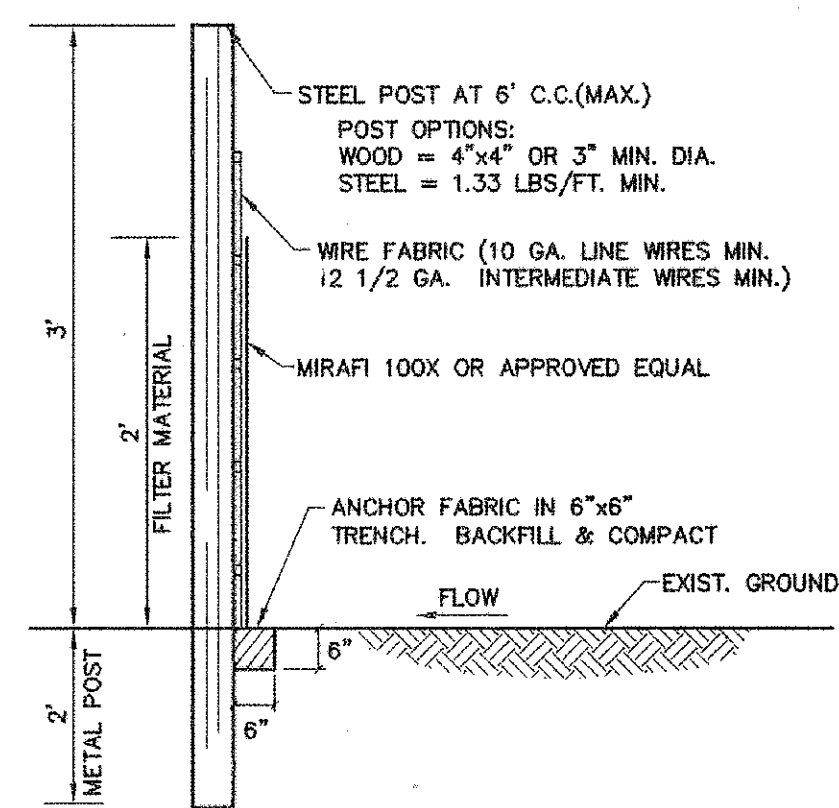


**2 SILT FENCE**  
NOT TO SCALE

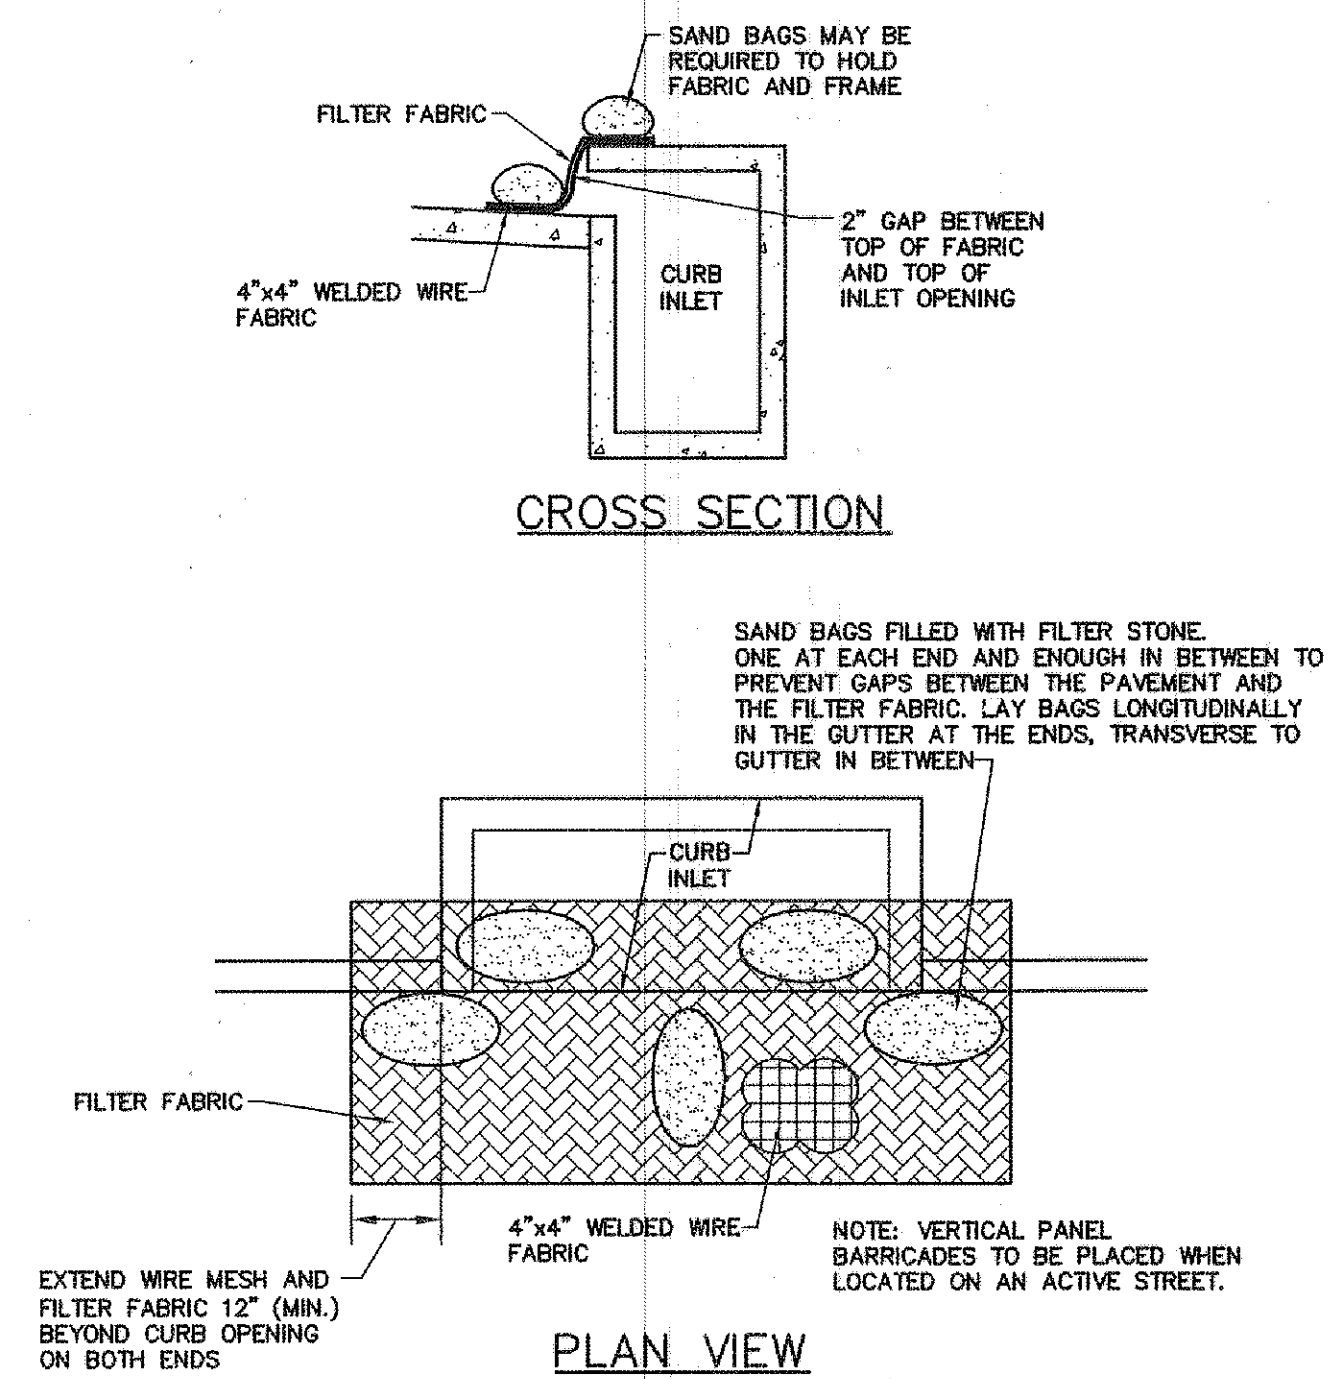


**3 CURB INLET PROTECTION**  
NOT TO SCALE

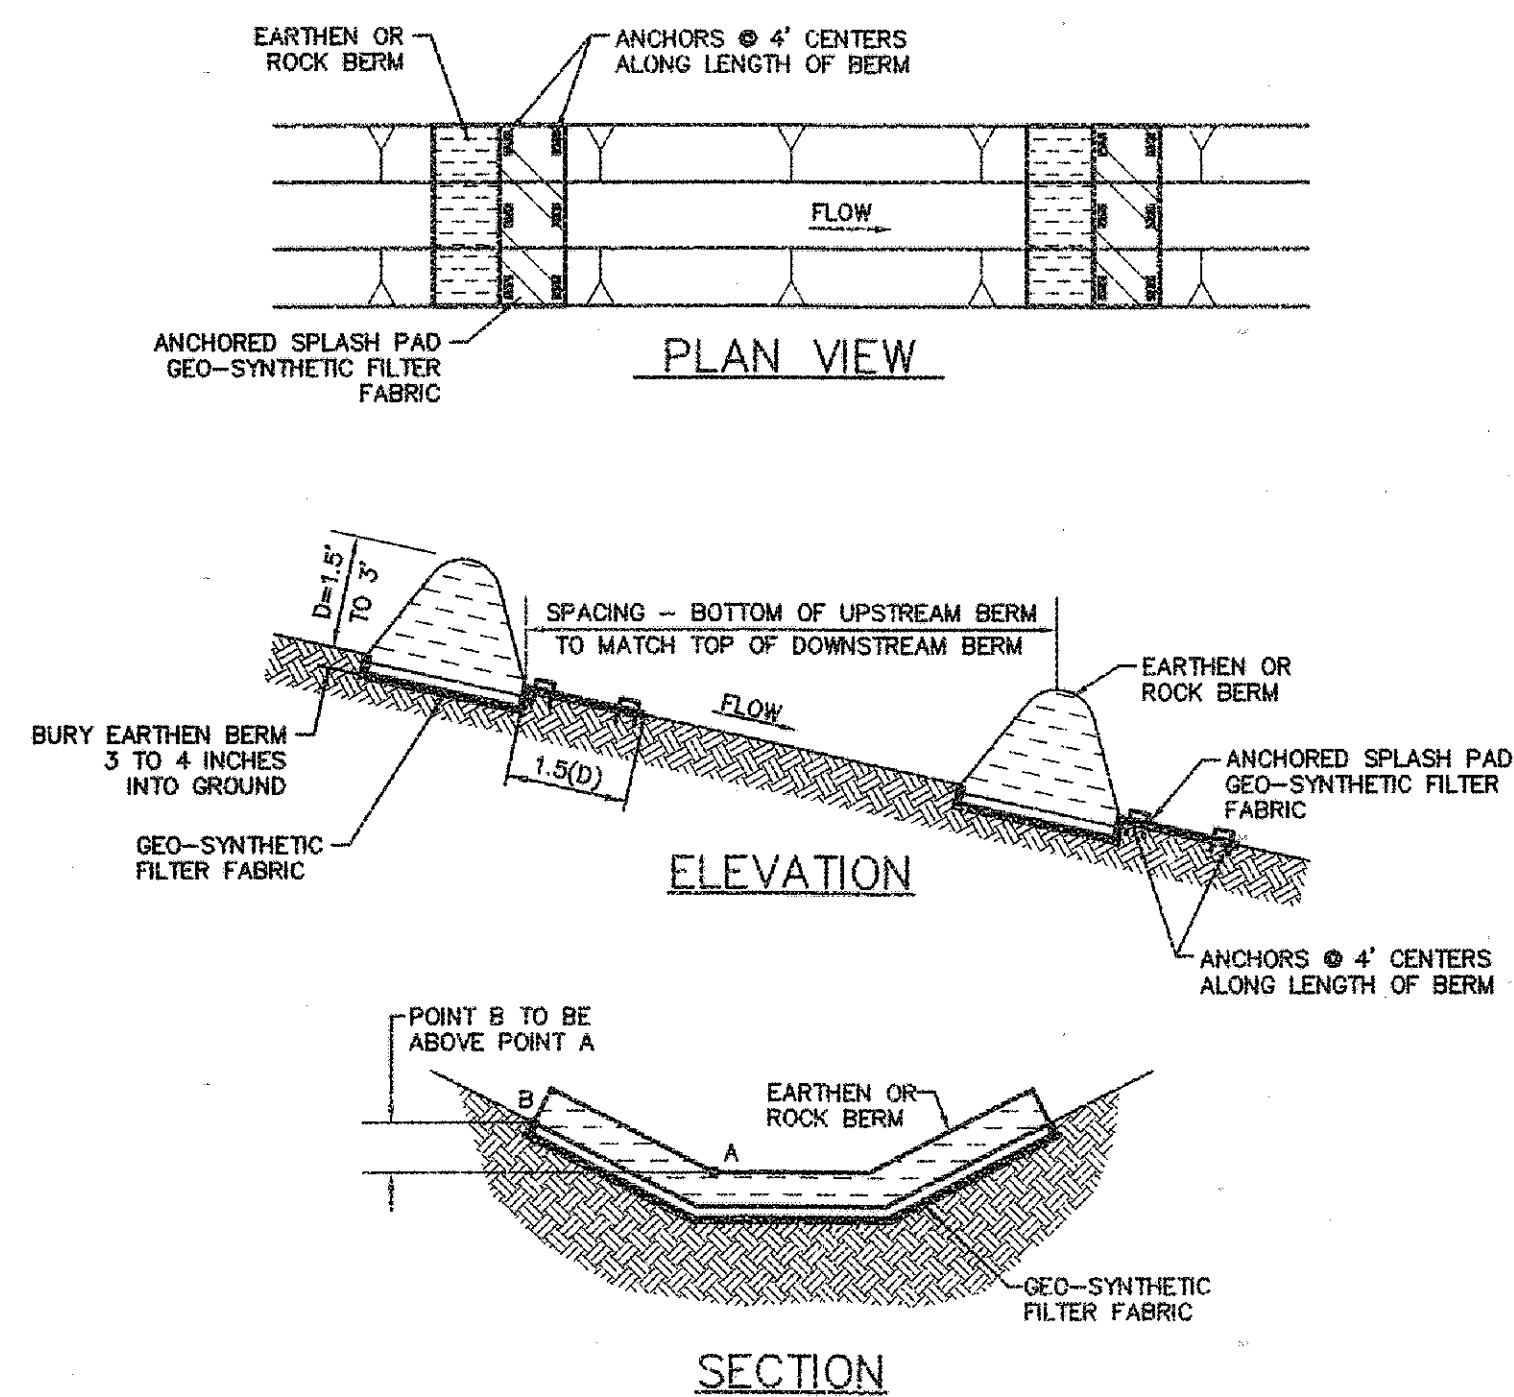

**4 CHECK DAMS**  
NOT TO SCALE

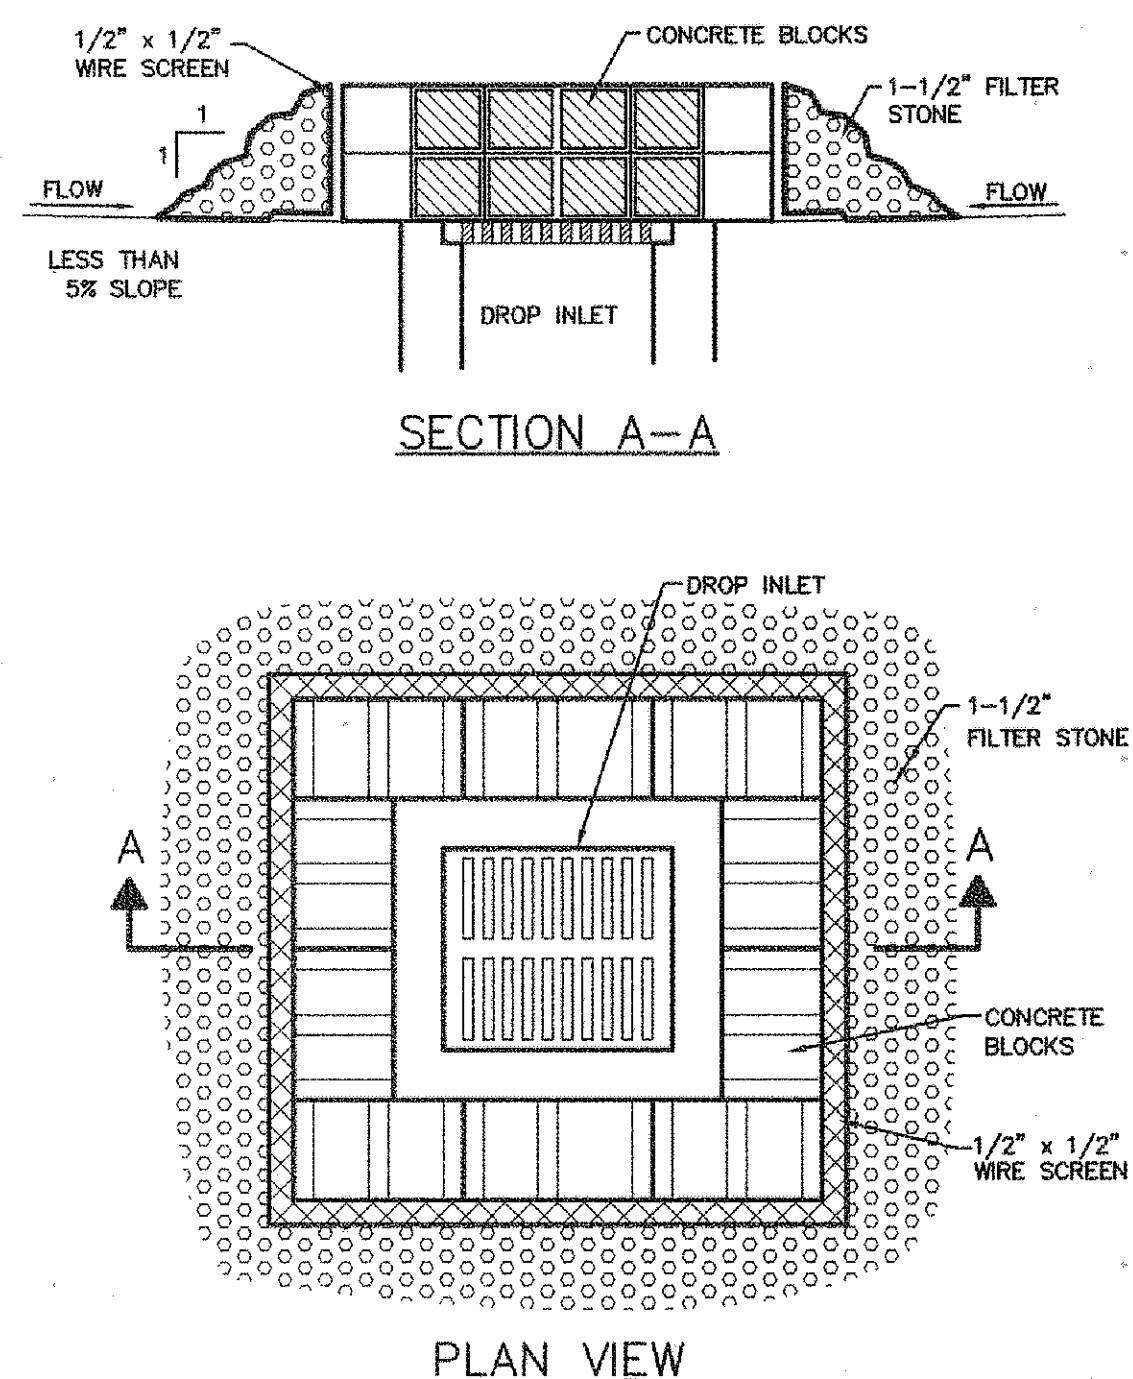

**5 DROP INLET PROTECTION**  
NOT TO SCALE

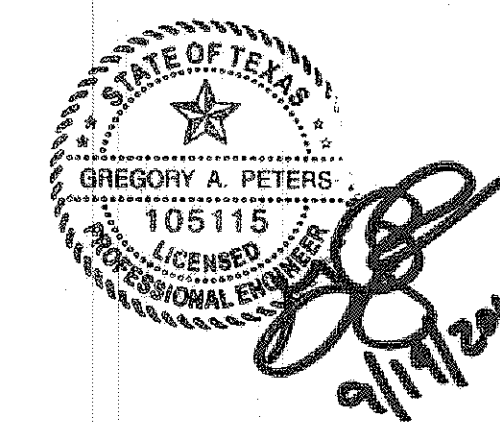

**RECORD DRAWING**  
THIS DRAWING HAS BEEN REVISED TO REFLECT CONSTRUCTION RECORDS MAINTAINED AND PROVIDED BY THE CONTRACTOR FOR  
CONTRACTOR: HILL & WILKINSON  
DATE REVISED: 08/30/2012

NO.	DATE	REVISION
1	08/30/2012	RECORD DRAWING

**Pacheco Koch**  
8350 N. CENTRAL EXPWY., SUITE 1000  
DALLAS, TX 75206 972.235.3031  
DALLAS • FORT WORTH • HOUSTON TX REG. ENGINEERING FIRM F-489  
TX REG. SURVEYING FIRM LS-100080-00

**EROSION CONTROL DETAILS**  
**HATFIELD & COMPANY, INC.**  
**DISCOVERY BLVD. & INNOVATION ST.**  
**ROCKWALL**  
**CITY OF ROCKWALL, ROCKWALL COUNTY, TX**

DESIGN	DRAWN	DATE	SCALE	NOTES	FILE	NO.
GAP	GAP	MARCH 2012	1"=40'			<b>C7.2</b>

KUNKLER 08/19/2012 - 12:38PM M:\DWG-20\2058-11.325.DWG(C:3D) 2058-11-325-EP.DWG