

**LEGEND**

	MEDIUM DUTY CONCRETE PAVEMENT 6" OF 3600 PSI CONCRETE (6.5 SACK MIX) W/#3 O.C.E.W. ON 24" CENTERS 6" SUBGRADE AND COMPACTED TO 95% STANDARD PROCTOR.
	LIGHT DUTY CONCRETE PAVEMENT 5" OF 3000 PSI CONCRETE (MIN. 5.5 SACK MIX) W/#3 O.C.E.W. ON 24" CENTERS 6" SUBGRADE AND COMPACTED TO 95% STANDARD PROCTOR.
	LBJ LONGITUDINAL BUTT JOINT
	NUMBER OF PARKING SPACES

- NOTES**
- ALL DIMENSIONS ARE TO FACE OF CURB UNLESS OTHERWISE NOTED.
  - PAVEMENT SHALL BE CONSTRUCTED PER RECOMMENDATIONS OF FUGRO CONSULTANT'S GEOTECHNICAL INVESTIGATION WITH PROJECT NUMBER 04-4008-1168 DATED DECEMBER 2008.


**PROJECT DATA:**

ADDRESS:	1701 SCIENCE PL ROCKWALL, TX 75032
LEGAL:	LOTS 1,2,&4, BLOCK D ROCKWALL TECHNOLOGY PARK
PROJECT AREA:	1.15 ACRES
PLATTED:	YES
OWNER:	L-3 AEROSPACE SYSTEMS 600 THIRD AVENUE NEW YORK, NY 10016 (212) 697-1111
DEVELOPER:	CORGAN 401 NORTH HOUSTON STREET DALLAS, TX 75202 (214) 748-2000
LAND USE:	COMMERCIAL
PARKING SPACES:	139 (NEW) 56 (NET NEW FROM RESTRIPIING) 195 TOTAL

**RECORD DRAWING**

THIS RECORD DRAWING REFLECTS, TO THE BEST OF THE ENGINEER'S KNOWLEDGE, THE APPROXIMATE LOCATION OF THE CONSTRUCTED WORK BASED UPON INFORMATION PROVIDED BY THE CONTRACTOR AND WAS PREPARED WITHOUT THE BENEFIT OF AN AS-BUILT SURVEY. THIS RECORD DRAWING MAY DEVIATE FROM THE ORIGINAL CONSTRUCTION DOCUMENTS DUE TO FIELD CHANGES DURING CONSTRUCTION. THE ENGINEER'S SEAL OR SIGNATURE ON THIS DRAWING IS NOT INTENDED TO INDICATE THE ENGINEER'S APPROVAL OR ACCEPTANCE OF ANY SUCH DEVIATIONS FROM THE DESIGN.

*Travis N. Attanasio* DATE: 07/23/15  
TRAVIS N. ATTANASIO, P.E. 98433

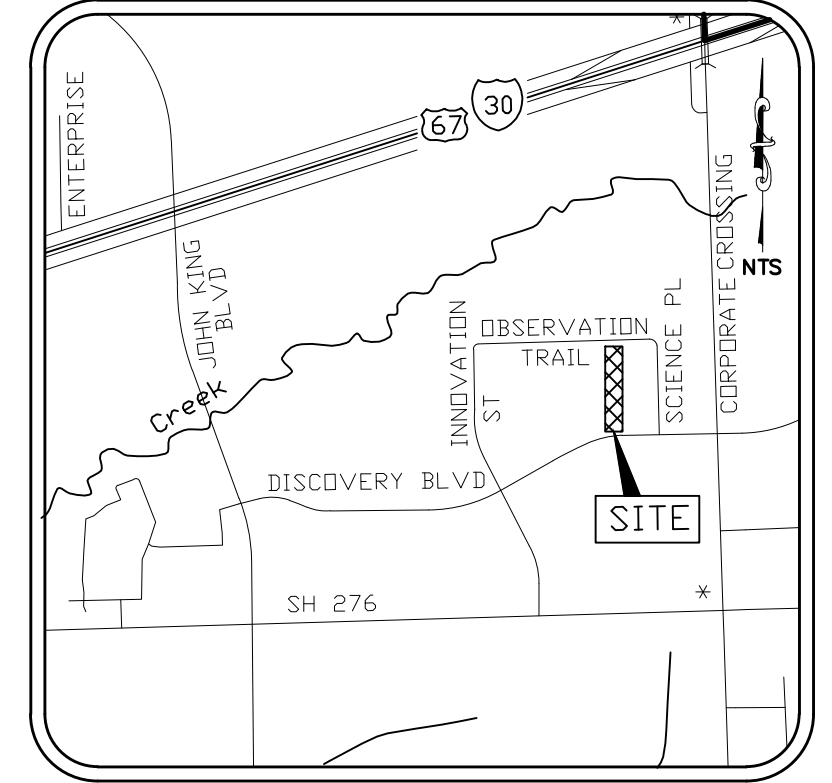

**BANNISTER ENGINEERING**  
1696 COUNTRY CLUB DRIVE | Mansfield, TX 76063 | 817.842.2094 | 817.842.2095 fax  
TEXAS FIRM REGISTRATION NO. F-10599

**ROCKWALL SCIENCE PLACE  
L-3 AEROSPACE SYSTEMS  
1701 SCIENCE PLACE, ROCKWALL, TX**

**SITE PLAN**

No.	Date	Revision Description



SHEET NO.

**C-2.1**

CASE NO. SP2015-001