

GRADING LEGEND

| | |
|-----------|-----------------------------------|
| ---607--- | EXISTING CONTOUR |
| —607— | PROPOSED CONTOURS |
| → | DIRECTION OF FLOW |
| 607.50 | TOP OF PAVEMENT OR PROPOSED GRADE |
| ME | MATCH EXISTING |

- NOTES**
1. ALL SLOPES WITHIN ACCESSIBLE PARKING AREAS SHALL NOT EXCEED 2.0% IN ALL DIRECTIONS. ALL SLOPES ALONG ACCESSIBLE ROUTES SHALL NOT EXCEED 5.0% LONGITUDINALLY AND 2.0% IN CROSS-SLOPE.
 2. ALL SPOT ELEVATIONS ARE TO TOP OF PAVEMENT (GUTTER LINE) UNLESS OTHERWISE NOTED. ADD 0.5' FOR TOP OF CURB.
 3. REFER TO SHEET C-1.1 FOR ADDITIONAL NOTES.
 4. REFER TO GENERAL NOTES SHEET FOR SITE ACCESSIBILITY STANDARDS
 5. CONTRACTOR SHALL REFERENCE GENERAL NOTES SHEET FOR ADDITIONAL INFORMATION. INFORMATION ON GENERAL NOTES SHEET IS PART OF A UNIFIED DESIGN AND IS PERTINENT TO THIS PLAN SHEET.


OBSERVATION TRAIL
60' RIGHT-OF-WAY
DRAWER D, PAGES 175 & 176, P.R.R.C.T.

DISCOVERY BOULEVARD
85' RIGHT-OF-WAY
DRAWER D, PAGES 175 & 176, P.R.R.C.T.

BANNISTER ENGINEERING
1808 COUNTRY CLUB DRIVE | METROPLEX, TX 76003 | 817.842.2094 | 817.842.2095 fax
TEXAS PROFESSIONAL ENGINEERING #16099

ROCKWALL SCIENCE PLACE
L-3 AEROSPACE SYSTEMS
1701 SCIENCE PLACE, ROCKWALL, TX
GRADING PLAN

| No. | Date | Revision/Description |
|-----|------|----------------------|
| | | |
| | | |
| | | |

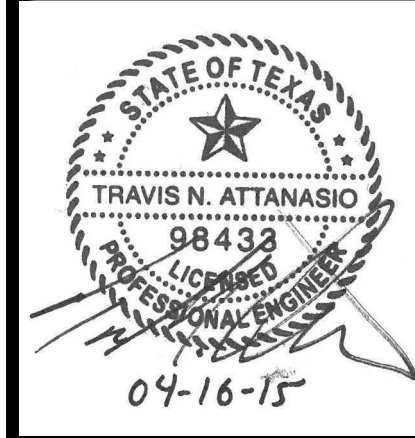

SHEET NO.

C-3.1

RECORD DRAWING
THIS RECORD DRAWING REFLECTS, TO THE BEST OF THE ENGINEER'S KNOWLEDGE, THE APPROXIMATE LOCATION OF THE CONSTRUCTED WORK BASED UPON INFORMATION PROVIDED BY THE CONTRACTOR AND WAS PREPARED WITHOUT THE BENEFIT OF AN AS-BUILT SURVEY. THIS RECORD DRAWING MAY DEVIATE FROM THE ORIGINAL CONSTRUCTION DOCUMENTS DUE TO FIELD CHANGES DURING CONSTRUCTION. THE ENGINEER'S SEAL OR SIGNATURE ON THIS DRAWING IS NOT INTENDED TO INDICATE THE ENGINEER'S APPROVAL OR ACCEPTANCE OF ANY SUCH DEVIATIONS FROM THE DESIGN.
Travis N. Attanasio DATE: 07/23/15
TRAVIS N. ATTANASIO, P.E. 98433