


RECORD DRAWING
THIS RECORD DRAWING REFLECTS, TO THE BEST OF THE ENGINEER'S KNOWLEDGE, THE APPROXIMATE LOCATION OF THE CONSTRUCTED WORK BASED UPON INFORMATION PROVIDED BY THE CONTRACTOR AND WAS PREPARED WITHOUT THE BENEFIT OF AN AS-BUILT SURVEY. THIS RECORD DRAWING MAY DEVIATE FROM THE ORIGINAL CONSTRUCTION DOCUMENTS DUE TO FIELD CHANGES DURING CONSTRUCTION. THE ENGINEER'S SEAL OR SIGNATURE ON THIS DRAWING IS NOT INTENDED TO INDICATE THE ENGINEER'S APPROVAL OR ACCEPTANCE OF ANY SUCH DEVIATIONS FROM THE DESIGN.

DATE: 07/23/15
TRAVIS N. ATTANASIO, P.E. 98433

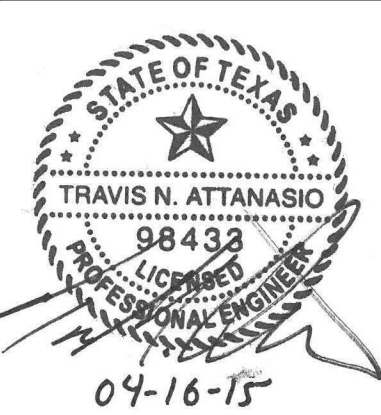

SHEET NO.
C-5.1

ROCKWALL SCIENCE PLACE
L-3 AEROSPACE SYSTEMS
1701 SCIENCE PLACE, ROCKWALL, TX
CONSTRUCTION DETAILS

BANNISTER
ENGINEERING
1606 COUNTRY CLUB DRIVE | METROPLEX | METROPLEX, TX 76003 | 817.842.2094 | 817.842.2095 fax
TEXAS PROFESSIONAL ENGINEERING REGISTRATION NO. P-70289