




D3 DECIDUOUS TREE PLANTING
1/4" = 1'-0"

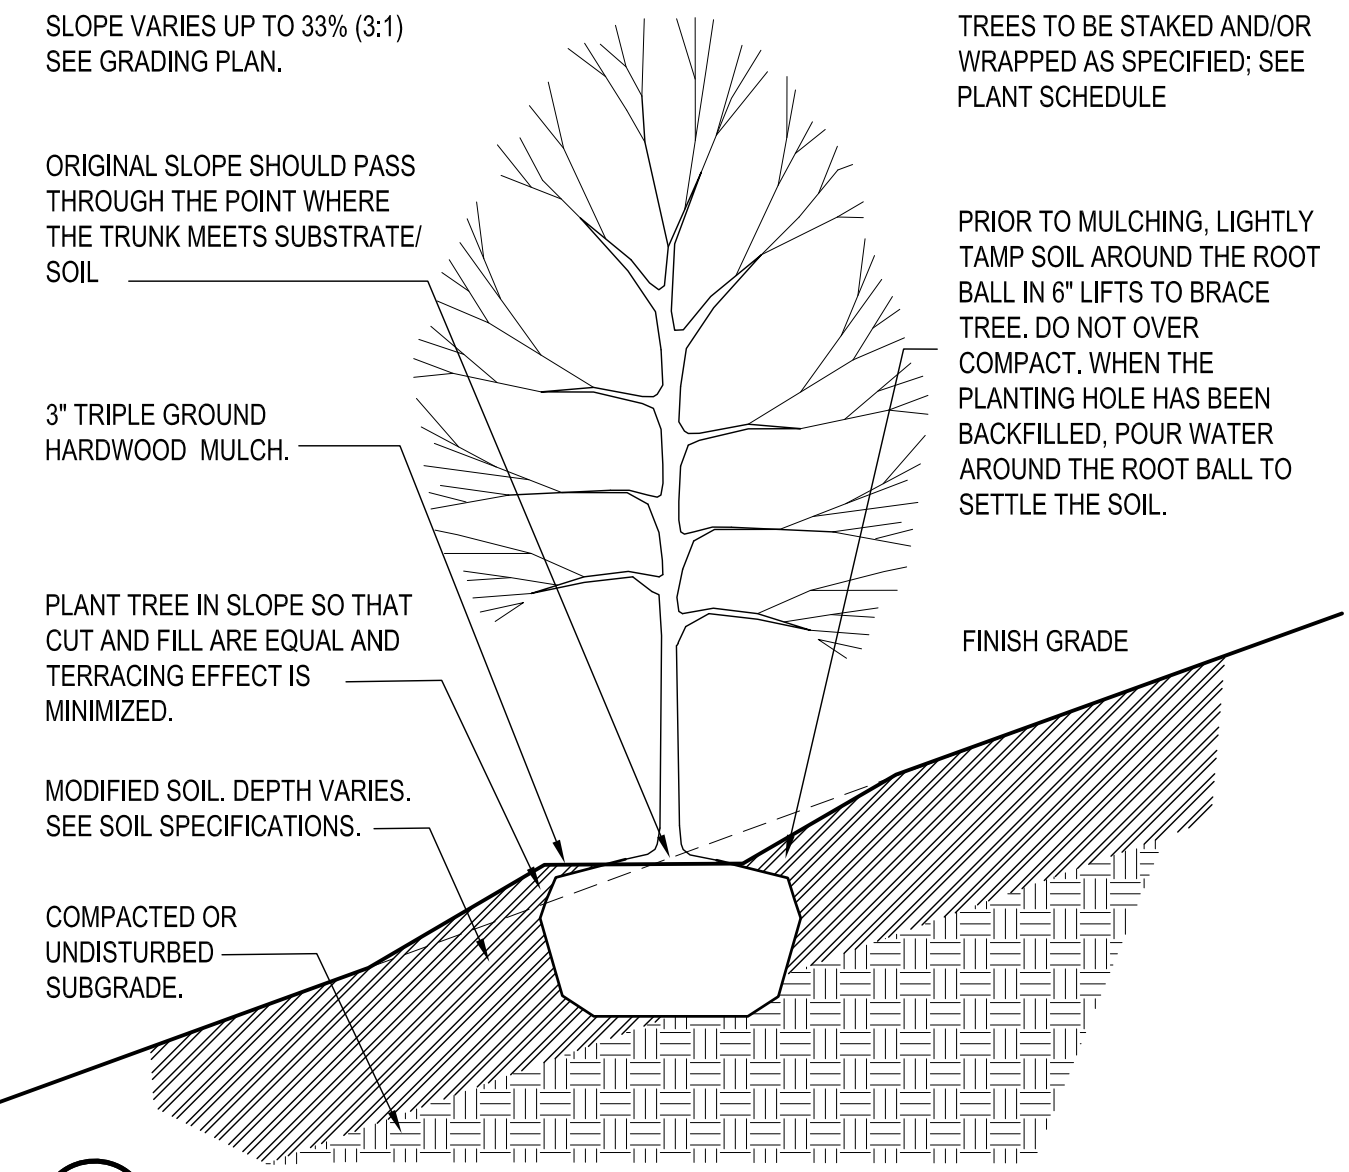


C8 DECIDUOUS TREE PLANTING ON SLOPE
1/4" = 1'-0"

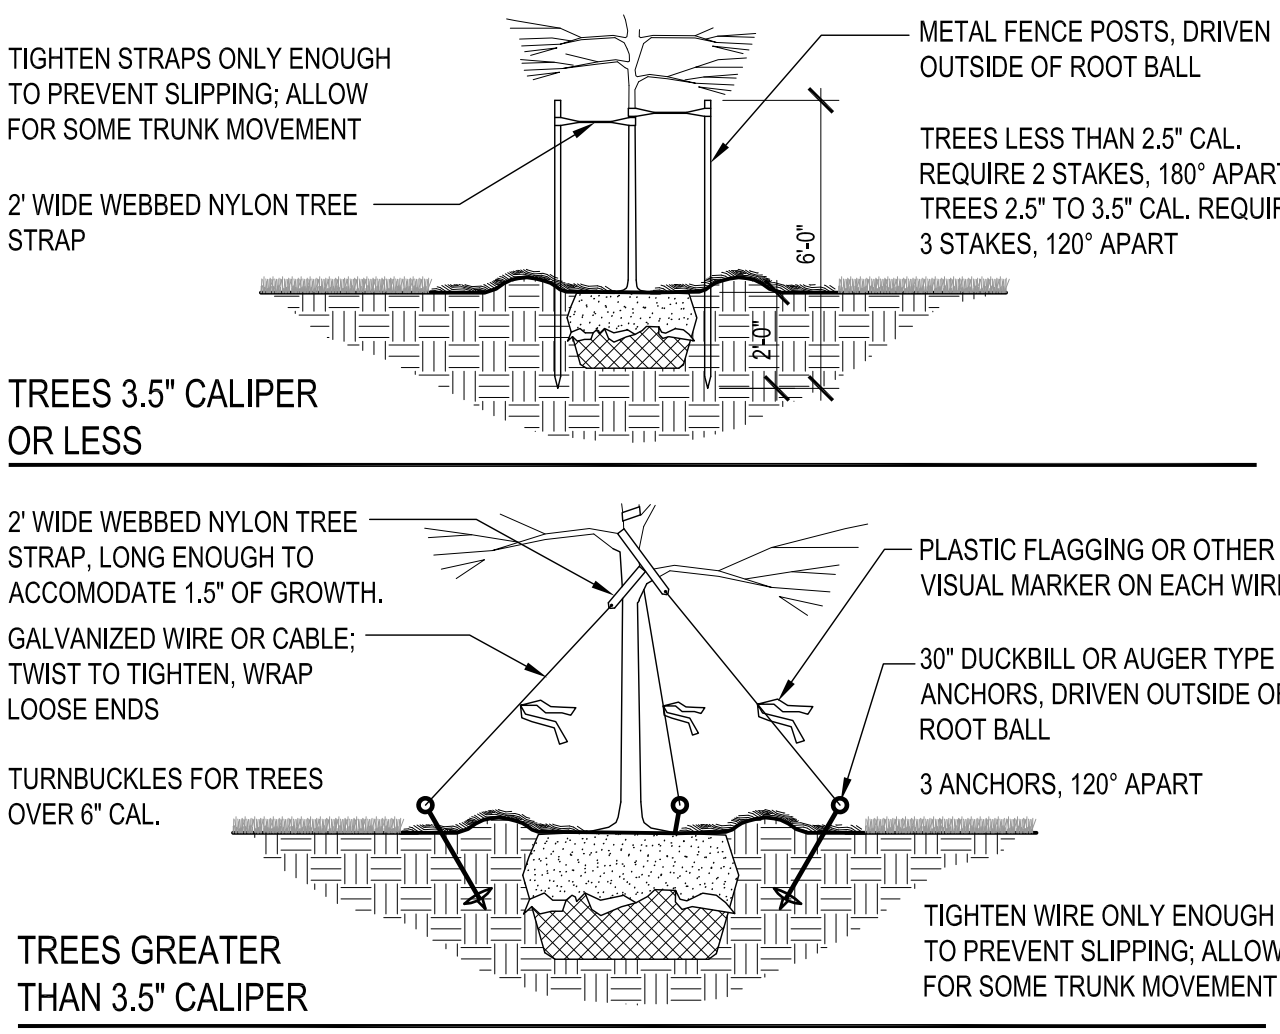


B3 TREE STAKING
1/4" = 1'-0"

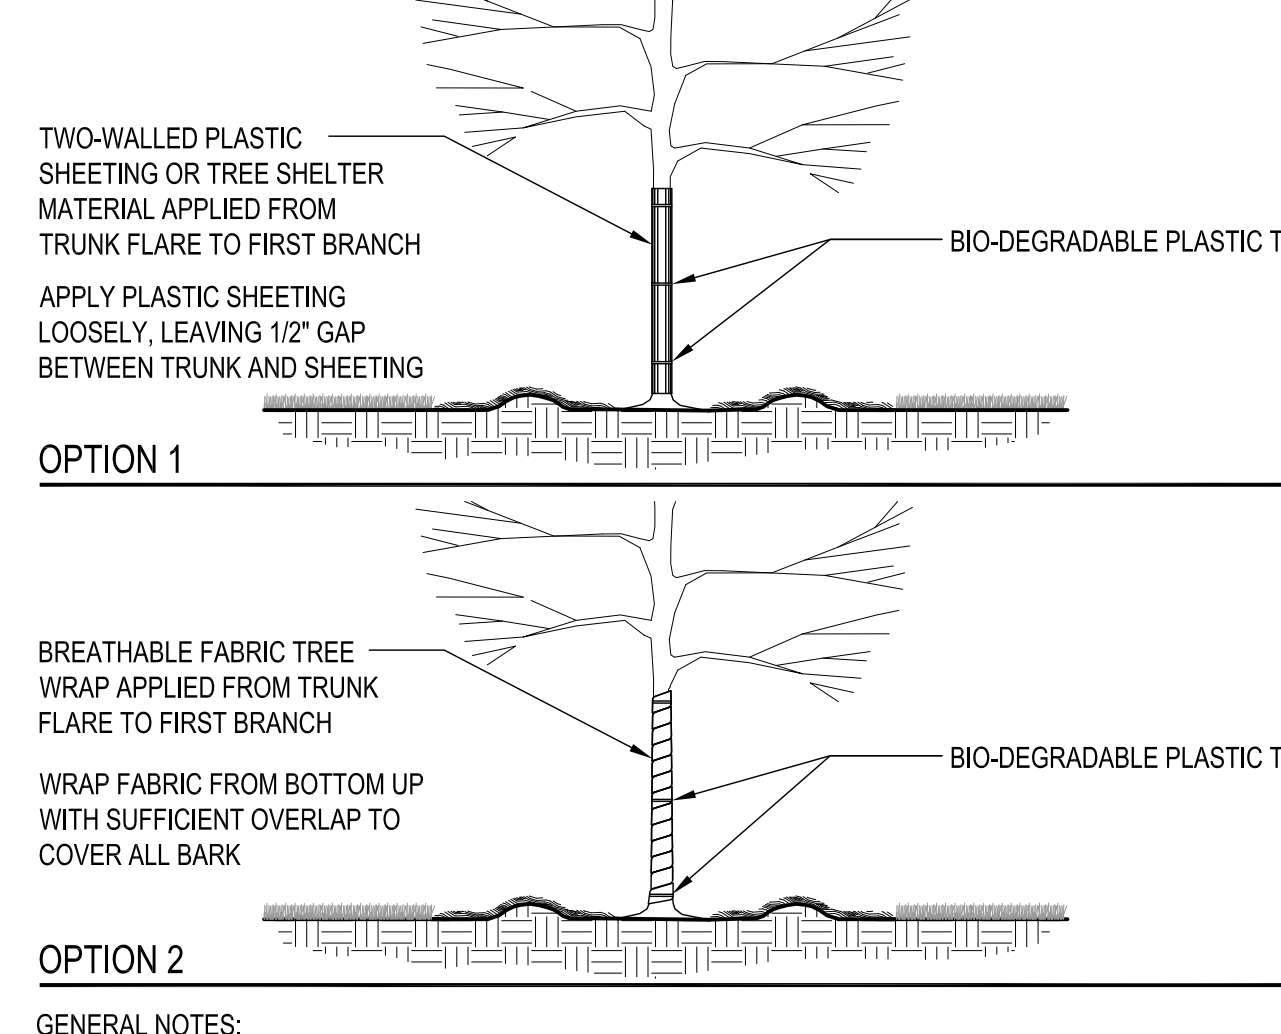


A3 TREE WRAPPING
1/4" = 1'-0"

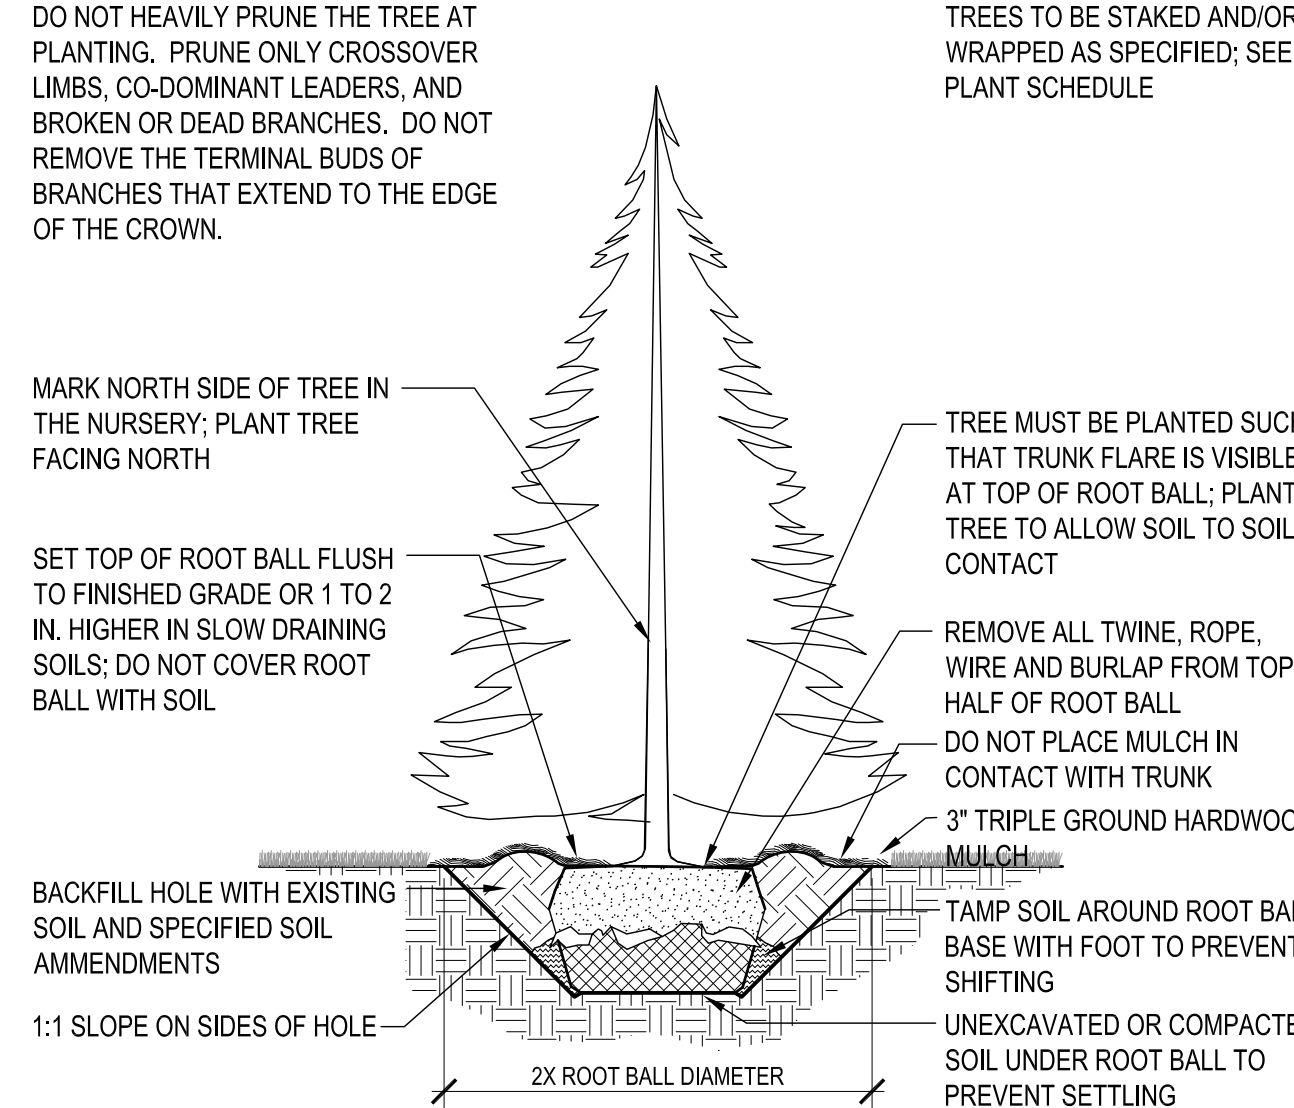


D2 EVERGREEN TREE PLANTING
1/4" = 1'-0"

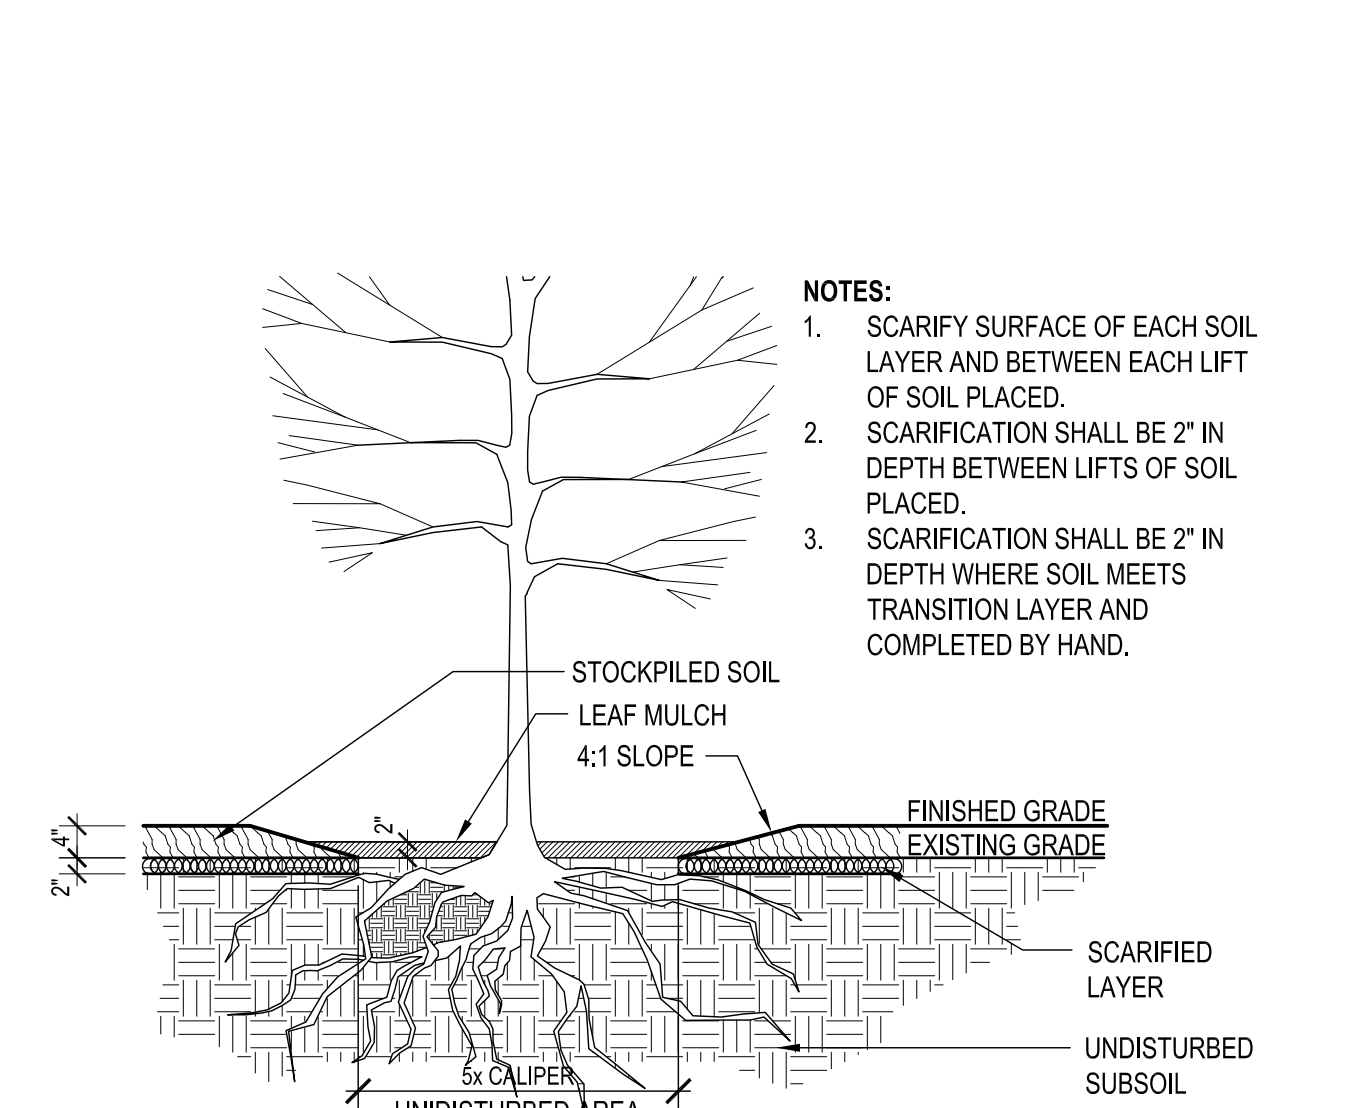


C2 EXISTING TREES IN LAWN AREAS
1" = 1'-0"

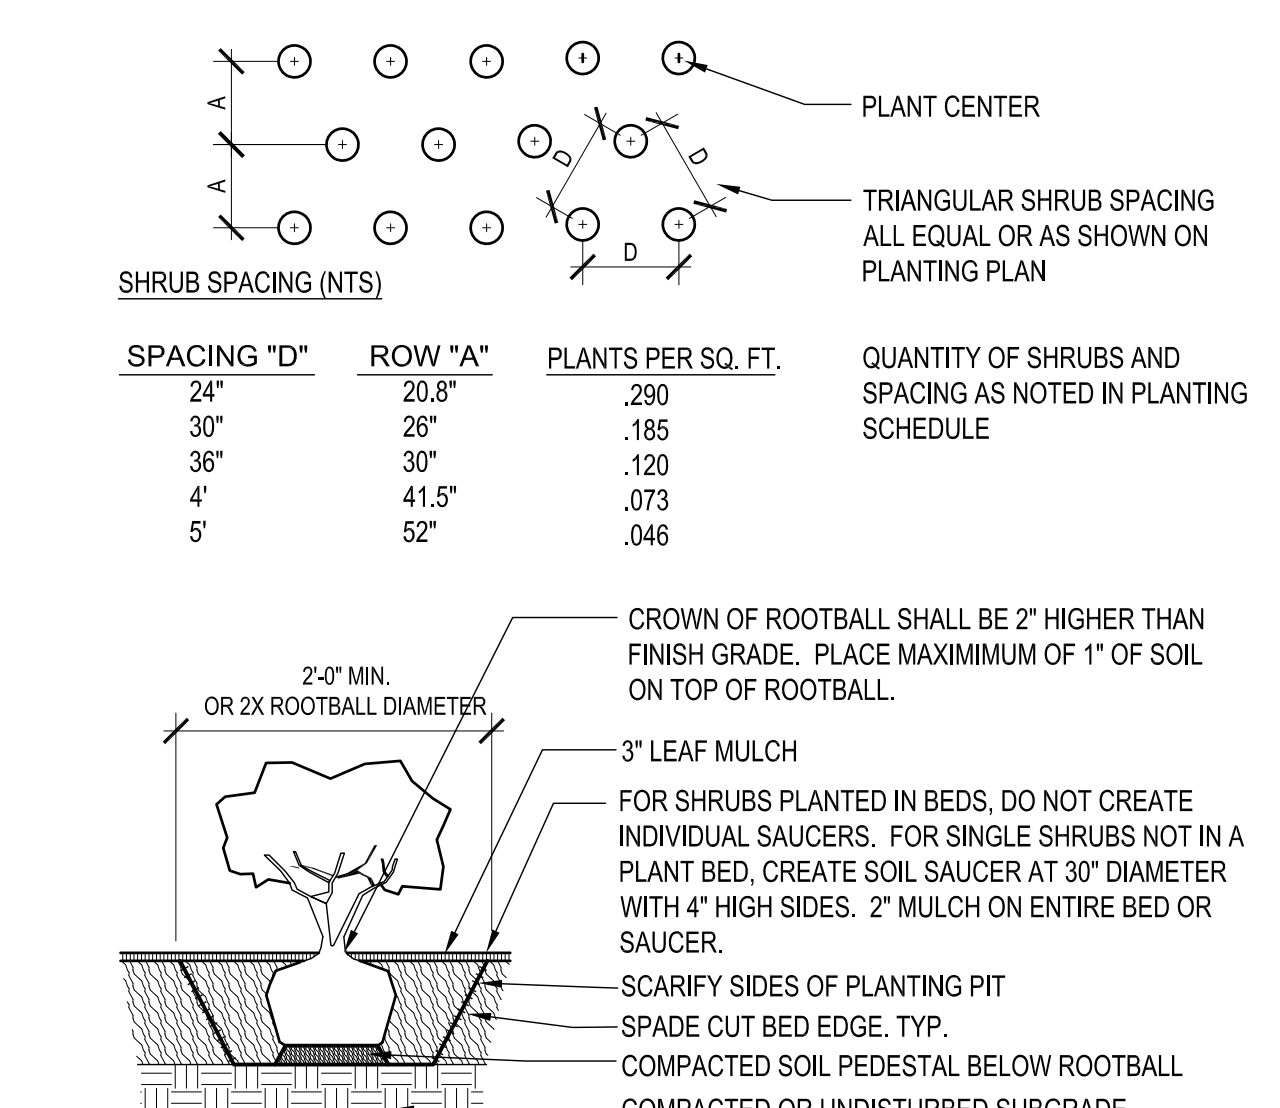


B2 SHRUB PLANTING
1/4" = 1'-0"

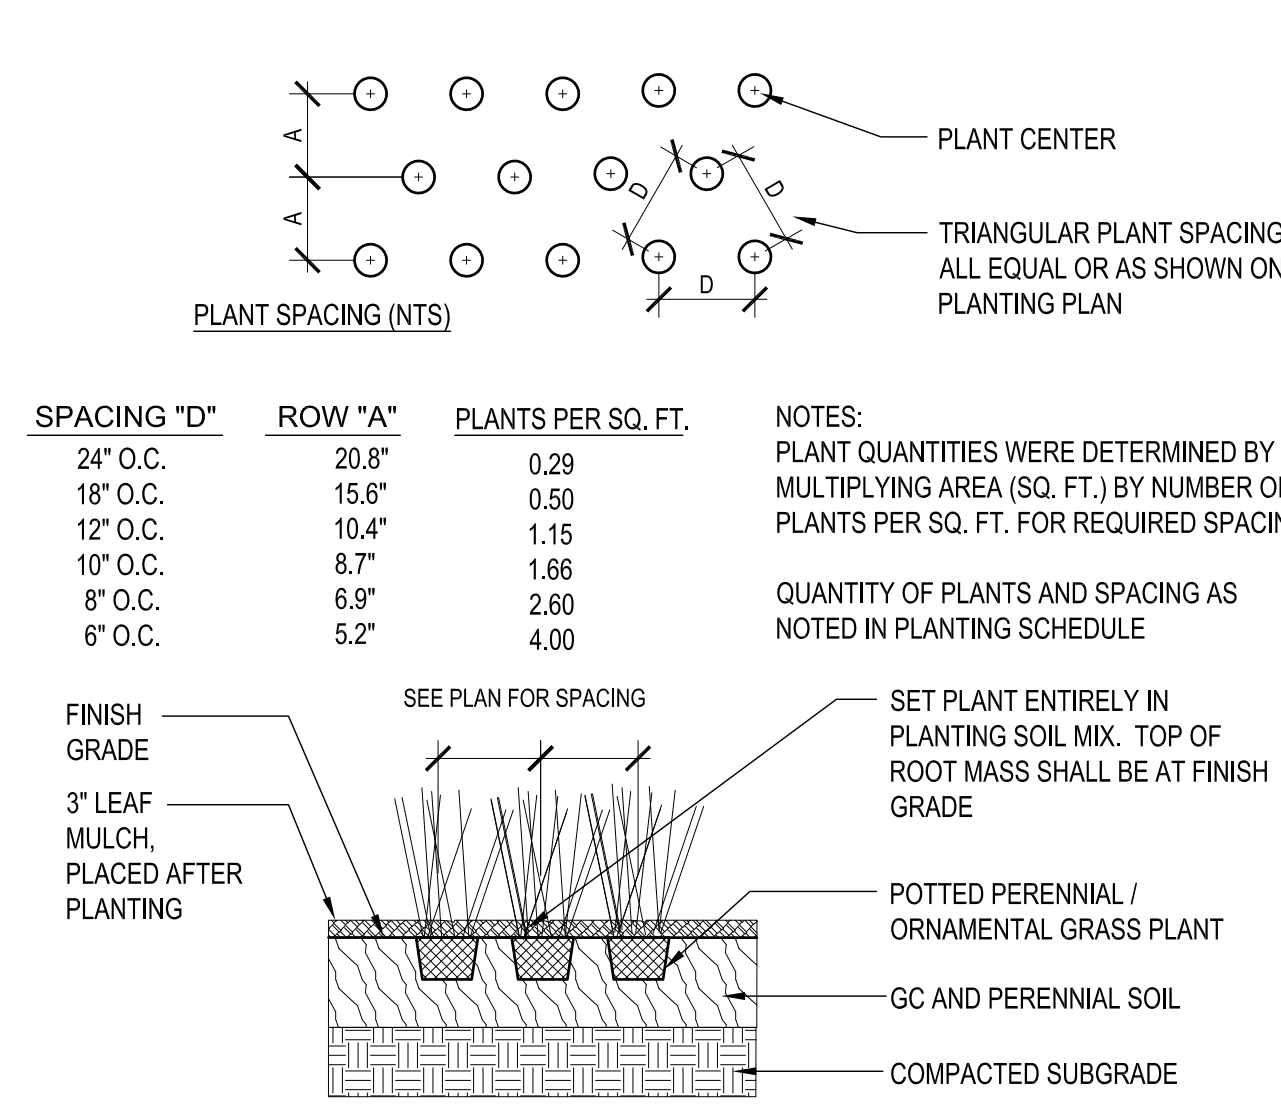


A2 PERENNIAL AND ORNAMENTAL GRASS PLANTING
1/2" = 1'-0"

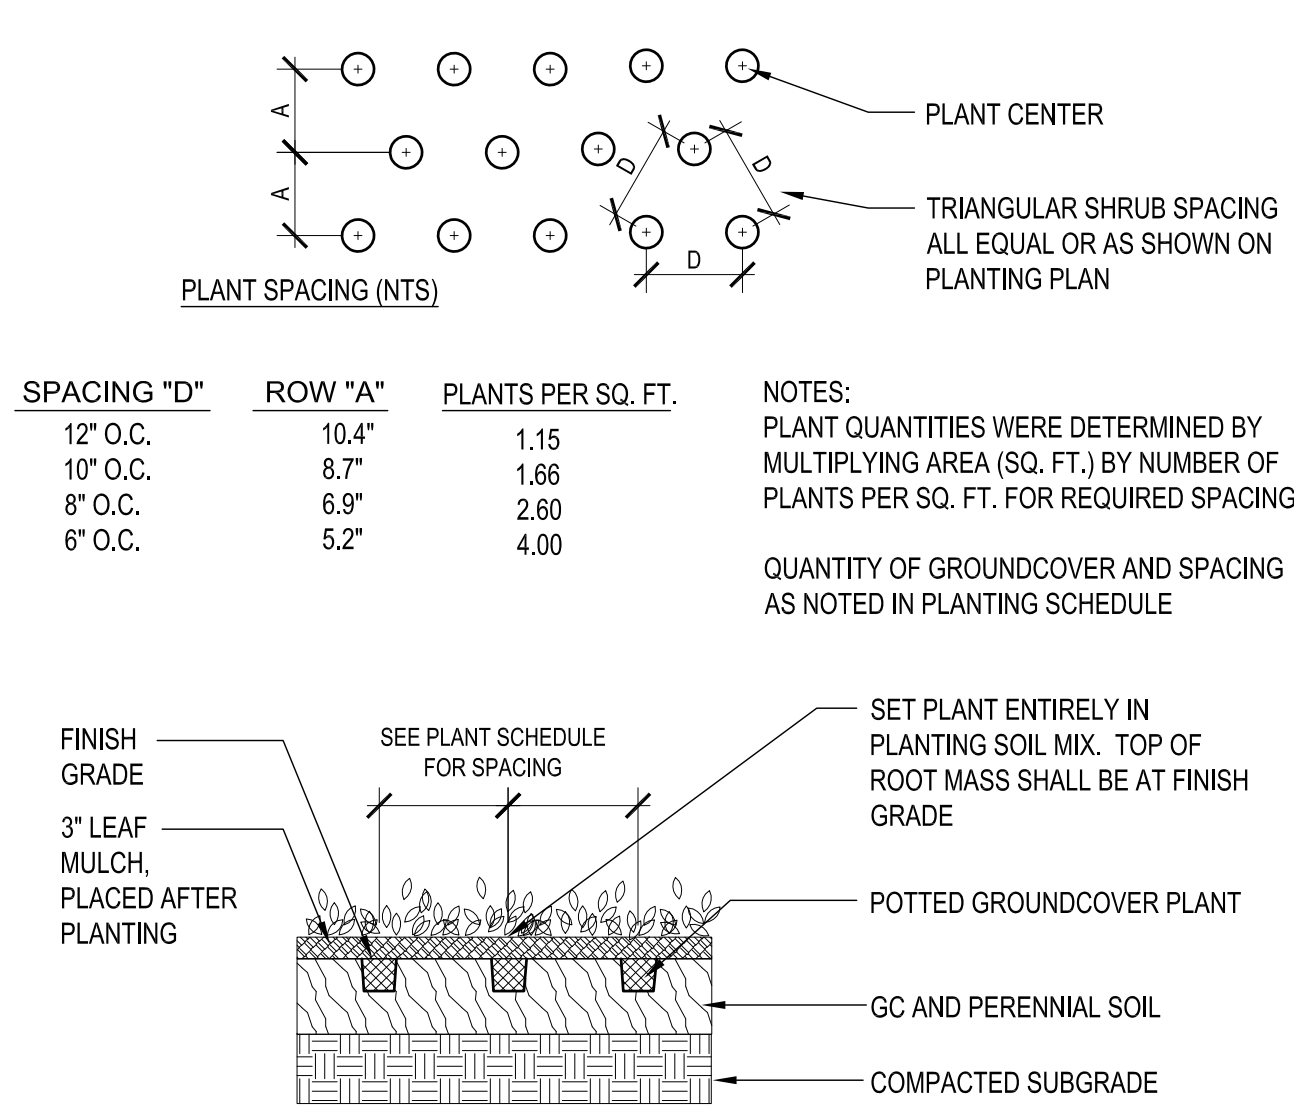

D1 GROUND COVER PLANTING
1/2" = 1'-0"

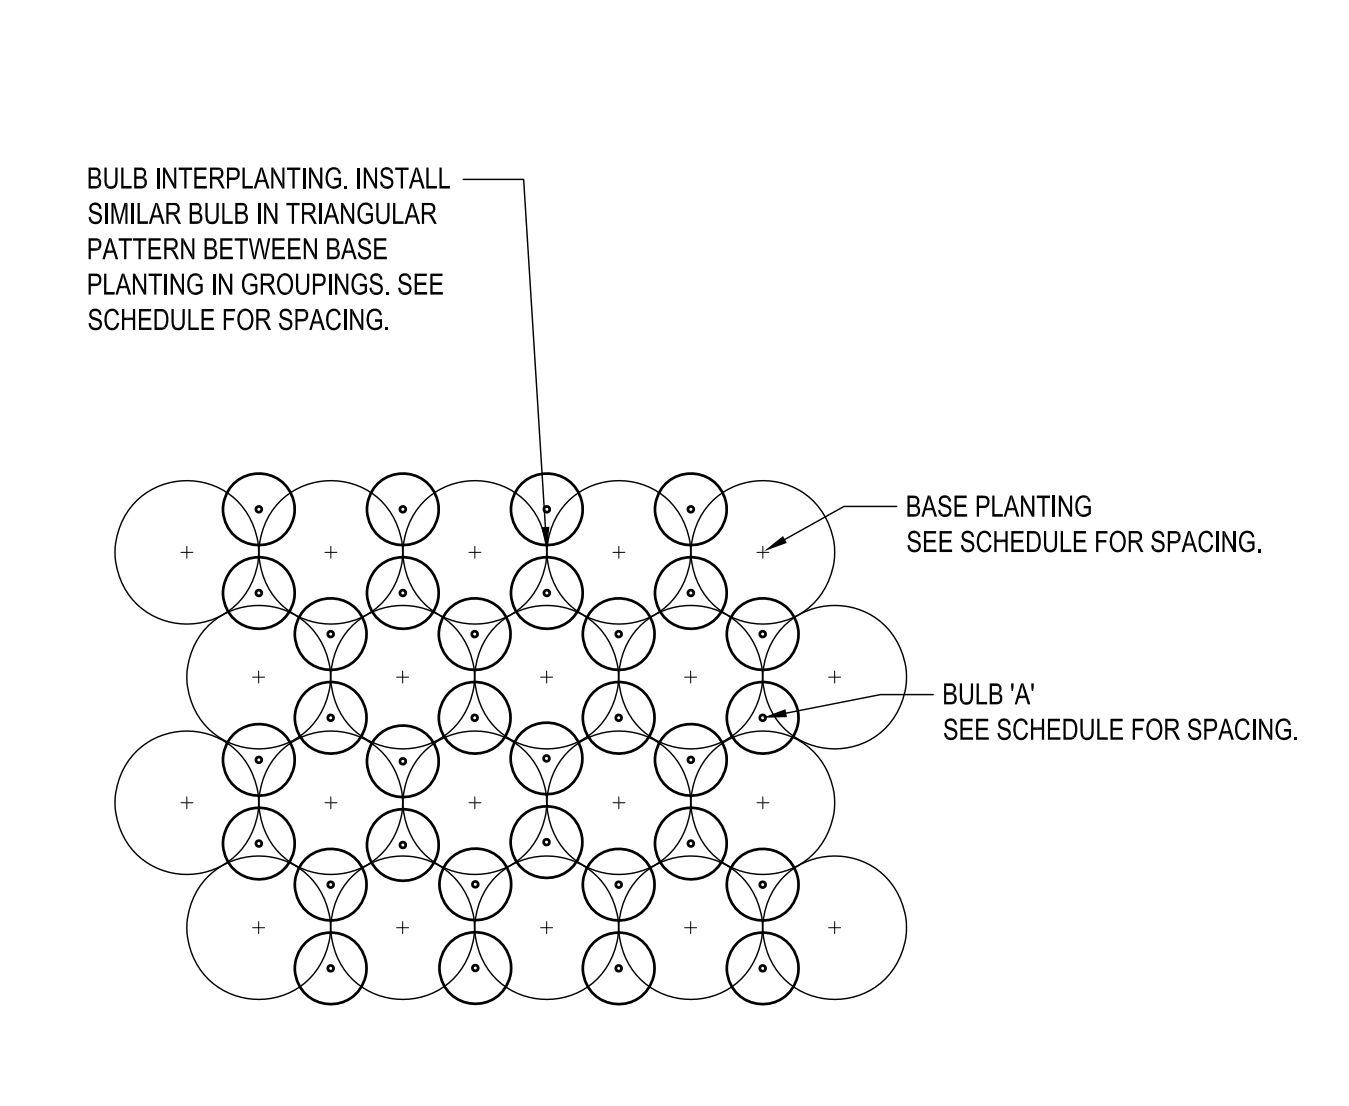

C1 INTERMINGLED PERENNIAL/GRASS & BULB PLANTING
1/2" = 1'-0"

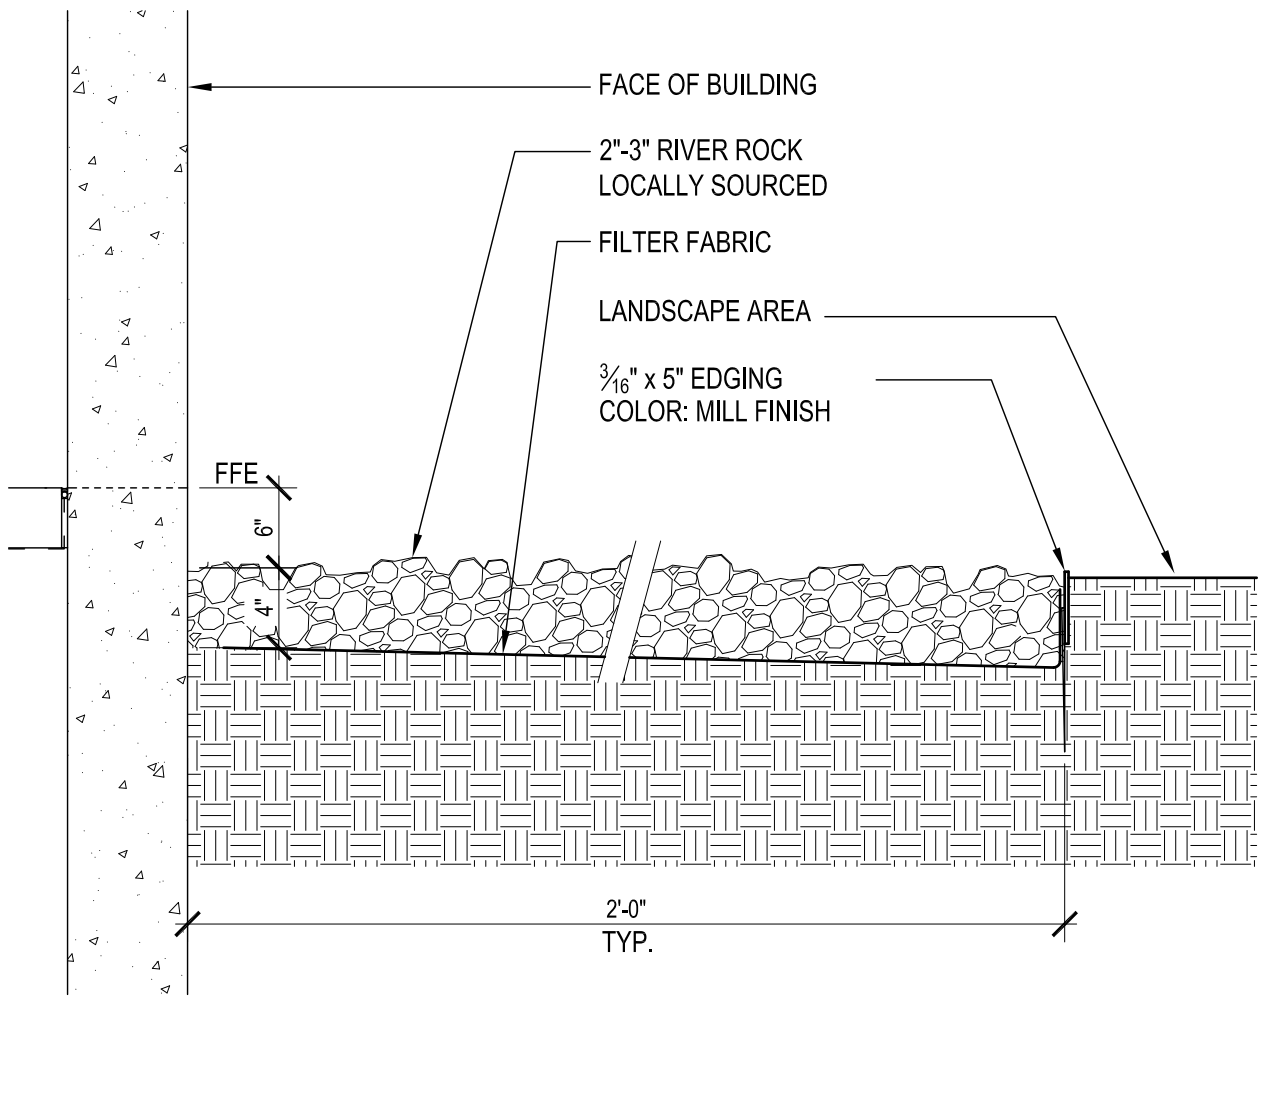

B1 GRAVEL MOW STRIP
3/4" = 1'-0"

PLANTING PLAN NOTES

- ALL PLANTS SHALL BE GUARANTEED FOR ONE FULL YEAR FROM THE SUBSTANTIAL COMPLETION OF THE LANDSCAPE CONTRACT AT FULL REPLACEMENT VALUE INCLUDING LABOR TO REPLACE PLANT MATERIALS.
- ALL PROVIDED PLANT MATERIAL SHALL BE OF SPECIMEN QUALITY AND OF THE SIZE AND TYPE SPECIFIED IN THE PLANT SCHEDULE. CONTRACTOR SHALL NOTIFY THE LANDSCAPE ARCHITECT IN WRITING OF ANY PLANT MATERIALS THAT DO NOT MEET SPECIFICATIONS.
- VERIFY ALL DIMENSIONS AND SITE CONDITIONS PRIOR TO STARTING CONSTRUCTION AND IMMEDIATELY NOTIFY THE LANDSCAPE ARCHITECT OF ANY DISCREPANCIES.
- VERIFY THE LOCATION OF ALL UTILITIES INCLUDING SANITARY AND STORM SEWER + ROOF DRAINS PRIOR TO BEGINNING CONSTRUCTION.
- ALL WORK PERFORMED SHALL BE IN COMPLIANCE WITH THE CONTRACT DOCUMENTS AND WITH ALL APPLICABLE CODES, STANDARDS AND ORDINANCES.
- THE SITE SHALL BE FINISH GRADED BY THE LANDSCAPE CONTRACTOR. THE LANDSCAPE CONTRACTOR SHALL BE RESPONSIBLE TO MAINTAIN FINISHED GRADES AND RE-GRADE ANY AREAS DISTURBED BY LANDSCAPE OPERATIONS.
- ANY CLEAN, EXCESS SOIL FROM LANDSCAPE OPERATIONS SHALL BE WASTED ON SITE AT THE DISCRETION OF THE CONTRACTOR OR DISPOSED OF OFF SITE. ALL CONSTRUCTION DEBRIS FROM LANDSCAPE OPERATIONS SHALL BE DISPOSED OF OFF SITE.
- REFER TO SPECIFICATION FOR SOG TYPE. ALL AREAS INDICATED IN THE PLANS TO BE SOGGED SHALL BE MOWED JUST PRIOR TO INSTALLATION AND SHALL BE GUARANTEED FOR A PERIOD OF ONE MONTH. ALL SOG AREAS ARE TO BE WATERED DAILY FOR ONE WEEK AND EVERY OTHER DAY FOR THE NEXT TWO WEEKS.
- PROVIDE AND INSTALL LOCALLY AVAILABLE LEAF MULCH IN ALL MIXED PLANTING BEDS CONTAINING SHRUBS, AND PERENNIAL/ORNAMENTAL GRASSES.
- PROVIDE TRIPLE GROUND LEAF MULCH AROUND BASE OF ALL TREES, UNLESS PLANTED IN A MIXED PLANTING BED.

APPLICANT INFORMATION

BOB LEIMBERG
CLAYCO
2199 INNERBELT BUSINESS CENTER DR.
ST. LOUIS, MO 63114
314.592.2234 office
314.713.7874 mobile
leimberg@clayco.com

OWNER INFORMATION

ALAN YU
LOLLICUP USA
6185 KIMBALL AVE.
CHINO, CA 91708
626.965.8882 x110 office
626.226.8556 mobile
alan.yu@lollcup.com

PROJECT NAME

LOLLICUP
CASE NUMBER: SP2017-042

DRAWING ISSUE

| DESCRIPTION | DATE |
|--|----------|
| SITE PLAN SUBMITTAL - CITY OF ROCKWALL | 12/15/17 |
| REVISIONS - CITY OF ROCKWALL | 01/03/18 |
| ENGINEERING REVIEW | 03/02/18 |
| ASI 3 | 07/11/18 |
| RECORD DRAWINGS | 03/06/19 |

DRAWING TITLE

LANDSCAPE DETAILS

DRAWING NO.

L07-10

Form # 601-03049 Consult.# 101-03049

CLAYCO
THE ART & SCIENCE OF BUILDING
2199 INNERBELT BUSINESS CENTER DRIVE
ST. LOUIS, MISSOURI 63114
Ph 314.429.5100 Fx 314.429.3137

ARCHITECT
FORUM
2199 INNERBELT BUSINESS CENTER DRIVE
ST. LOUIS, MISSOURI 63114
Ph 314.429.5100 Fx 314.429.7770

CONTRACTOR / DEVELOPER
CLAYCO

LANDSCAPE ARCHITECT
FORUM

CIVIL ENGINEER
FREES & NICHOLS

STRUCTURAL ENGINEER

MECHANICAL ENGINEER

ELECTRICAL ENGINEER

PLUMBING ENGINEER

FIRE PROTECTION ENGINEER

Lollcup
3201 Capital Blvd.
Rockwall, Texas 75032