

Revision	Date	Description
1	07/11/12	REVISIONS PER CITY COMMENTS
2	07/19/12	REVISIONS PER CITY COMMENTS
3	10/30/12	PAVEMENT THICKNESS REVISION
	04/03/12	RECORD DRAWING

Owner:  
**KRT ENTERPRISES, INC.**

P.O. Box 1103 • Rockwall, TX 75087



**Nolan Power Building**  
Rockwall, Texas

~ Civil Engineer ~  
**F.C. CUNY CORPORATION**  
#2 Horizon Court • Heath, Texas 75032 • (469) 402-7700  
Texas Registered Engineering Firm F-7449

Drawn By: F.C. CUNY	Checked By: F.C. CUNY
Date: 05/12	Project No.: -

Sheet Title:  
**Storm Sewer Profiles**

Scale: 1" = 40'	Sheet No.: 6a of 7
--------------------	-----------------------

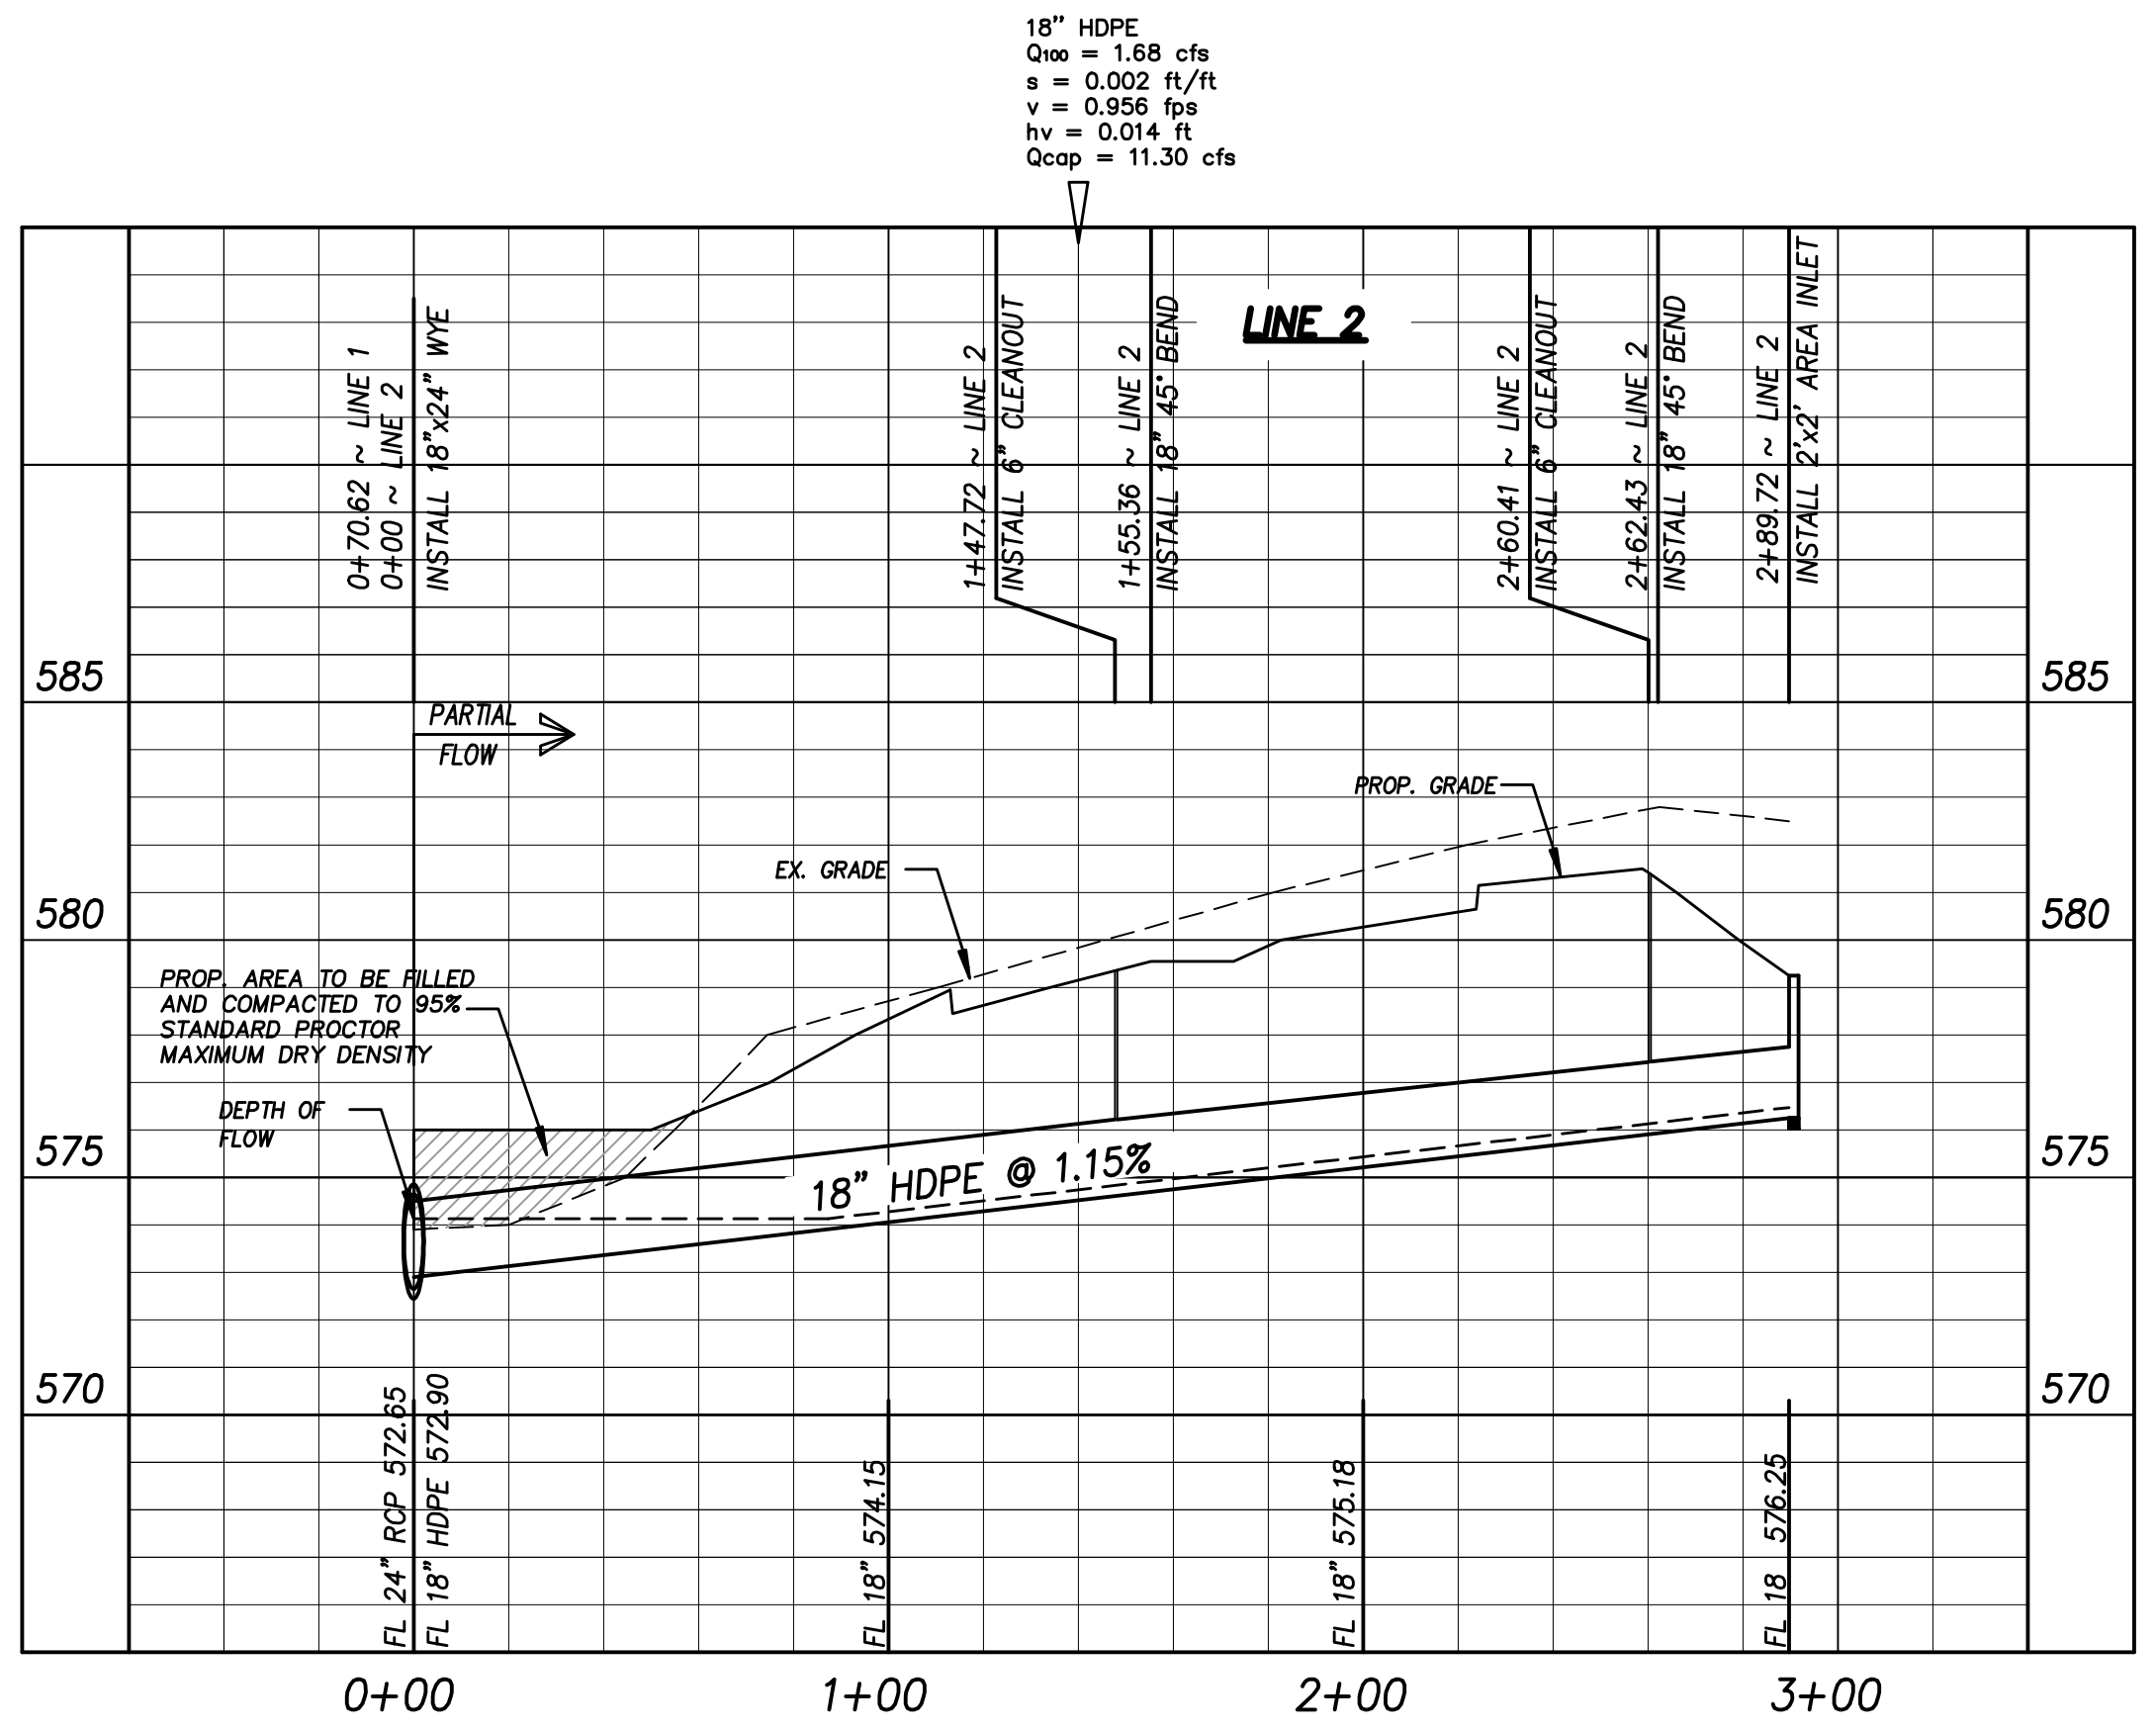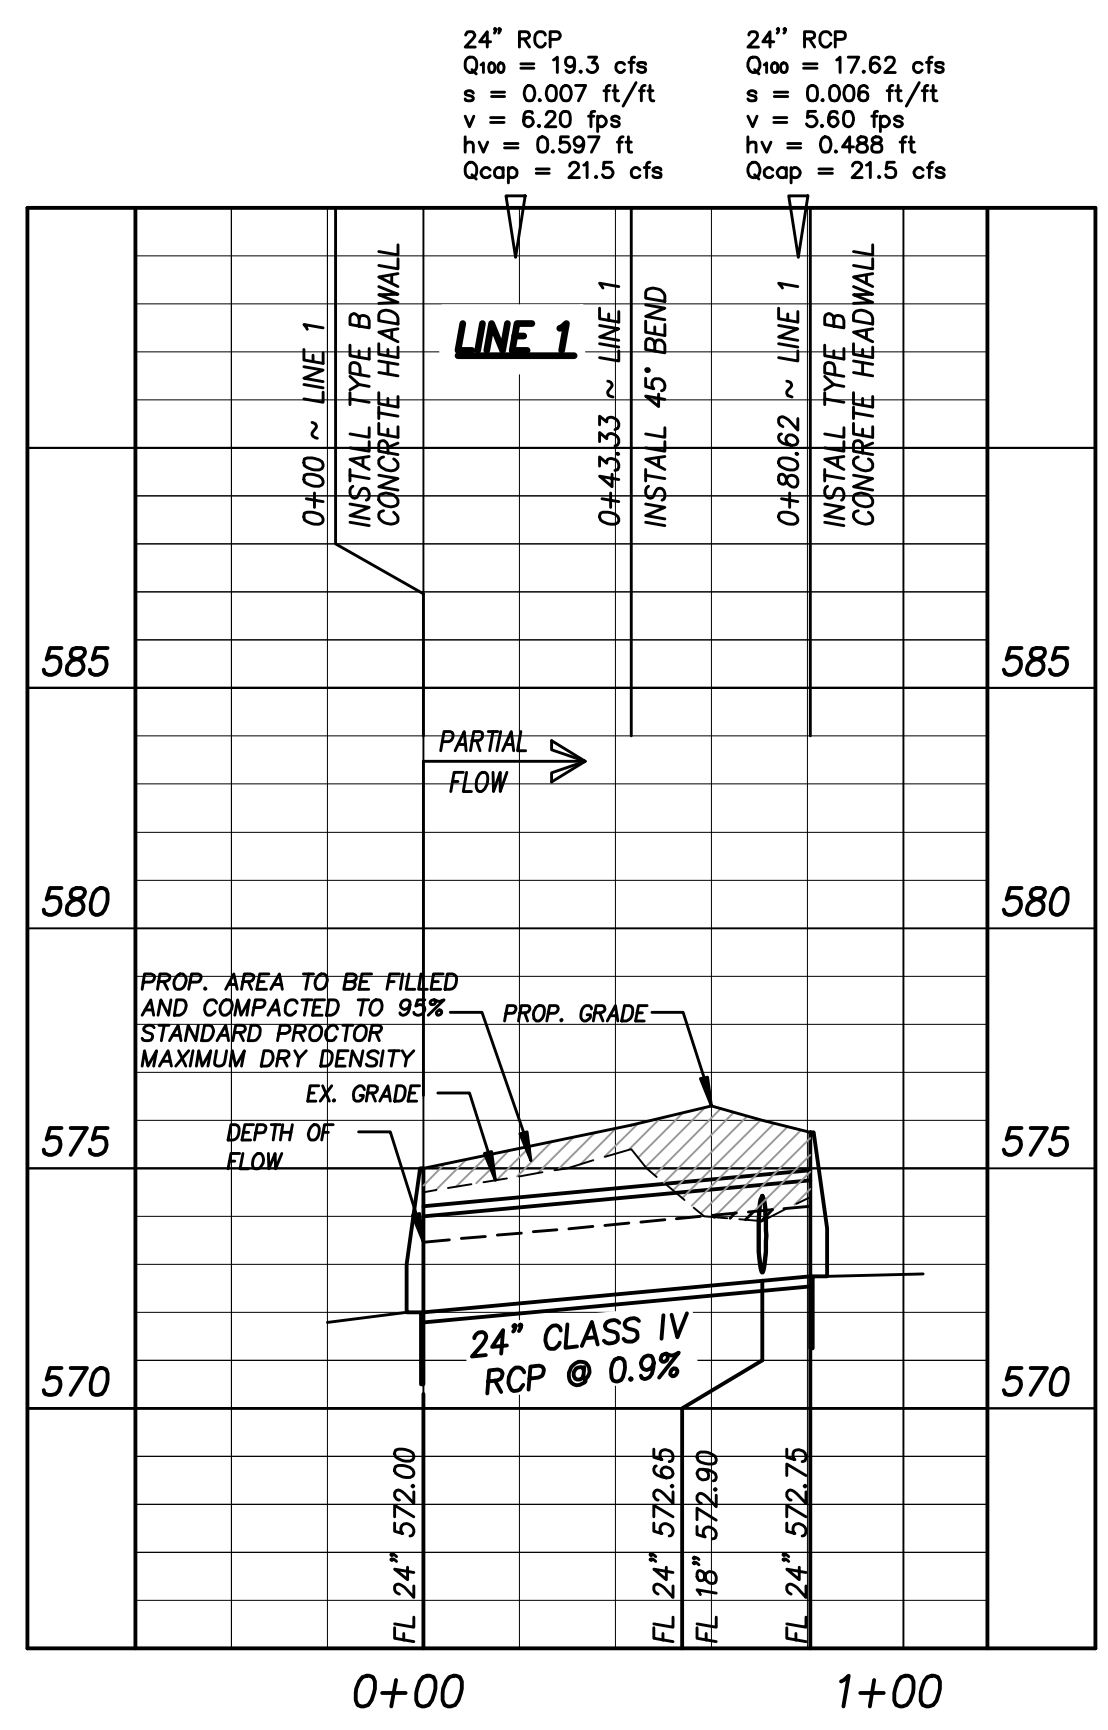

**STORM SEWER PROFILES** SCALE: H: 1"=40'  
V: 1"=4'