

CAUTION EXISTING UTILITIES !!!
 CALL TEXAS 811!!! EXISTING UTILITIES AND UNDERGROUND FACILITIES INDICATED ON THESE PLANS HAVE BEEN LOCATED FROM REFERENCE INFORMATION. IT SHALL BE THE RESPONSIBILITY OF THE CONTRACTOR TO VERIFY BOTH HORIZONTALLY AND VERTICALLY THE LOCATION OF ALL EXISTING UTILITIES AND UNDERGROUND FACILITIES PRIOR TO CONSTRUCTION. TO TAKE THE NECESSARY PRECAUTIONS IN ORDER TO PROTECT ALL FACILITIES ENCOUNTERED, THE CONTRACTOR SHALL PRESERVE AND PROTECT ALL EXISTING UTILITIES FROM DAMAGE DURING CONSTRUCTION.


LEGEND

---	---	PROPERTY LINE
W	W	EXISTING WATER LINE
SS	SS	EXISTING SANITARY SEWER LINE
W	W	PROPOSED WATER LINE
SS	SS	PROPOSED SANITARY SEWER LINE
GAS	GAS	PROPOSED GAS LINE
TELE	TELE	PROPOSED TELEPHONE SERVICE
ELEC	ELEC	PROPOSED ELECTRIC SERVICE

FRANCHISE UTILITY CONTACTS

ELECTRIC: CONTACT: PHONE:	ONCOR ELECTRIC RANDY VOIGHT (972) 551-7233
GAS: CONTACT: PHONE:	ATMOS ENERGY DINAH WOOD (972) 485-6277
TELEPHONE: CONTACT: PHONE:	AT&T BRIAN DUNCAN (903) 457-2303

NOTES:
 - CONTRACTOR TO INSTALL GREEN EMS DISKS ON THE SEWER LINE AT EVERY MANHOLE, CLEANOUT AND SERVICE ON PUBLIC LINE.
 - WATER LINE SERVICE PAST CITY METER WILL NEED TO BE INSTALLED BY REGISTERED PLUMBER.

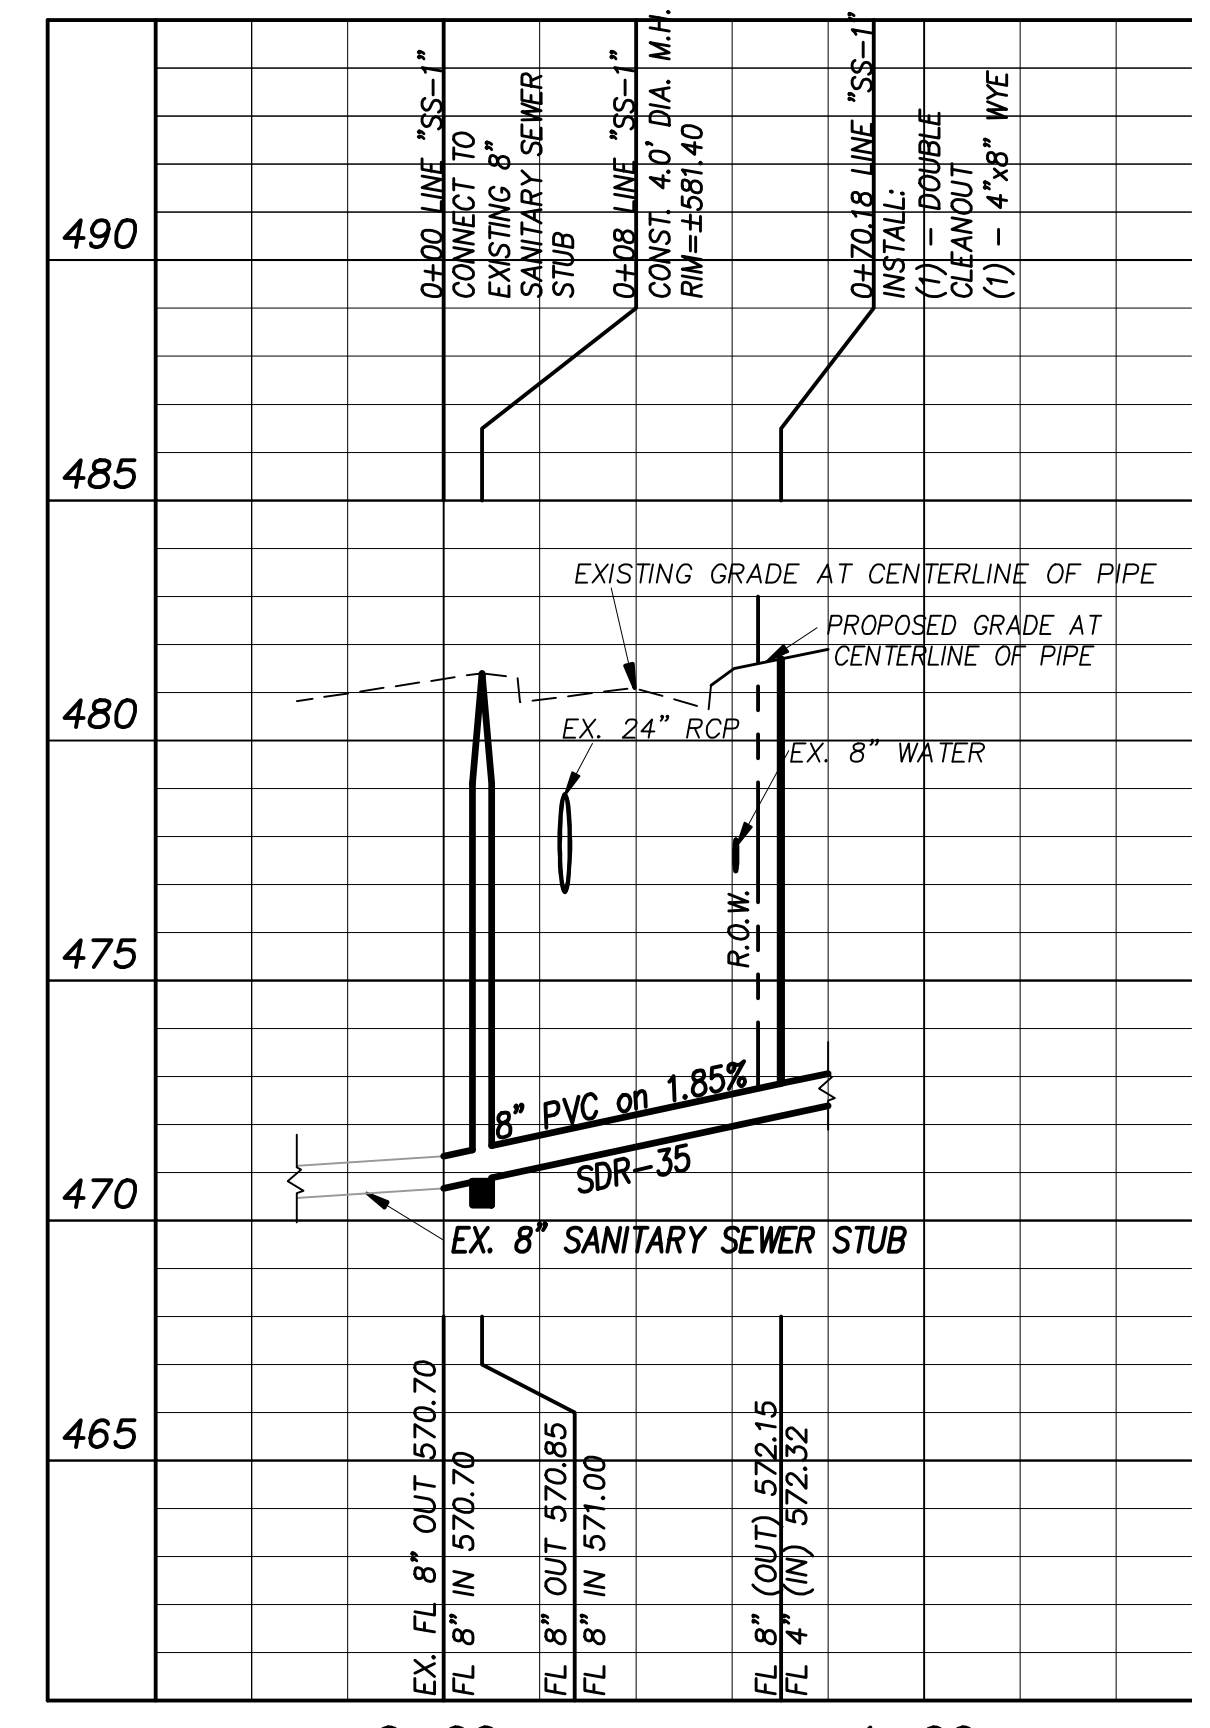

PROPOSED 8" SANITARY SEWER PROFILE SCALE: H: 1"=40' V: 1"=4'

Benchmark Note
 Benchmark: An "X" found in the centerline intersection of Observation Trail and Technology Trail. Elevation=580.50

Revision	Date	Description
1	07/11/12	REVISIONS PER CITY COMMENTS
2	07/19/12	REVISIONS PER CITY COMMENTS
3	10/30/12	PAVEMENT THICKNESS REVISION
	04/03/12	RECORD DRAWING

Owner:
KRT ENTERPRISES, INC.
 P.O. Box 1103 • Rockwall, TX 75087

Nolan Power Building
 Rockwall, Texas

~ Civil Engineer ~
F.C. CUNY CORPORATION
 #2 Horizon Court • Heath, Texas 75032 • (469) 402-7700
 Texas Registered Engineering Firm F-7449

05/02/2013

 Drawn By: F.C. CUNY
 Checked By: F.C. CUNY
 Date: 05/12
 Project No.: -
 Sheet Title: **Utility Plan**

Scale: 1"=20' Sheet No.: 7 of 7

This drawing is proprietary and may not be copied or used in any way without the written permission of FC Cuny Corporation - ©Copyright - FC Cuny Corporation

RECORD DRAWING