

CITY OF ROCKWALL, TEXAS

CONSTRUCTION PLANS

FOR

PAVING, DRAINAGE, WATER, & SEWER IMPROVEMENTS

TO SERVE

PRECISION SHEET METAL

KEN JONES - MAYOR

COUNCIL MEMBERS:

JON KING - Mayor Pro Tem

BILLY MORRIS


TERRY RAULSTON

RON COLESON

BILL CECIL

BOB COTTI

JULIE COUCH - City Manager

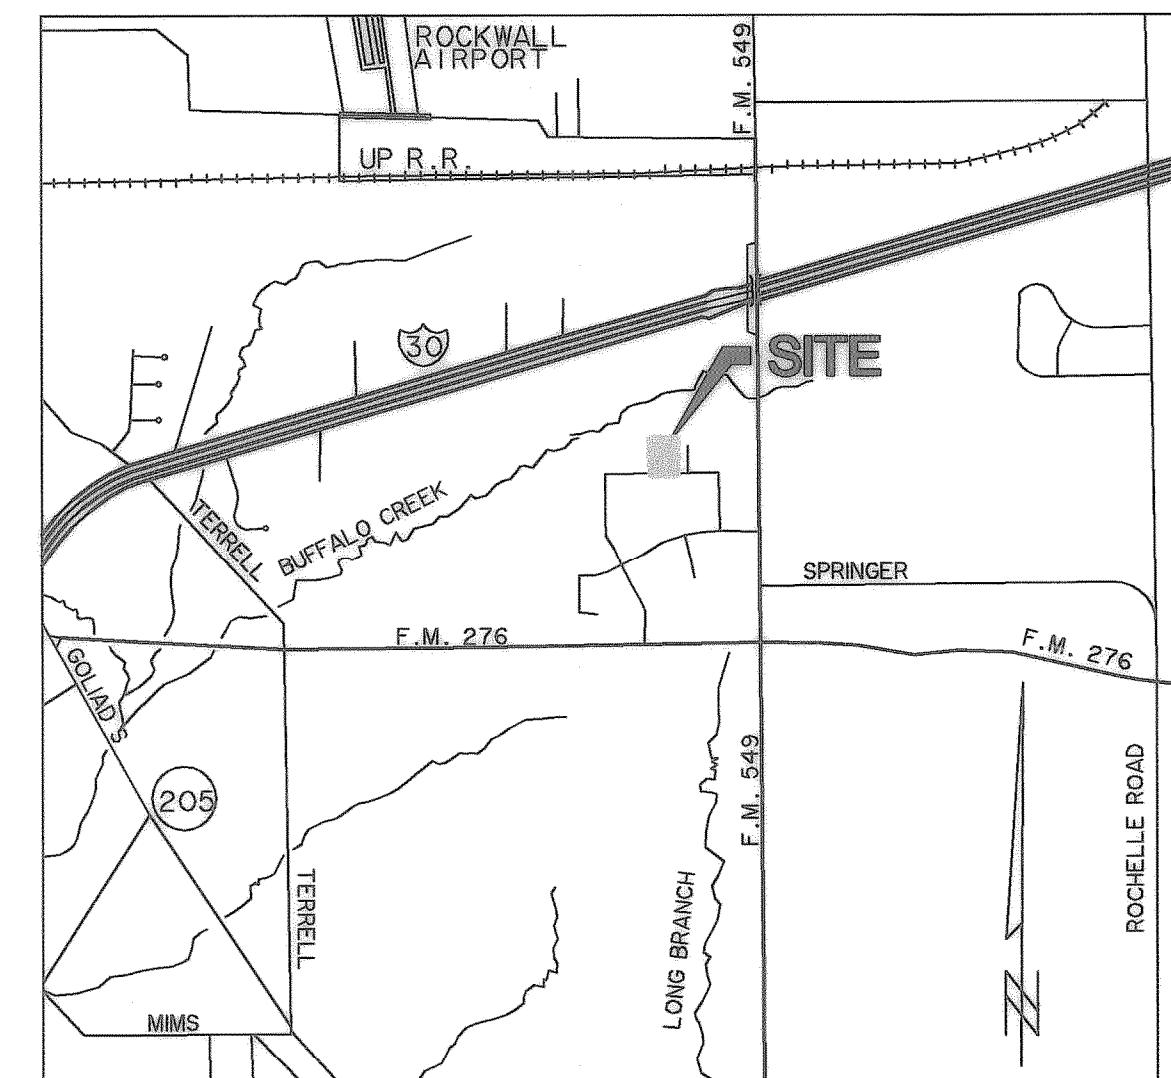


VICINITY MAP

N.T.S.

INDEX OF DRAWINGS

1. COVER SHEET
2. GENERAL NOTES
3. FINAL PLAT
4. PAVING DETAILS AND CURB DETAILS
5. PAVING AND DIMENSIONAL CONTROL PLAN
6. GRADING PLAN
7. DRAINAGE AREA MAP AND STORM DRAIN PLAN
8. UTILITY PLAN
9. EROSION CONTROL DETAILS

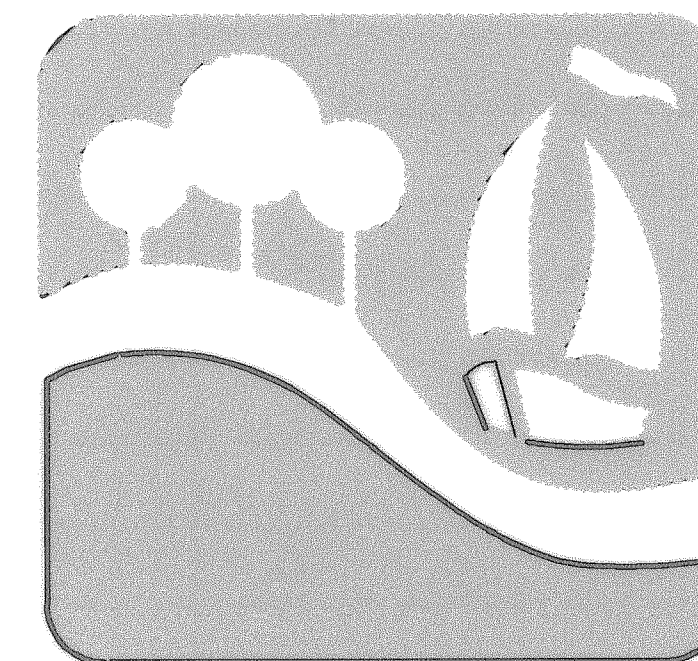

"THE NEW HORIZON"



Ronald Ramirez
12/19/02

RECORD
DRAWING
DECEMBER 6, 2002

DECEMBER, 2002