

DESIGN CONTROL POINT TABLE


POINT #	NORTHING	EASTING	DESCRIPTION
1210	7021397.0846	2606115.4779	90° BEND
1211	7021396.2771	2606057.5494	90° BEND
1212	7021524.1618	2606055.7762	8" x 6" TEE
1213	7021524.5220	2606081.7567	F.H.
1214	7021590.8005	2606054.8522	90° BEND
1215	7021588.8449	2605914.7551	8" x 6" TEE
1216	7021632.0842	2605914.1516	F.H.
1217	7021587.2902	2605803.3767	90° BEND
1218	7021555.2921	2605803.8204	8" x 6" TEE
1219	7021555.0218	2605784.3223	F.H.
12120	7021388.0775	2605932.0840	F.H.

CAUTION !!!
UNDERGROUND UTILITIES

EXISTING UTILITIES AND UNDERGROUND FACILITIES INDICATED ON THESE PLANS HAVE BEEN LOCATED FROM REFERENCE INFORMATION SUPPLIED BY VARIOUS OWNERS OF THE FACILITIES. THE ENGINEER DOES NOT ACCEPT THE RESPONSIBILITY FOR THE UTILITY LOCATIONS SHOWN. IT SHALL BE THE RESPONSIBILITY OF THE CONTRACTOR TO VERIFY BOTH HORIZONTALLY AND VERTICALLY THE LOCATION OF ALL EXISTING UTILITIES AND UNDERGROUND FACILITIES PRIOR TO CONSTRUCTION, TO TAKE NECESSARY PRECAUTIONS IN ORDER TO PROTECT ALL FACILITIES ENCOUNTERED, AND TO NOTIFY THE ENGINEER PROMPTLY OF ALL CONFLICTS OF THE WORK WITH EXISTING FACILITIES. THE CONTRACTOR SHALL PRESERVE AND PROTECT ALL EXISTING UTILITIES FROM DAMAGE DURING CONSTRUCTION. ANY DAMAGE BY THE CONTRACTOR TO EXISTING UTILITIES SHALL BE REPAIRED BY THE CONTRACTOR AT HIS EXPENSE. CONTACT ALL POSSIBLE UTILITY AND UNDERGROUND FACILITY OWNERS.

*** LEGEND ***

	EXISTING WATER LINE		PROPOSED FIRE HYDRANT
	EXISTING WATER VALVE		PROPOSED WATER METER
	EXISTING WATER METER BOX		PROPOSED WATER VALVE
	EXISTING FIRE HYDRANT		PROPOSED WATER
	EXISTING LIGHT POLE		PROPOSED SEWER
	EXISTING POWER POLE		PROPOSED TELEPHONE
	EXIST. SANITARY SEWER MANHOLE		PROPOSED ELECTRIC
	EXISTING SANITARY SEWER		
	CONCRETE STORM DRAIN PIPE		
	EXISTING UNDERGROUND TELEPHONE		

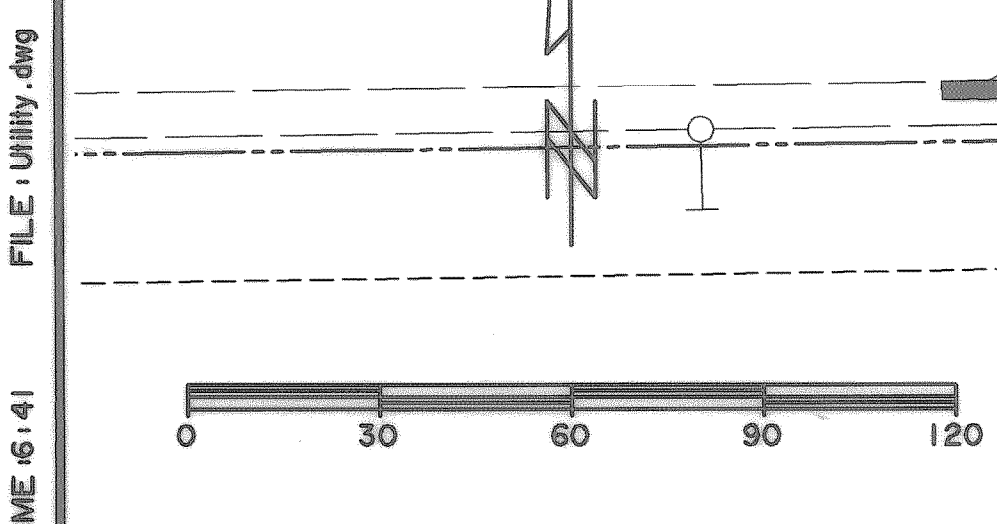

FILE: Utility.dwg

RECORD DRAWING
 DECEMBER 6, 2002

WIER & ASSOCIATES, INC.
 ENGINEERS SURVEYORS LAND PLANNERS
 4300 BELTWAY PLACE SUITE 130 ARLINGTON, TEXAS 76010 METRO (817) 467-7700
 6721 5th STREET FRESNO, TEXAS METRO (214) 387-8000
 www.wierassociates.com

PRECISION SHEET METAL
UTILITY PLAN

COPYRIGHT ©
 WIER & ASSOCIATES, INC.
 LAST SHEET EDIT
 DATE 12-07-2002
 WA# 02032
SHEET NO.
 8