



# DIMENSION PLAN

LOT 3

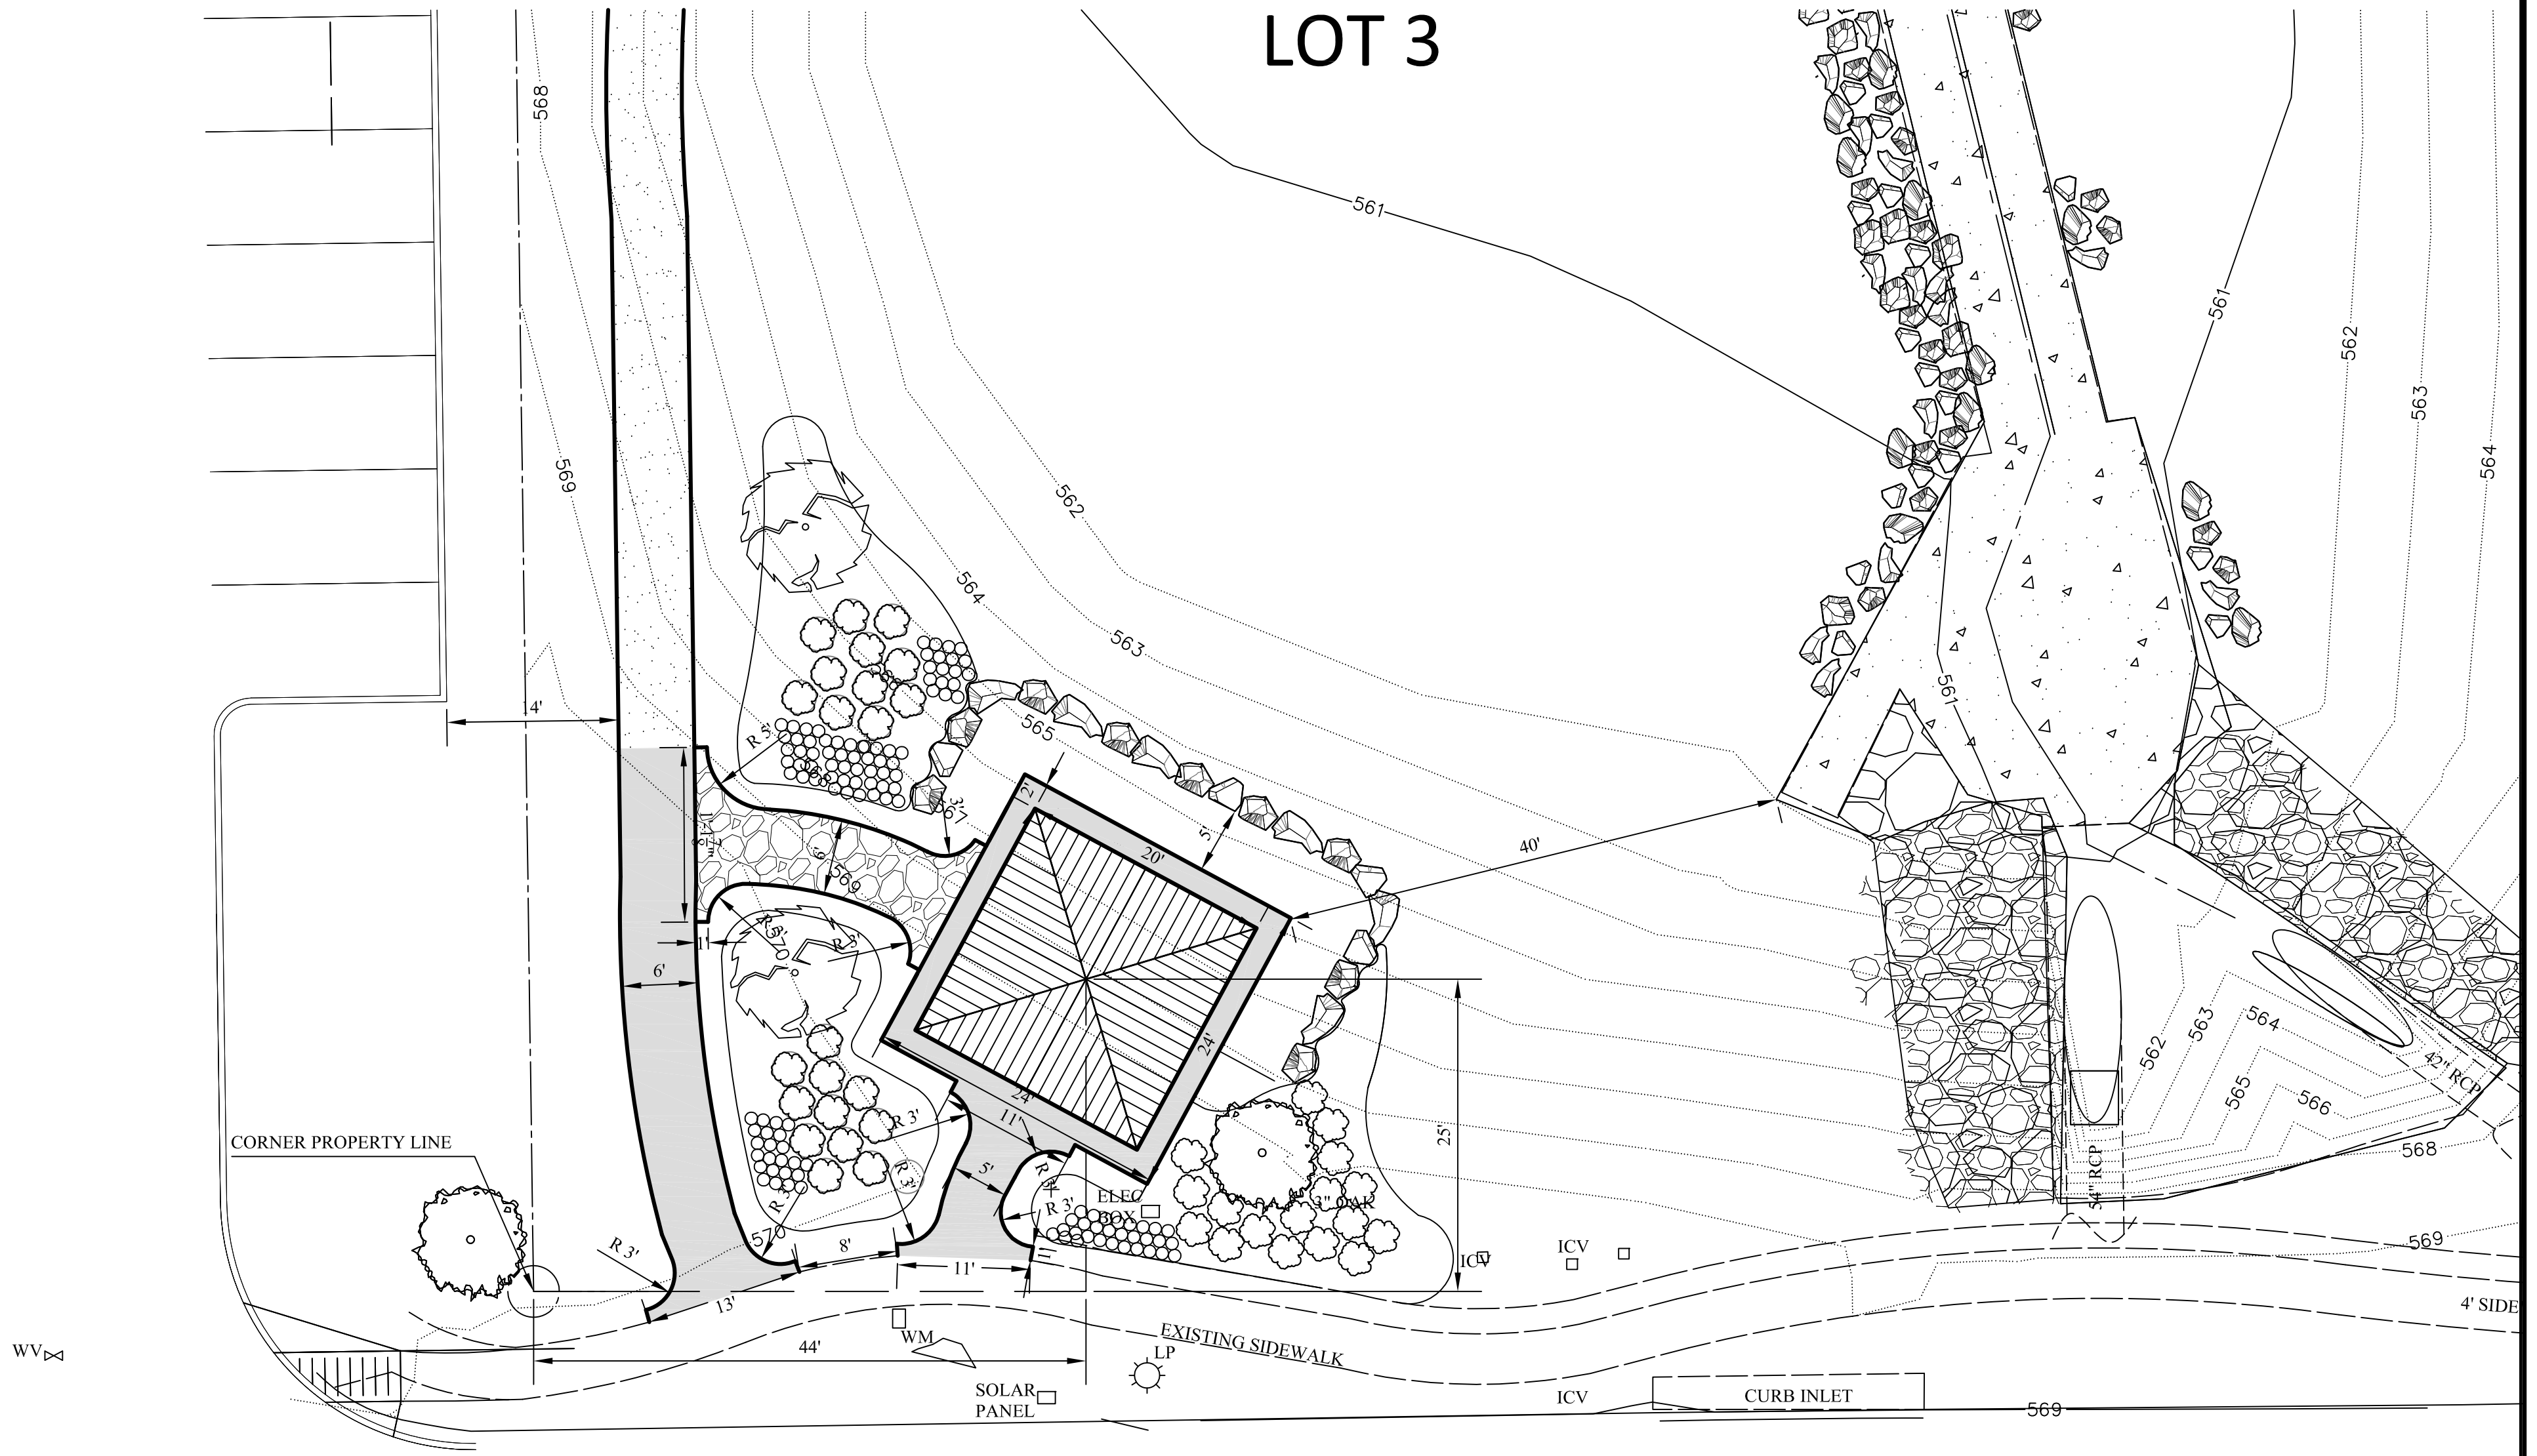


OBSERVATION

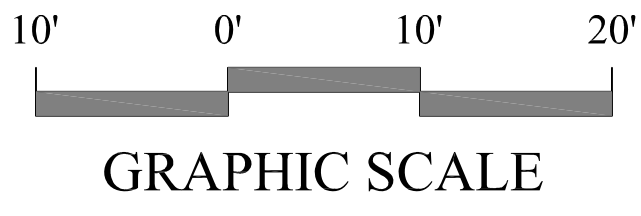


# GRADING PLAN

LOT 3

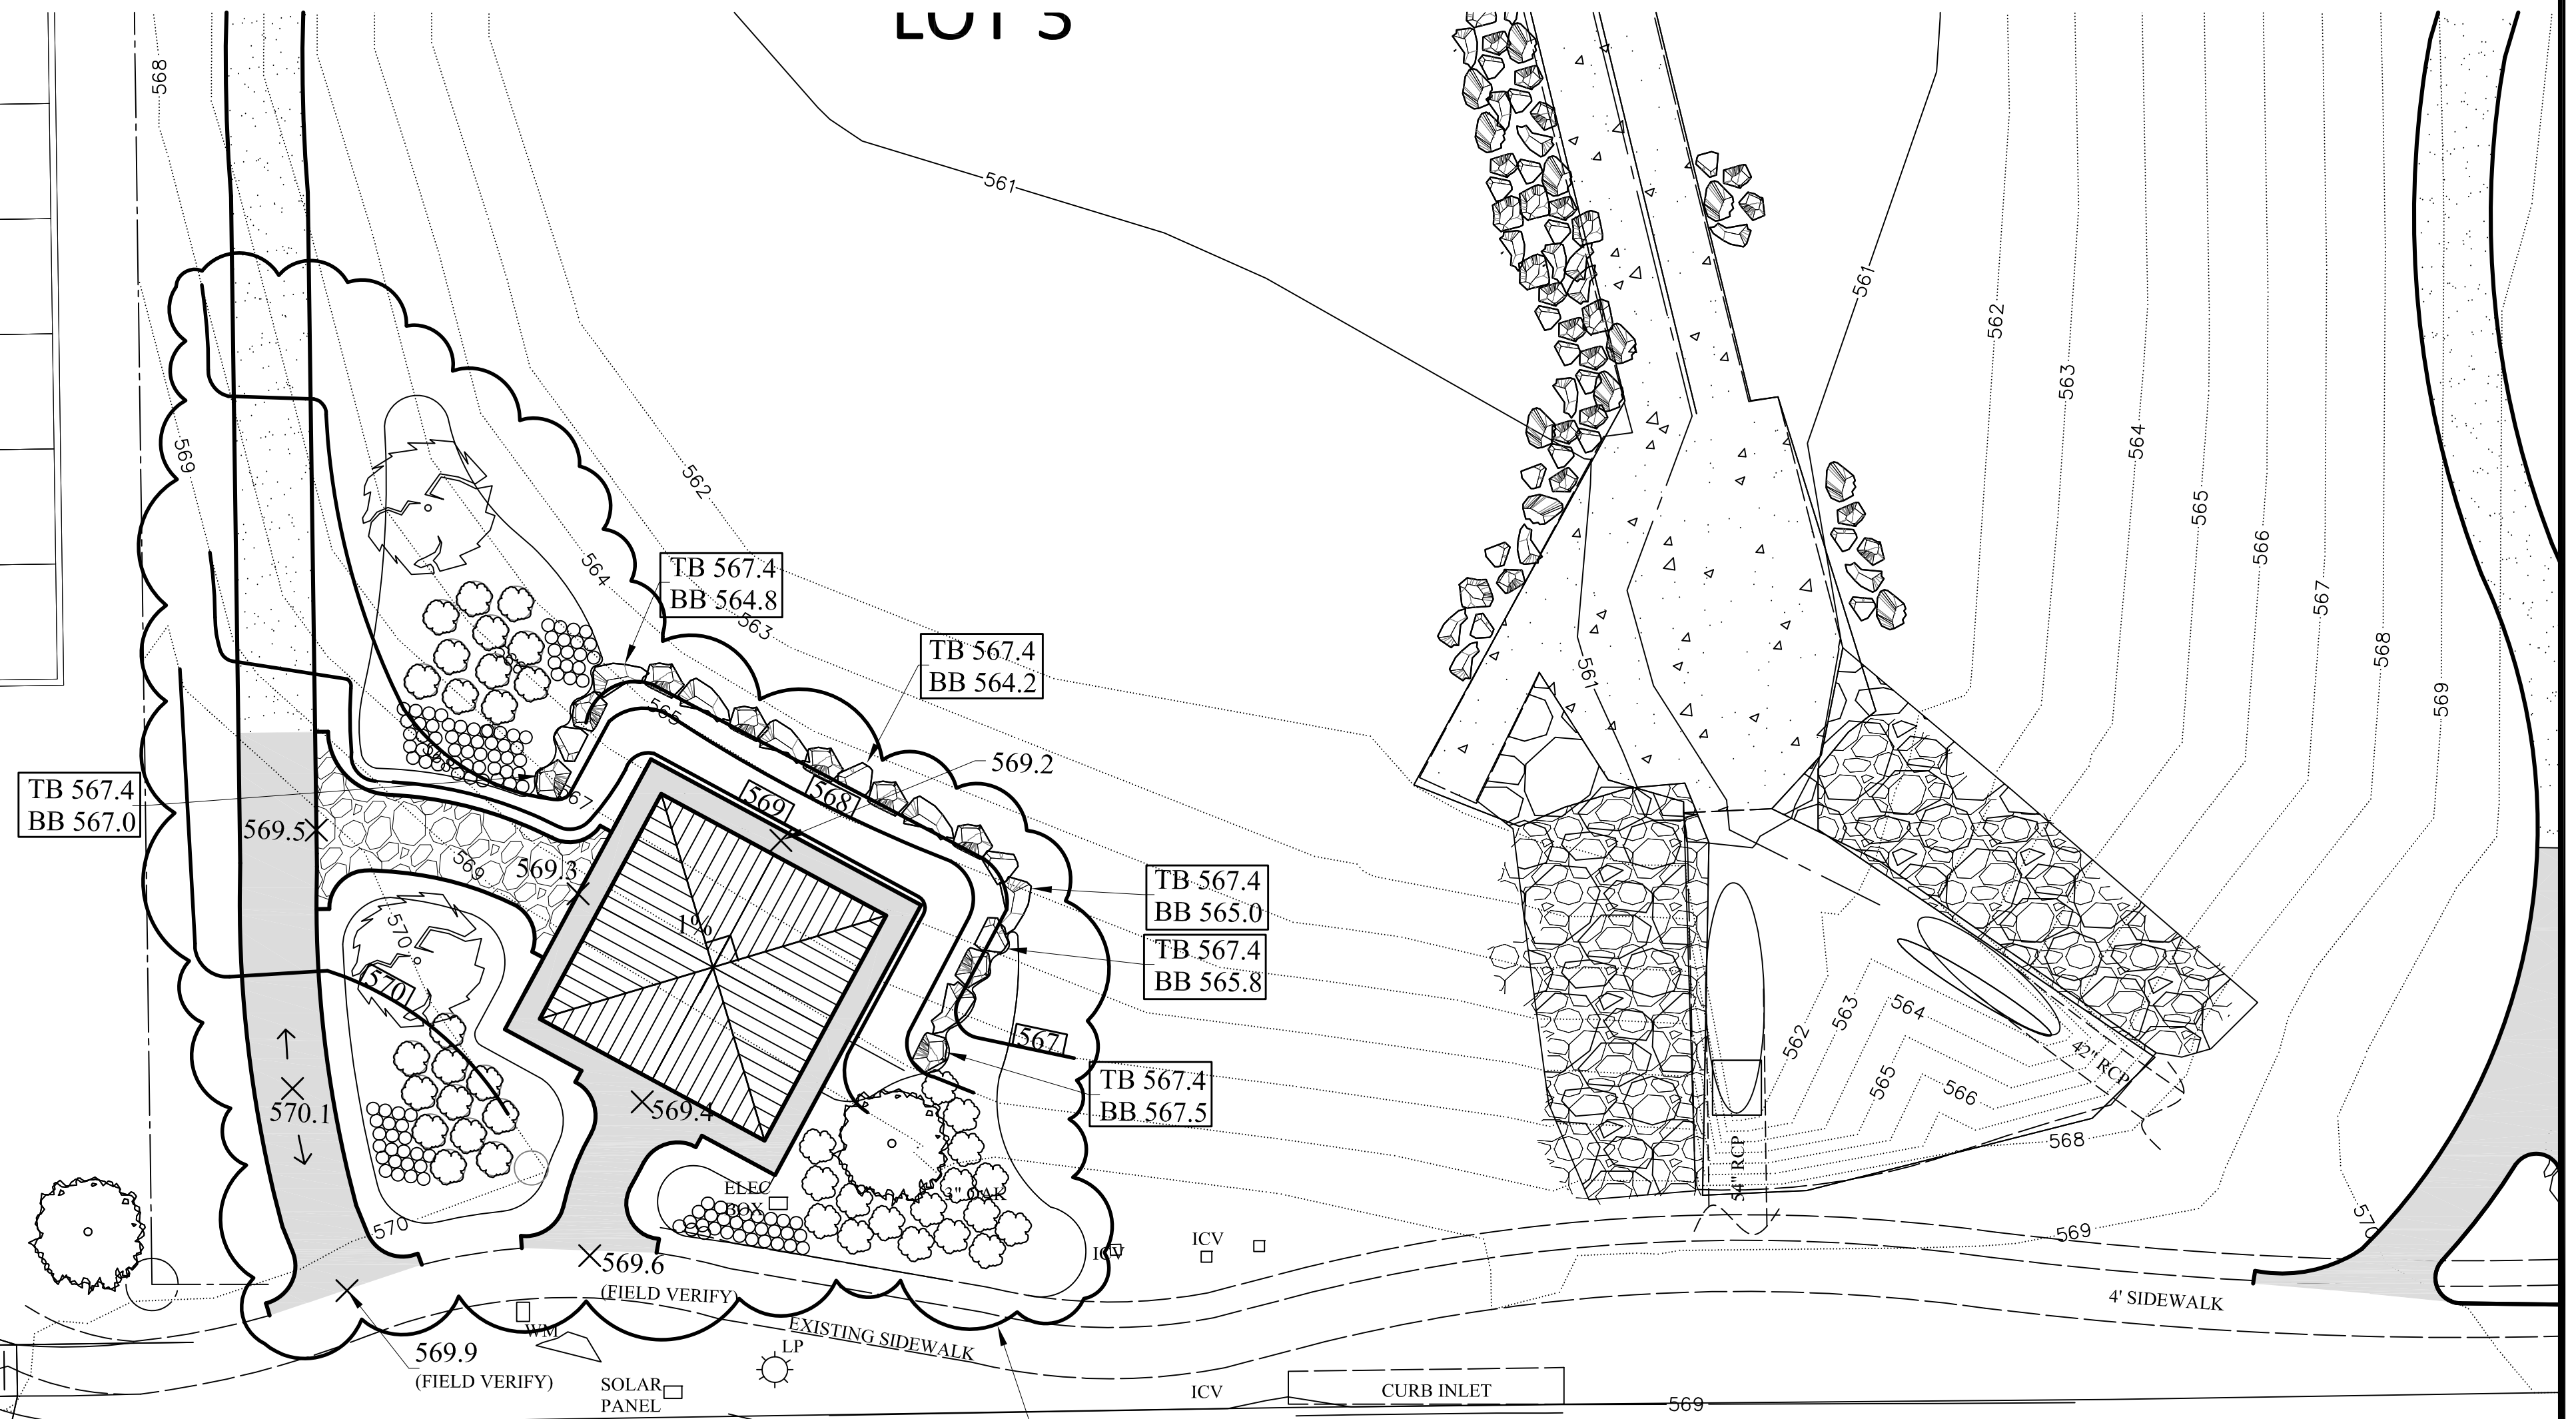

OBSERVATION

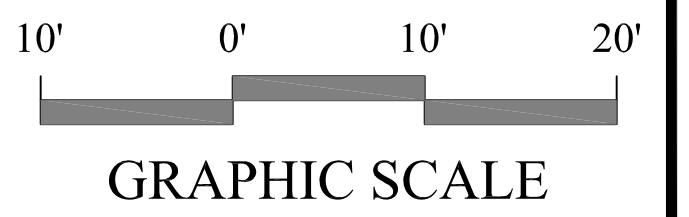

GRADING & DIMENSION PLAN  
ROCKWALL TECHNOLOGY PARK  
ROCKWALL EDC, ROCKWALL, TEXAS

**MHS**  
PLANNING & DESIGN, LLC

212 W. Ninth Street  
Tyler, Texas 75701  
903-597-6606  
903-597-0517 Fax