


CONSTRUCTION PLANS FOR **ROCKWALL REGIONAL DETENTION POND** **LOT 1, BLOCK B** **ROCKWALL TECHNOLOGY PARK PHASE IV**

8.761 ACRES
CITY OF ROCKWALL, ROCKWALL COUNTY, TEXAS
AUGUST 2016

OWNER
ROCKWALL ECONOMIC DEVELOPMENT CORPORATION
2610 OBSERVATION TRAIL
ROCKWALL, TEXAS 75032
CONTACT: MICHAEL HAMPTON
PHONE: 972-772-0025

PREPARED BY
Pacheco Koch
7557 RAMBLER ROAD SUITE 1400 T: 972.235.3031
DALLAS, TX 75231 F: 972.235.9544
TX REG. ENGINEERING FIRM F-14439
TX REG. SURVEYING FIRM LS-10193805

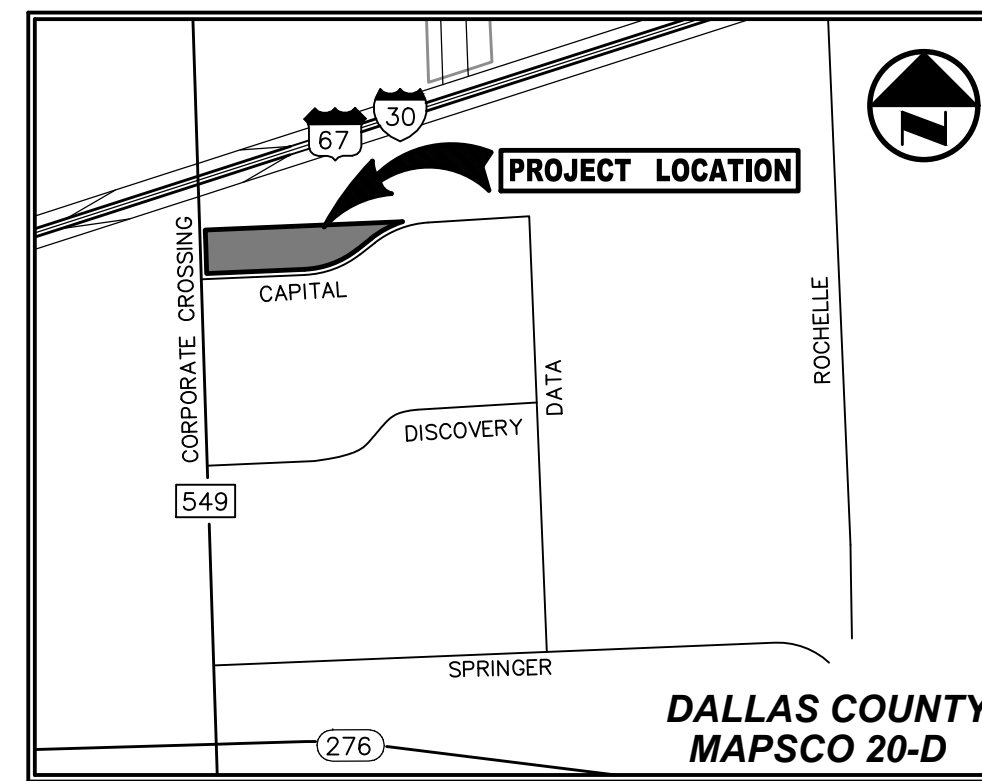

VICINITY MAP
(NOT TO SCALE)

RECORD DRAWING

THE SIGNED AND SEALED CONSTRUCTION DOCUMENT HAS BEEN REVISED TO REFLECT CONSTRUCTION RECORDS MAINTAINED AND PROVIDED BY THE CONTRACTOR FOR THIS PROJECT. THE INFORMATION SHOWN ON THIS RECORD DRAWING, WHICH WAS PROVIDED BY THE CONTRACTOR, OR OTHERS NOT ASSOCIATED WITH THE DESIGN ENGINEER, CANNOT BE VERIFIED FOR ACCURACY OR COMPLETENESS. PACHECO KOCH SHALL ASSUME NO LIABILITY FOR ANY CHANGES MADE DURING CONSTRUCTION THAT WERE NOT SPECIFICALLY APPROVED BY THE ENGINEER PRIOR TO CONSTRUCTION. THE SEALED CONSTRUCTION DRAWINGS ARE ON FILE AT THE OFFICES OF PACHECO KOCH.

ATTESTED BY: *Chet Leubers*
SIGNATURE: _____
ENGINEER OF RECORD: CHET LEBERS, P.E.
CONTRACTOR: R.A. RAMOS GENERAL CONTRACTORS, INC.
DATE REVISED: 09/18/2017

Sheet List Table

Sheet Number	Sheet Title
C0.0	COVER SHEET
FP	FINAL PLAT (2 SHEETS)
C1.1	DIMENSIONAL CONTROL PLAN
C2.1	GRADING PLAN
C3.1	DRAINAGE AREA MAP
C3.2	DETENTION CALCULATIONS
C3.3	DETENTION CALCULATIONS
C4.1	STORM SEWER PLAN
C4.2	STORM SEWER PLAN
C4.3	STORM SEWER PROFILE
C5.1	WATER PLAN
C6.1	PAVING PLAN & DETAILS
C7.1	EROSION CONTROL PLAN
C7.2	EROSION CONTROL DETAILS
C8.1	TxDOT DETAIL PW
C8.2	TxDOT DETAIL SET B-PD
C8.3	TxDOT DETAIL SET B-PD
C8.4	TxDOT DETAIL GF(31)-14