

CITY OF ROCKWALL


CIVIL CONSTRUCTION PLANS FOR

OFFICE/WAREHOUSE BUILDING

PHASE II

FOR

ROCKWALL ECONOMIC DEVELOPMENT CORPORATION

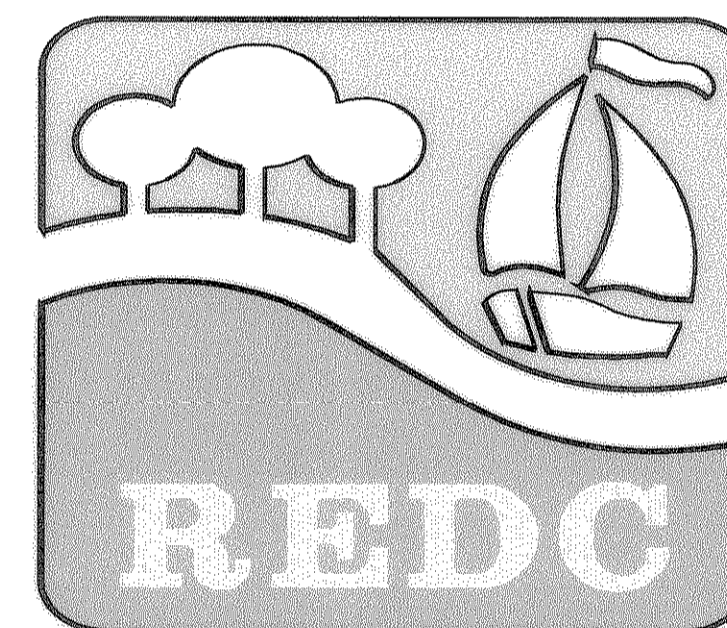

MAYOR
SCOTT SELF

CITY COUNCIL
 BILL CECIL SAM BUFFINGTON TERRY RAULSTON
 RON COLESON JOHN B. KING BILLY MORRIS

CITY MANAGER
JULIE COUCH

CITY ENGINEER
CHUCK TODD, P.E.

SHEET INDEX

- 1A DIMENSIONAL CONTROL PLAN
- 2A WATER & WASTEWATER PLAN
- 3A GRADING PLAN
- 4A DRAINAGE AREA MAP
- 5A DRAINAGE PLAN & PROFILE
- 6A EROSION CONTROL PLAN

- A101 ARCHITECTURAL SITE PLAN
- A110 ARCHITECTURAL PAVING PLAN (PH. I)
- A111 ARCHITECTURAL PAVING PLAN (PH. II)
- A120 PAVING DETAILS
- A600 SCREEN WALL DETAIL


OWNER:

ROCKWALL ECONOMIC
DEVELOPMENT CORPORATION
697 EAST INTERSTATE 30
ROCKWALL, TEXAS 75087


ENGINEER:

 **GBW** Engineers, Inc.
Grantham, Borge & Weidbauer

1919 S. SHILOH ROAD
SUITE 530, L.B. 27
GARLAND, TEXAS 75042

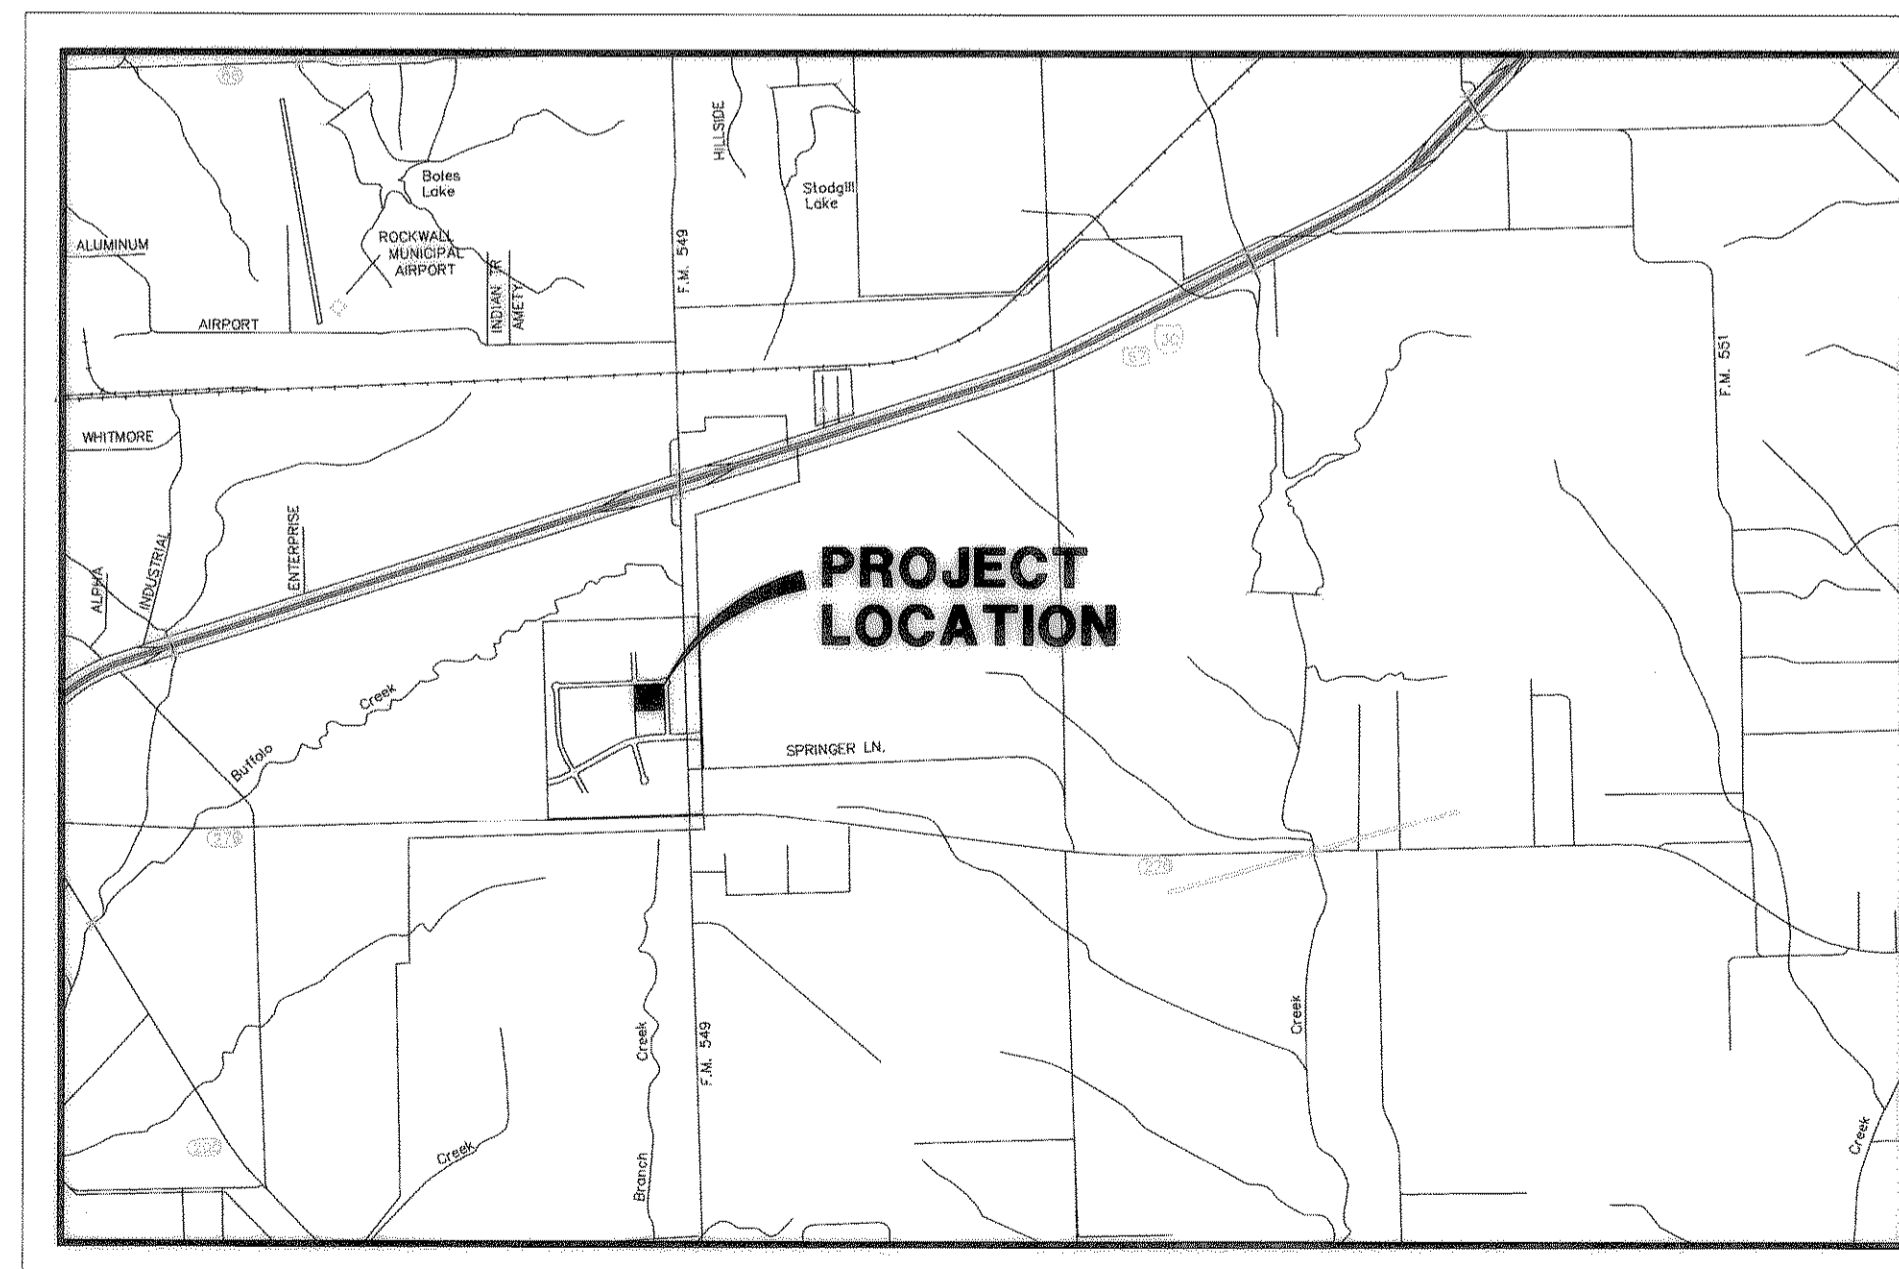

LOCATION MAP

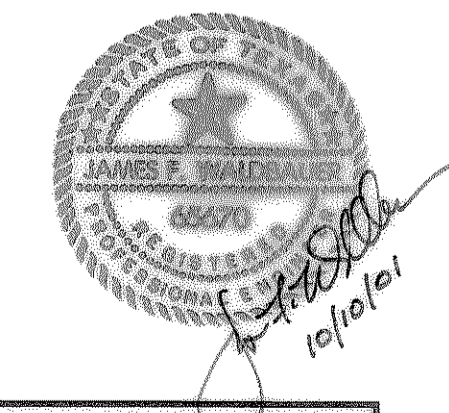

RECORD DRAWING
BASED ON CONTRACTOR MARKUPS,
NOT FIELD SURVEY.

GBW JOB NO. 00-245

DECEMBER, 2000