

CONSTRUCTION PLANS FOR ROCKWALL MANUFACTURING FACILITY LOT 1, BLOCK A, ROCKWALL TECHNOLOGY PARK, PHASE IV

30.035 ACRES

CITY OF ROCKWALL, ROCKWALL COUNTY, TEXAS


JULY 2016

Case Number: SP2016-12

Sheet List Table

Sheet Number	Sheet Title
C0.0	COVER SHEET
FP	FINAL PLAT (2 SHEETS)
SP-1	SITE PLAN
C1.1	DIMENSIONAL CONTROL PLAN
C1.2	DIMENSIONAL CONTROL PLAN
C1.3	DIMENSIONAL CONTROL PLAN
C1.4	DIMENSIONAL CONTROL PLAN
C2.1	GRADING PLAN
C2.2	GRADING PLAN
C2.3	GRADING PLAN
C2.4	GRADING PLAN
C3.1	DRAINAGE AREA MAPS
C3.2	DRAINAGE CRITERIA SHEET
C3.3	DETENTION CALCULATIONS SHEET
C3.4	DETENTION CALCULATIONS SHEET
C4.1	STORM SEWER PLAN
C4.2	STORM SEWER PLAN
C4.3	STORM SEWER PLAN
C4.4	STORM SEWER PLAN
C4.5	STORM SEWER PROFILE
C4.6	STORM SEWER PROFILE
C4.7	STORM SEWER PROFILE
C4.8	RIP-RAP DETAILS
C4.9	RIP-RAP DETAILS
C4.10	HYDRAULIC CALCULATIONS
C5.1	SANITARY SEWER PLAN & PROFILE
C5.2	SANITARY SEWER PLAN
C5.3	WATER PLAN
C5.4	WATER PLAN
C6.1	PAVING PLAN
C6.2	PAVEMENT DETAILS
C7.1	EROSION CONTROL PLAN
C7.2	EROSION CONTROL DETAILS
C8.1	EAST DETENTION POND GRADING PLAN
C8.2	EAST DETENTION POND DRAINAGE AREA MAP
C8.3	EAST DETENTION POND CALCULATIONS
C8.4	EAST DETENTION POND STORM SEWER PLAN
C8.5	EAST DETENTION POND STORM SEWER DETAILS

PREPARED BY
Pacheco Koch
7557 RAMBLER ROAD SUITE 1400 T: 972.235.3031
DALLAS, TX 75231 F: 972.235.9544
TX REG. ENGINEERING FIRM F-14439
TX REG. SURVEYING FIRM LS-10193805

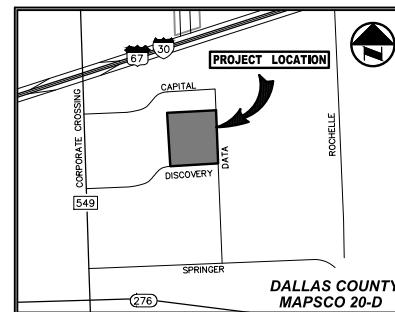

VICINITY MAP
(NOT TO SCALE)

RECORD DRAWING

THE SIGNED AND SEALED CONSTRUCTION DOCUMENT HAS BEEN REVISED TO REFLECT CONSTRUCTION RECORDS MAINTAINED AND PROVIDED BY THE CONTRACTOR FOR THIS PROJECT. THE INFORMATION SHOWN ON THIS RECORD DRAWING, WHICH WAS PROVIDED BY THE CONTRACTOR, OR OTHERS NOT ASSOCIATED WITH THE DESIGN ENGINEER, CANNOT BE VERIFIED FOR ACCURACY OR COMPLETENESS. PACHECO KOCH SHALL ASSUME NO LIABILITY FOR ANY CHANGES MADE DURING CONSTRUCTION THAT WERE NOT SPECIFICALLY APPROVED BY THE ENGINEER PRIOR TO CONSTRUCTION. THE SEALED CONSTRUCTION DRAWINGS ARE ON FILE AT THE OFFICES OF PACHECO KOCH.

ATTESTED BY: *[Signature]*
SIGNATURE: CHET LEUGERS, P.E.
ENGINEER OF RECORD: CHET LEUGERS, P.E.
CONTRACTOR: MILLER-VALENTINE CONSTRUCTION
DATE REVISED: 06/08/2017

NO.	DATE	REVISION
1	06/09/2017	RECORD DRAWINGS
2	08/25/2016	ADDED SHEETS