

DA 8
1.00
7.99


DA 8
1.00
7.99

PROPOSED DRAINAGE AREA ID
AREA IN ACRES
Q₁₀₀ IN CUBIC FEET PER SECOND

DESIGN BASIS
DRAINAGE AREA ID
AREA IN ACRES
Q₁₀₀ IN CUBIC FEET PER SECOND

NOTE:
REFER TO SHEET C3.2 FOR
DRAINAGE CRITERIA TABLE

DESIGN BASIS DRAINAGE DIVIDE PER
WIER & ASSOCIATES PLANS FOR
ROCKWALL TECHNOLOGY PARK PHASE IV
DATED: FEBRUARY 2015

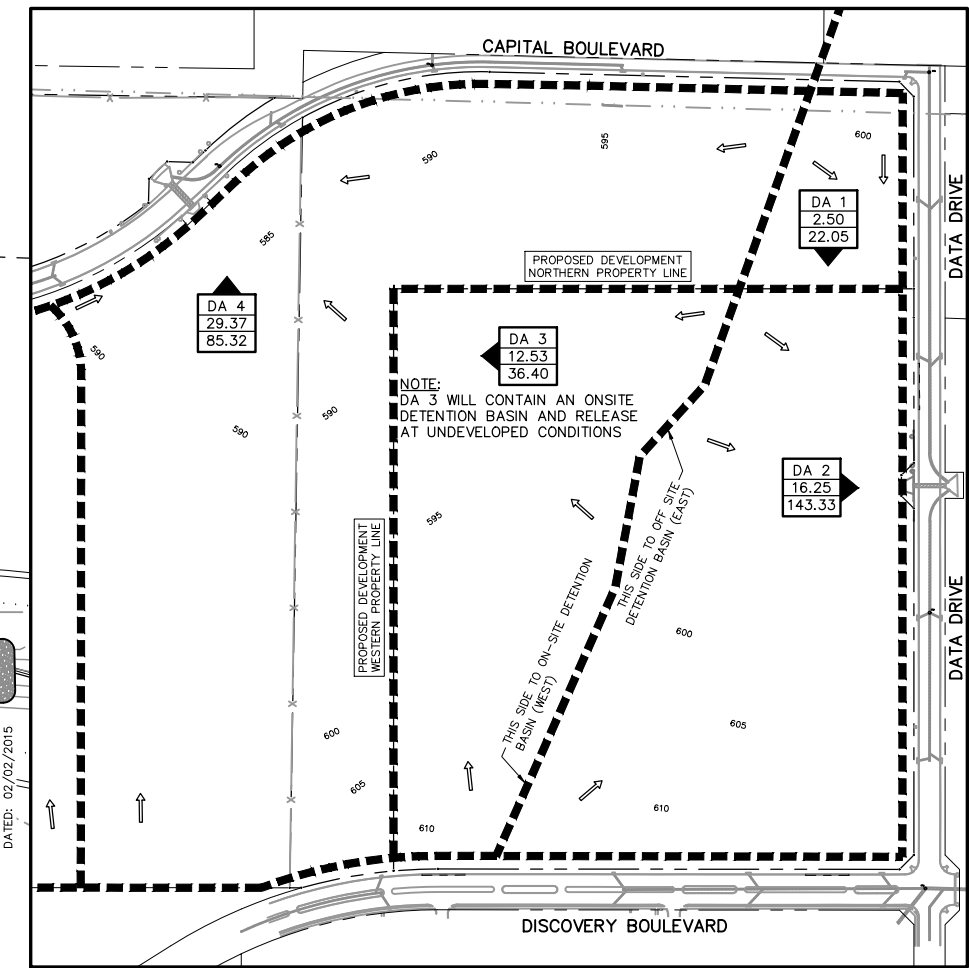

DESIGN BASIS DRAINAGE AREA MAP
SCALE: 1"=200'

DESIGN BASIS DRAINAGE DIVIDE PER
WIER & ASSOCIATES PLANS FOR
ROCKWALL TECHNOLOGY PARK PHASE IV
DATED: FEBRUARY 2015

DATA DRIVE

DATA DRIVE

RECORD DRAWING

THE SIGNED AND SEALED CONSTRUCTION DOCUMENT HAS BEEN REVISED TO REFLECT CONSTRUCTION RECORDS MAINTAINED AND PROVIDED BY THE CONTRACTOR FOR THIS PROJECT. THE INFORMATION SHOWN ON THIS RECORD DRAWING, WHICH WAS PROVIDED BY THE CONTRACTOR, OR OTHERS NOT ASSOCIATED WITH THE DESIGN ENGINEER, CANNOT BE VERIFIED FOR ACCURACY OR COMPLETENESS. PACHECO KOCH SHALL ASSUME NO LIABILITY FOR ANY CHANGES MADE DURING CONSTRUCTION THAT WERE NOT SPECIFICALLY APPROVED BY THE ENGINEER PRIOR TO CONSTRUCTION. THE SEALED CONSTRUCTION DRAWINGS ARE ON FILE AT THE OFFICES OF PACHECO KOCH.

ATTESTED BY:
SIGNATURE: *[Signature]*
ENGINEER OF RECORD: CHET LEUGERS, P.E.
CONTRACTOR: MILLER-VALENTINE CONSTRUCTION
DATE REVISED: 06/08/2017

NO.	DATE	REVISION
1	06/09/2017	RECORD DRAWINGS

Pacheco Koch
7557 RAMBLER ROAD, SUITE 1400
DALLAS, TX 75231 972.235.3031
TX REG. ENGINEERING FIRM F-14439
TX REG. SURVEYING FIRM LS-10193805

DRAINAGE AREA MAPS
ROCKWALL MANUFACTURING FACILITY
LOT 1, BLOCK A, ROCKWALL
TECHNOLOGY PARK, PHASE IV
CITY OF ROCKWALL, ROCKWALL COUNTY, TEXAS

DESIGN	DRAWN	DATE	SCALE	NOTES	FILE	NO.
CTL	RHB	JULY 2016	1"=80'			C3.1

NELSON
6/14/2017 11:53 AM
M:\DWG-37\3782-16.05A\DWG\CIVIL C3D 2015\3782-16.05A\DWG.DWG

Rockwall Manufacturing Facility