

# CITY OF ROCKWALL, TEXAS

PAVING, DRAINAGE, WATER & SEWER IMPROVEMENTS

TO SERVE

## ROCKWALL TECHNOLOGY PARK

### INDEX OF DRAWINGS

**GEORGE HATFIELD - MAYOR**

#### COUNCIL MEMBERS

**RON COLESON**

**NELL WELBORN - Mayor Pro Tem**


**SAM BUFFINGTON**

**DALE MORGAN**


**BILLY MORRIS**

**SCOTT SELF**

**JULIE COUCH - City Manager**

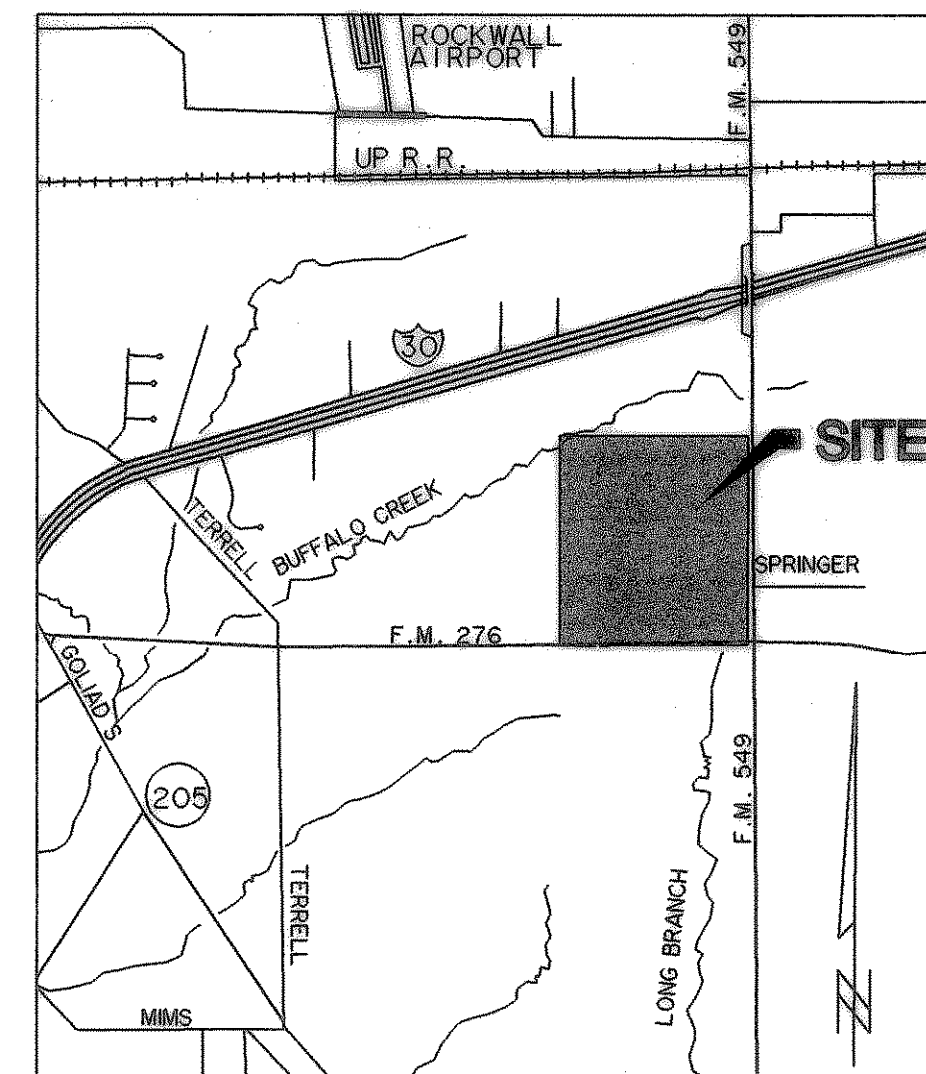

VICINITY MAP  
N.T.S.

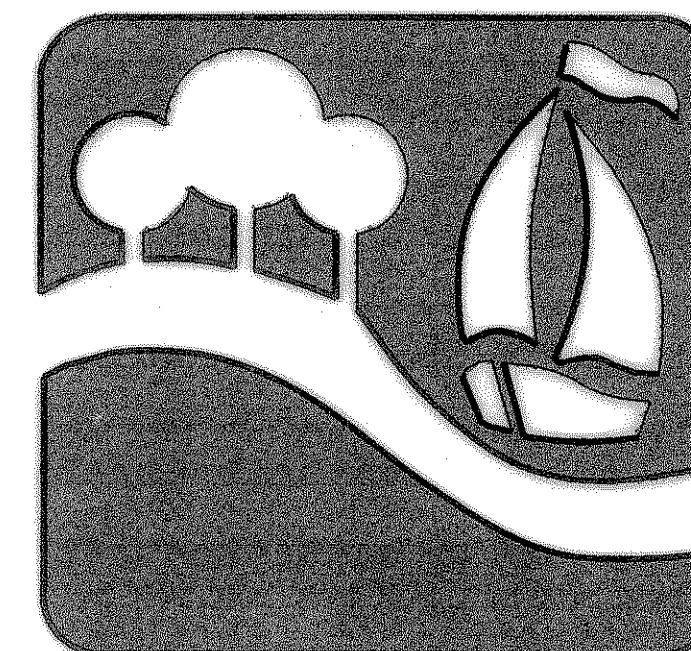

"THE NEW HORIZON"



PREPARED BY:  
**VIA WIER & ASSOCIATES, INC.**

ENGINEERS SURVEYORS LAND PLANNERS

4300 BELTWAY PLACE SUITE 130 ARLINGTON, TEXAS 76018 METRO (817)467-7700  
4108 AMON CARTER BLVD. SUITE 200 FORT WORTH, TEXAS 76155 METRO (817)355-9437

JANUARY, 1999

1. COVER SHEET
2. GENERAL NOTES
- 3A. TYPICAL SECTIONS
- 3B. PAVING DETAILS AND CURB DETAILS
4. COORDINATE CONTROL MAP
5. DISCOVERY BOULEVARD PAVING PLAN AND PROFILE STA. 0+00 TO 8+00
6. DISCOVERY BOULEVARD PAVING PLAN AND PROFILE STA. 8+00 TO STA. 18+00
7. DISCOVERY BOULEVARD PAVING PLAN AND PROFILE STA. 18+00 TO STA. 25+71.30
8. INNOVATION DRIVE PAVING PLAN AND PROFILE STA. 0+00 TO STA. 8+00
9. INNOVATION DRIVE PAVING PLAN AND PROFILE STA. 8+00 TO STA. 18+00
10. INNOVATION DRIVE PAVING PLAN AND PROFILE STA. 18+00 TO STA. 26+00
11. OBSERVATION TRAIL PAVING PLAN AND PROFILE STA. 26+00 TO STA. 33+00
12. OBSERVATION TRAIL PAVING PLAN AND PROFILE STA. 33+00 TO STA. 41+00
13. SCIENCE PLACE PAVING PLAN AND PROFILE STA. 41+00 TO STA. 47+07.87
14. RESEARCH CIRCLE PAVING PLAN AND PROFILE STA. 0+00 TO STA. 5+75.00
15. TECHNOLOGY WAY PAVING PLAN AND PROFILE STA. 0+00 TO STA. 4+31.00
16. DRIVEWAY/ ROADWAY INTERSECTION PLANS
17. ON-SITE DRAINAGE AREA MAP
18. STORM DRAIN CALCULATIONS
19. STORM DRAIN LINE "A" PLAN AND PROFILE STA. 0+00 TO STA. 7+00
20. STORM DRAIN LINE "A" PLAN AND PROFILE STA. 7+00 TO STA. 16+17.40
21. STORM DRAIN LINE "B" PLAN AND PROFILE STA. 0+00 TO STA. 9+00
22. STORM DRAIN LINE "B" PLAN AND PROFILE STA. 9+00 TO STA. 14+84.37
23. DETENTION POND "A"
24. DETENTION POND "B"
25. STORM DRAIN LATERALS LINE "A"
26. STORM DRAIN LATERALS LINE "A"
27. STORM DRAIN LATERALS LINE "B"
28. STORM DRAIN LATERALS LINE "B"
- 29A. WATER LAYOUT
- 29B. WATER LAYOUT
- 30A. SANITARY SEWER LAYOUT
- 30B. SANITARY SEWER LAYOUT
31. SANITARY SEWER PROFILES LINE "A"
32. SANITARY SEWER PROFILES LINE "A"
33. SANITARY SEWER PROFILES LINE "B"
34. SANITARY SEWER PROFILES LINES "B" AND "C"
35. SANITARY SEWER PROFILES LINES "C" AND "D"
36. WATER LINE "A" PROFILES
37. WATER LINE "A" AND "D" PROFILES
38. WATER LINE "BCE" PROFILES
39. WATER LINE "BCE" PROFILES
40. WATER LINE "BCE" AND "F" PROFILES
- 41A. SLEEVING PLAN
- 41B. SLEEVING PLAN
- 42A. EROSION CONTROL PLAN
- 42B. EROSION CONTROL PLAN
43. EROSION CONTROL DETAILS
44. STORM WATER POLLUTION PREVENTION PLAN DETAILS
45. STORM WATER POLLUTION PREVENTION PLAN
46. FINAL PLAT
47. SUMMARY OF QUANTITIES

#### RECORD DRAWINGS

These as-built or record drawings (or corrected specifications) have been prepared, in part, on the basis of information compiled and furnished by others. The Engineer will not be responsible for any errors or omissions which have been incorporated into this document as a result.

W.A. 98041

ISSUED FOR CONSTRUCTION 4-15-99