


RECORD DRAWINGS
 These as-built or record drawings for corrected specifications have been prepared, in part, on the basis of information compiled and furnished by others. The Engineer will not be responsible for any errors or omissions which have been incorporated into this document as a result.


BENCHMARKS:
 CITY MON. NO. 2
 LOCATED ON THE NORTHWEST CORNER OF THE BRIDGE @ I-30 AND F.M. 549
 ELEVATION 609.56
 "C" CUT IN THE CENTER OF A 4 FOOT HEADWALL LOCATED AT THE NORTHEAST CORNER OF F.M. 549 AND STATE HIGHWAY 276
 ELEVATION 592.75

LEGEND:

- DIRECTION OF FLOW
- 4000 psi CONC. PAVMT.
- PAVERS
- LANDSCAPE POD
- SWALE
- H.P. HIGH POINT

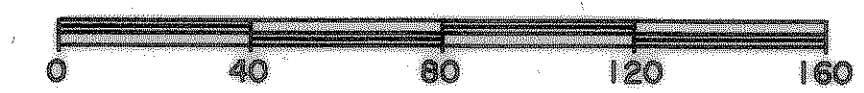

DISCOVERY BOULEVARD

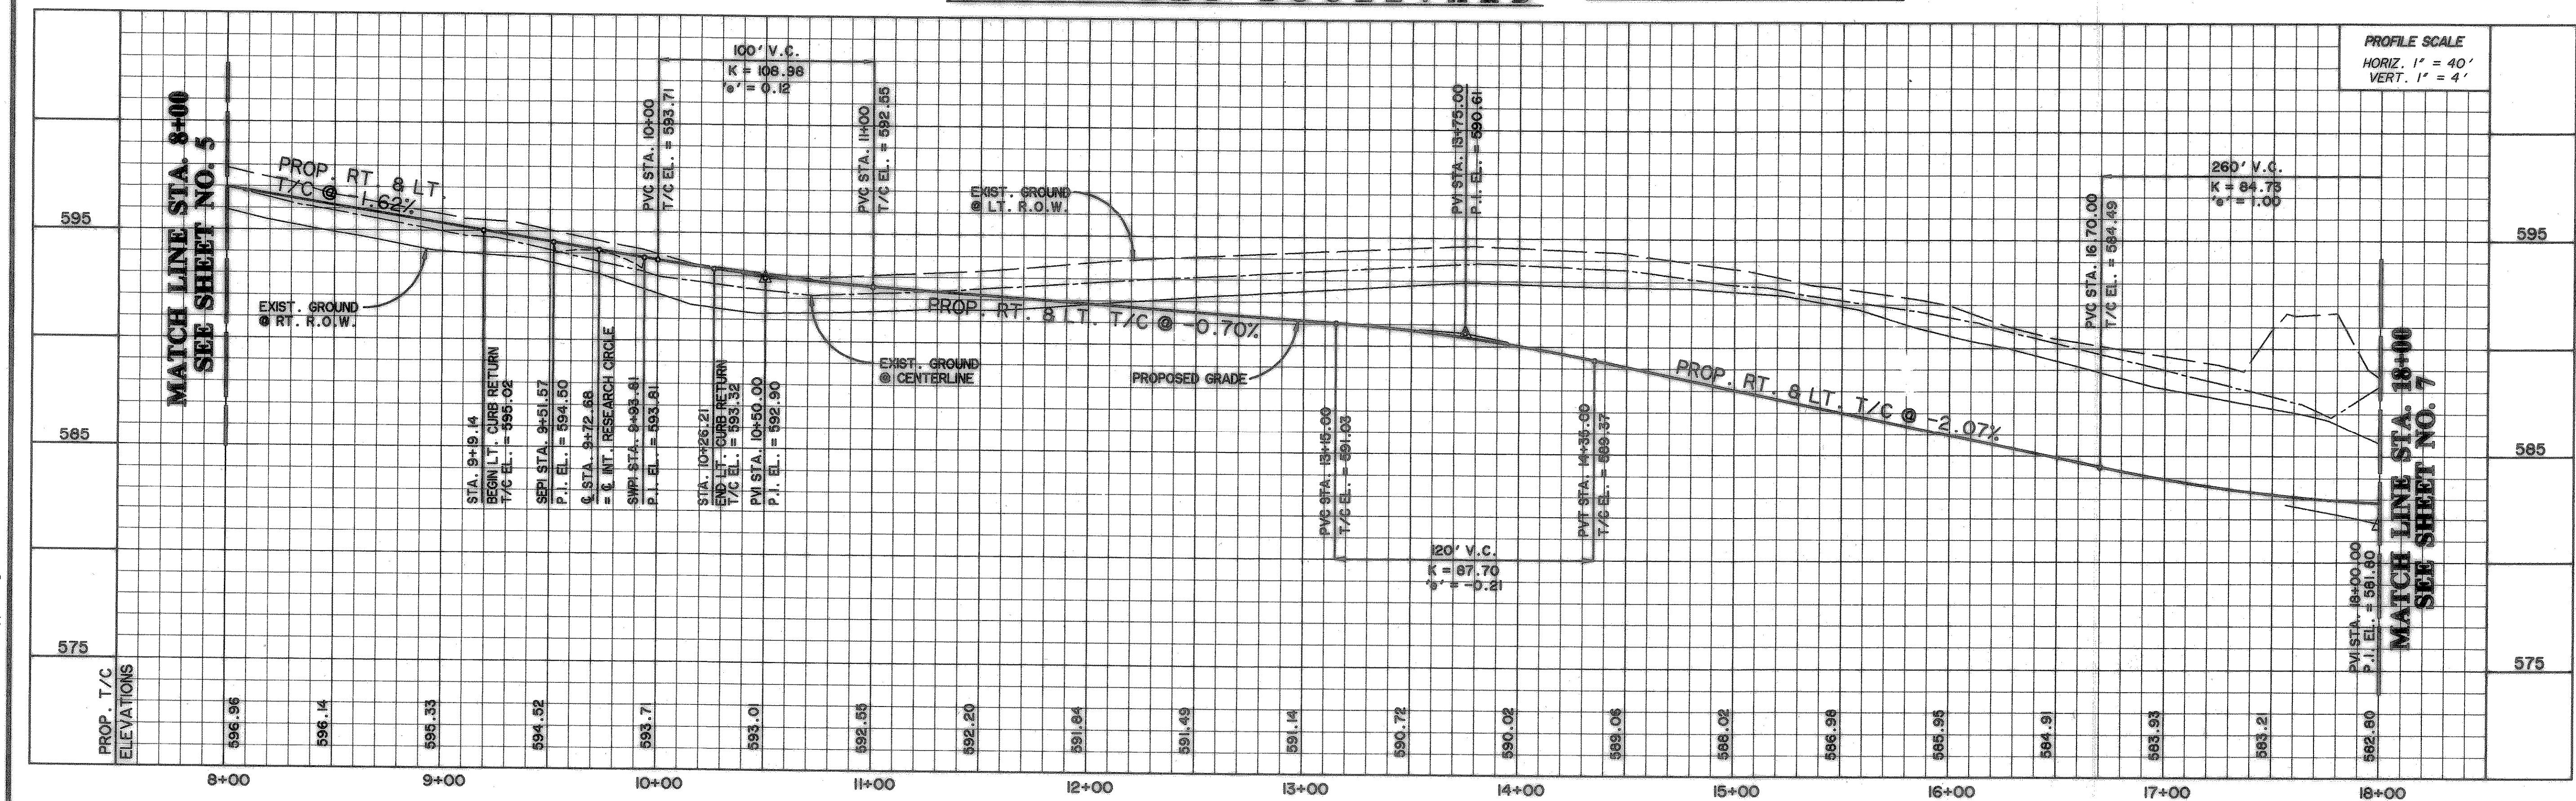

TIME 16:05 FILE: App2.dwg