


TIME: 16:54 FILE: SPROF-3.dwg

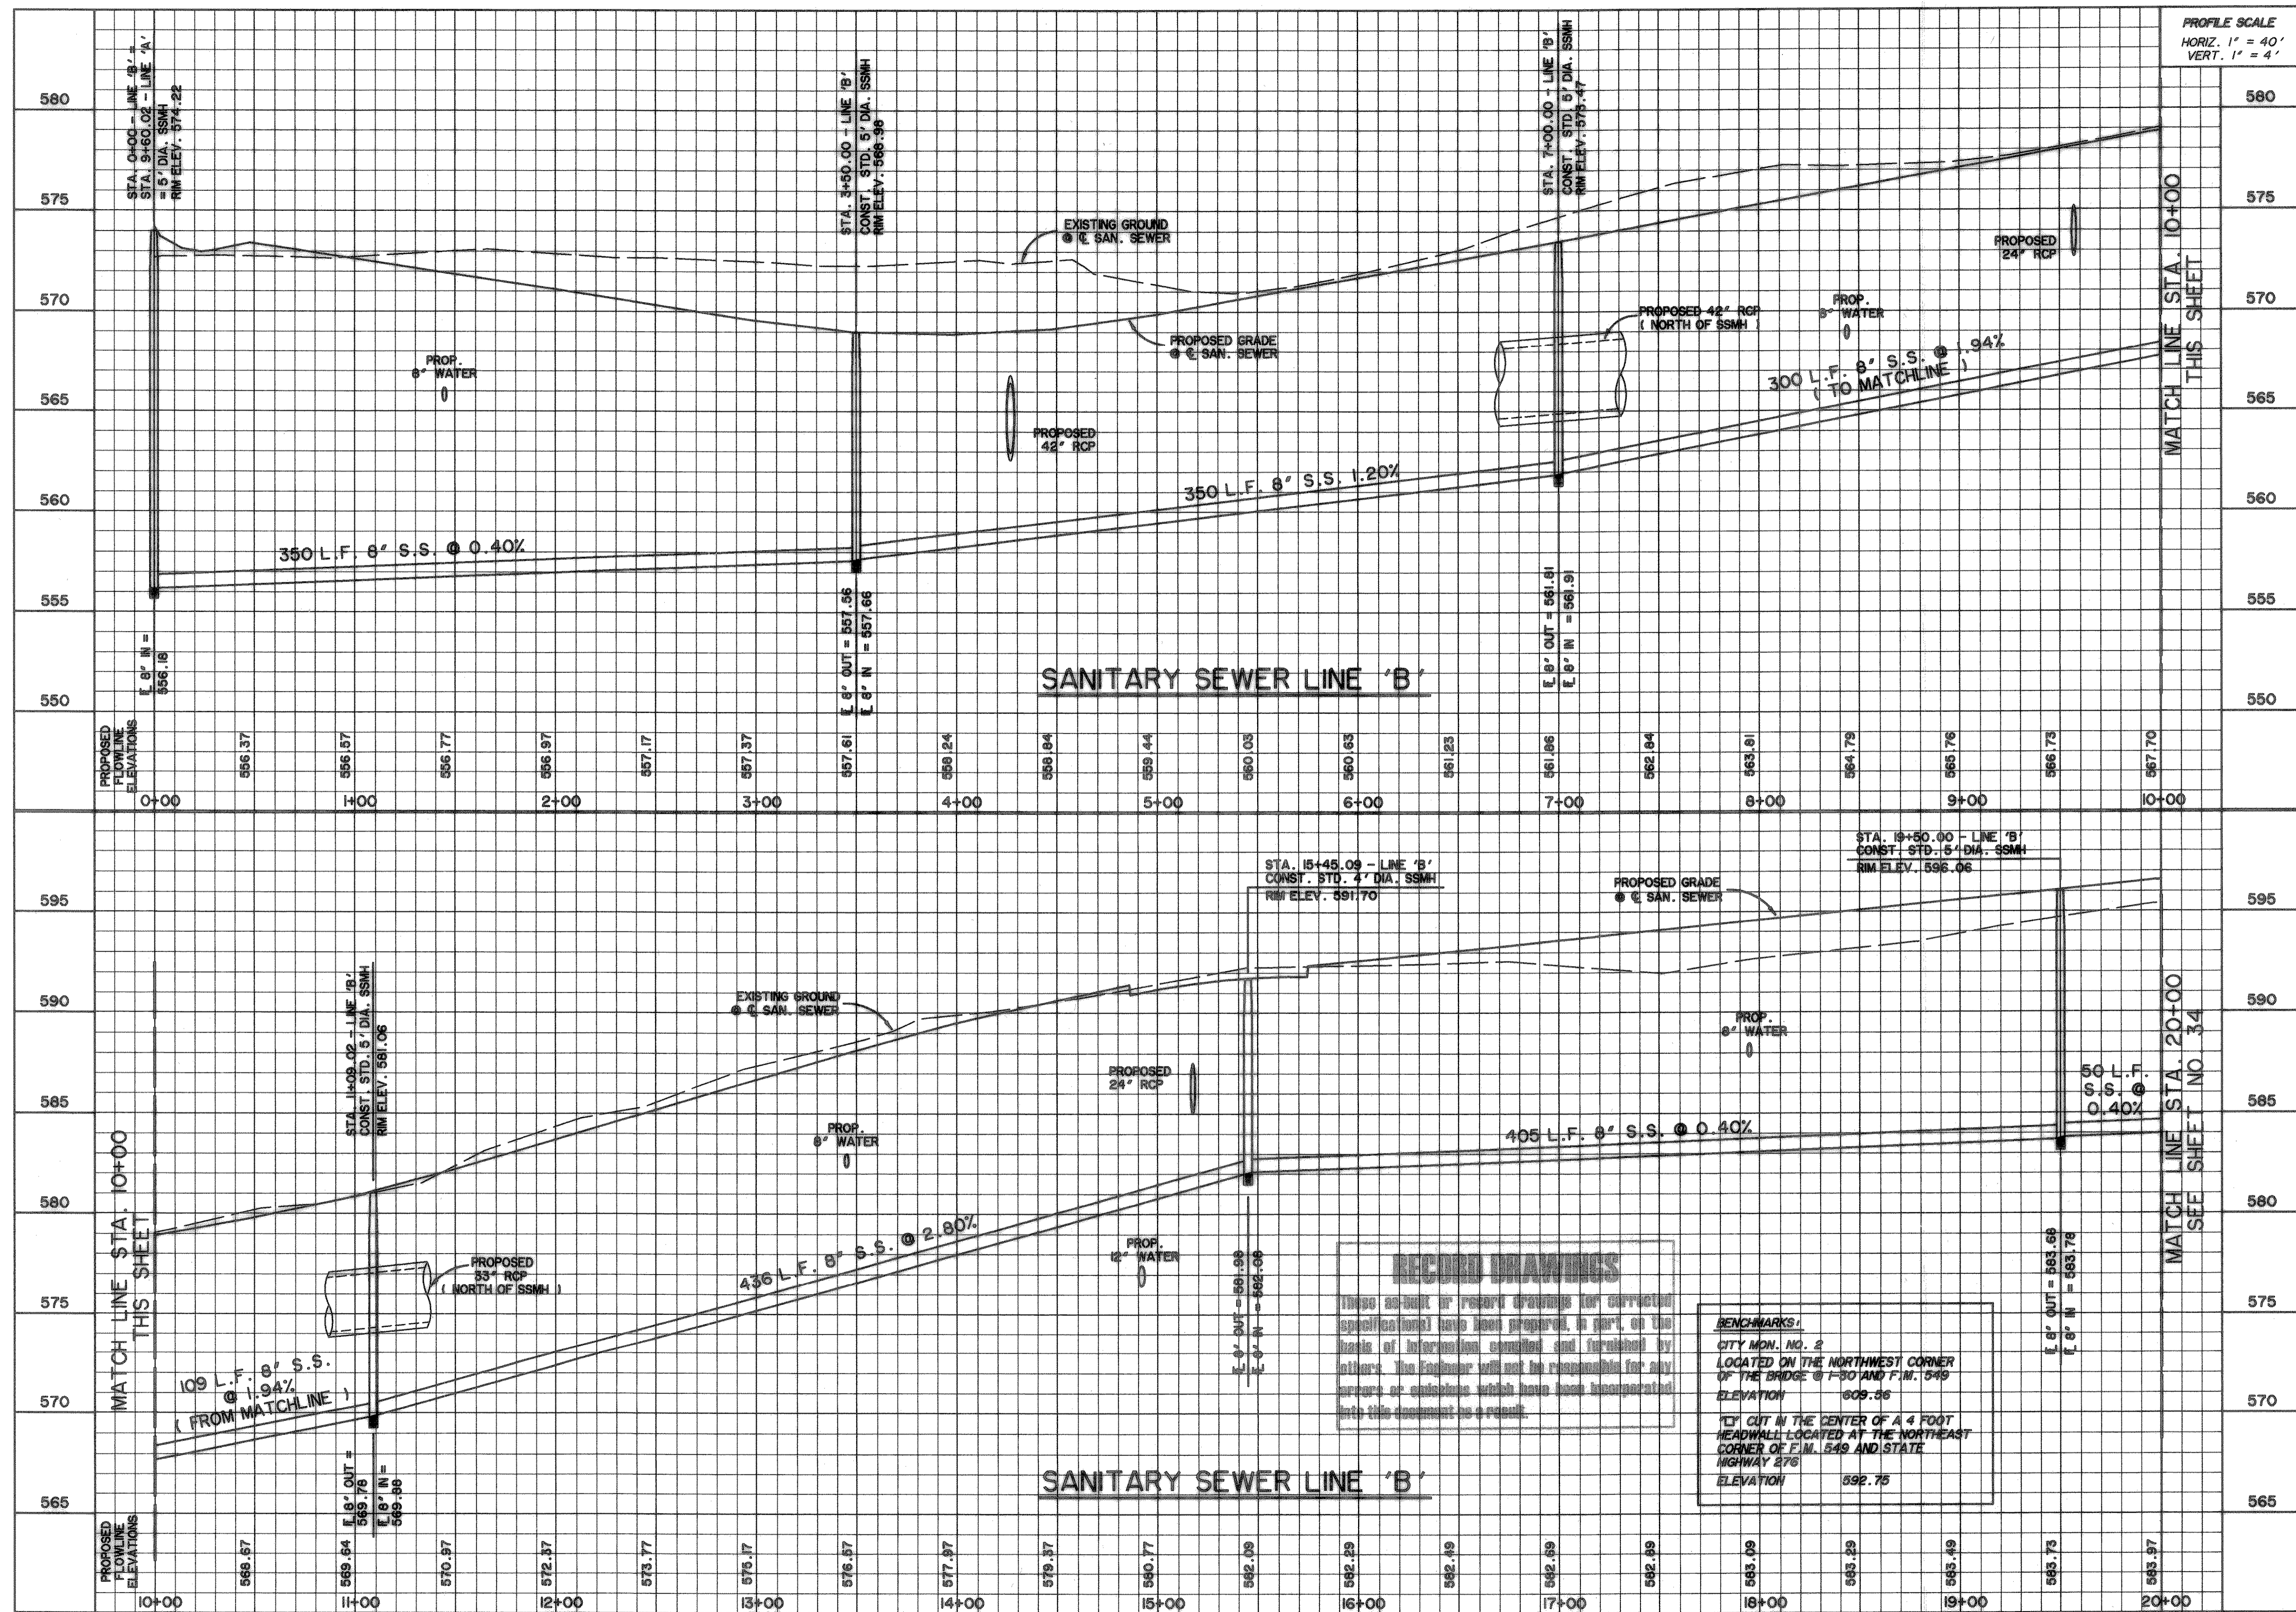

PREPARED BY:
WIA WIER & ASSOCIATES, INC.
 ENGINEERS SURVEYORS LAND PLANNERS
 430 DELWAY PLACE SUITE 130 ARLINGTON, TEXAS 76010 (817)467-7700
 4108 AMMUNITION BLVD. SUITE 200 FORT WORTH, TEXAS 76105 (817)355-5407

ROCKWALL TECHNOLOGY PARK

SANITARY SEWER PROFILES LINE B

STATE OF TEXAS
 RONALD RAINWATER
 51821
 PROFESSIONAL ENGINEER
 3/10/99

COPYRIGHT © WIER & ASSOCIATES, INC.
 LAST SHEET EDITED
 DATE 03-10-99
 VAW 98024
SHEET NO. 33