

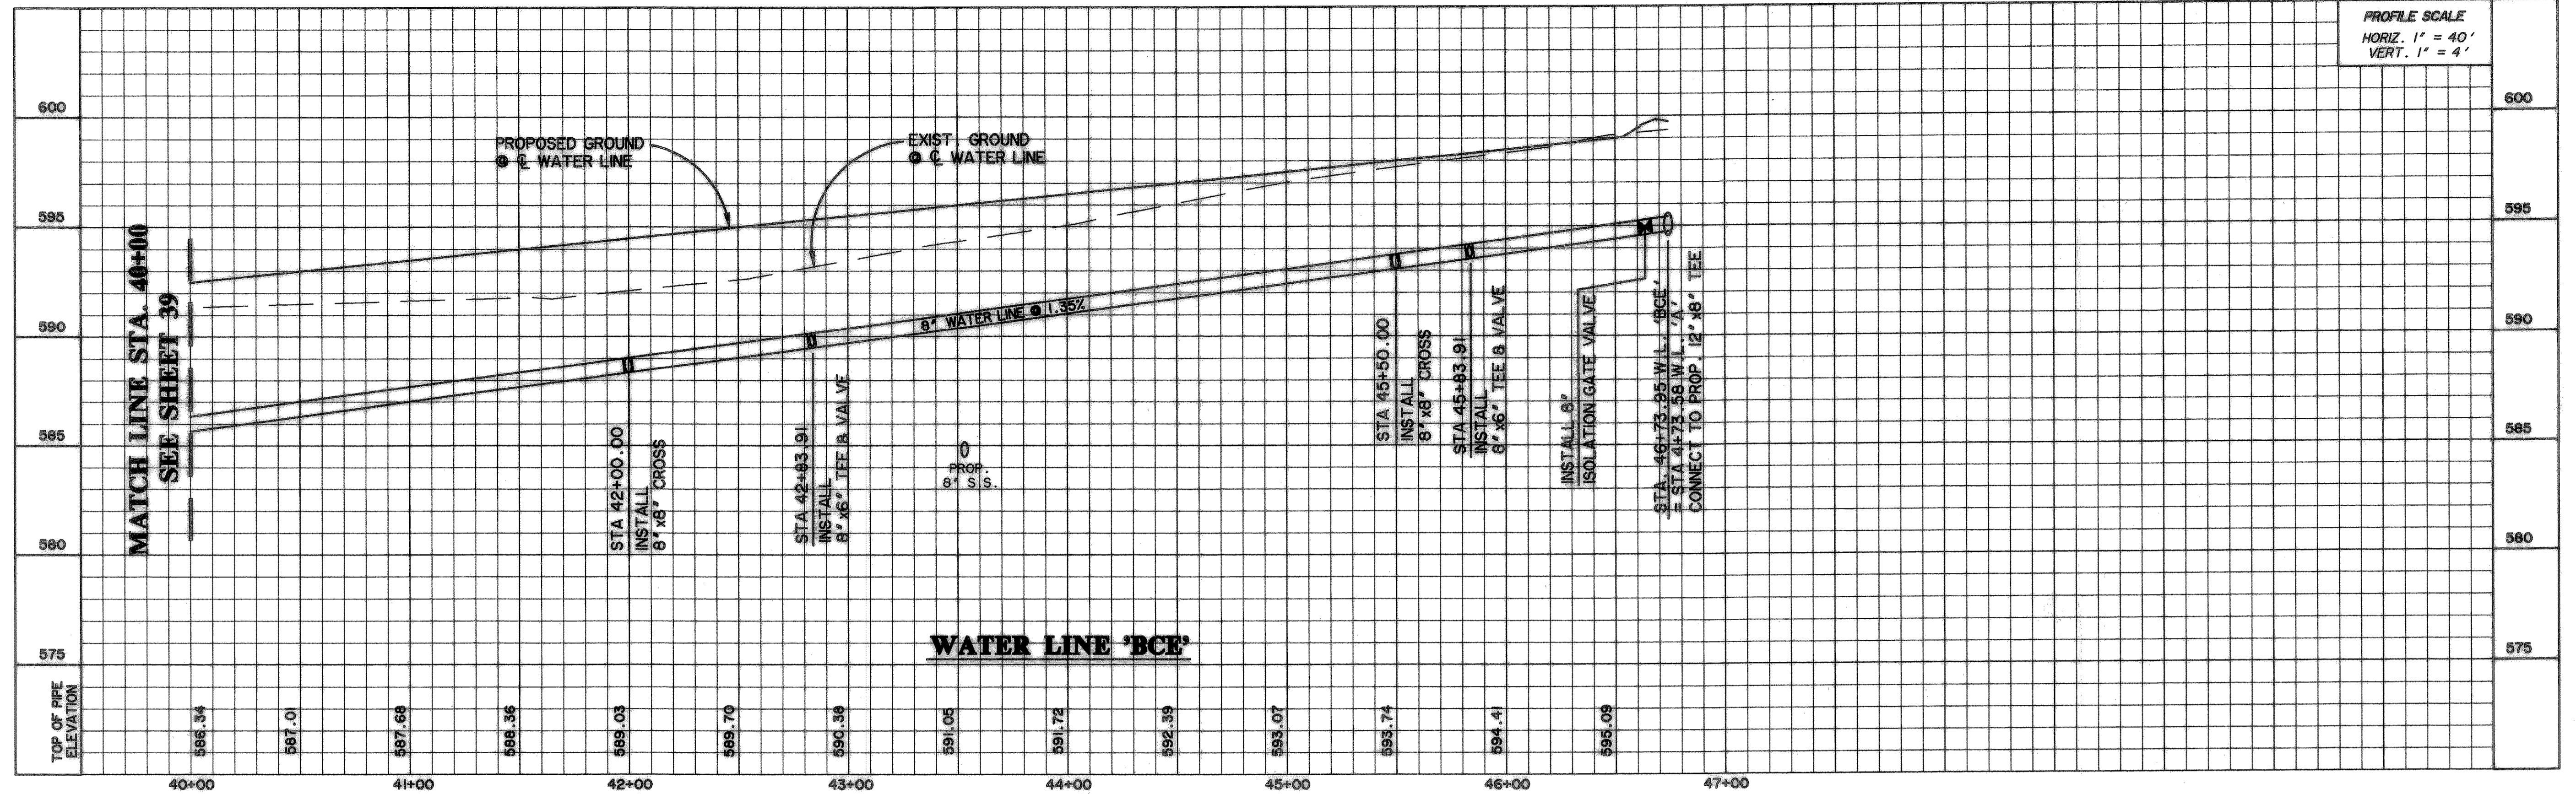


TIME: 17.38 FILE: WATERA5.dwg

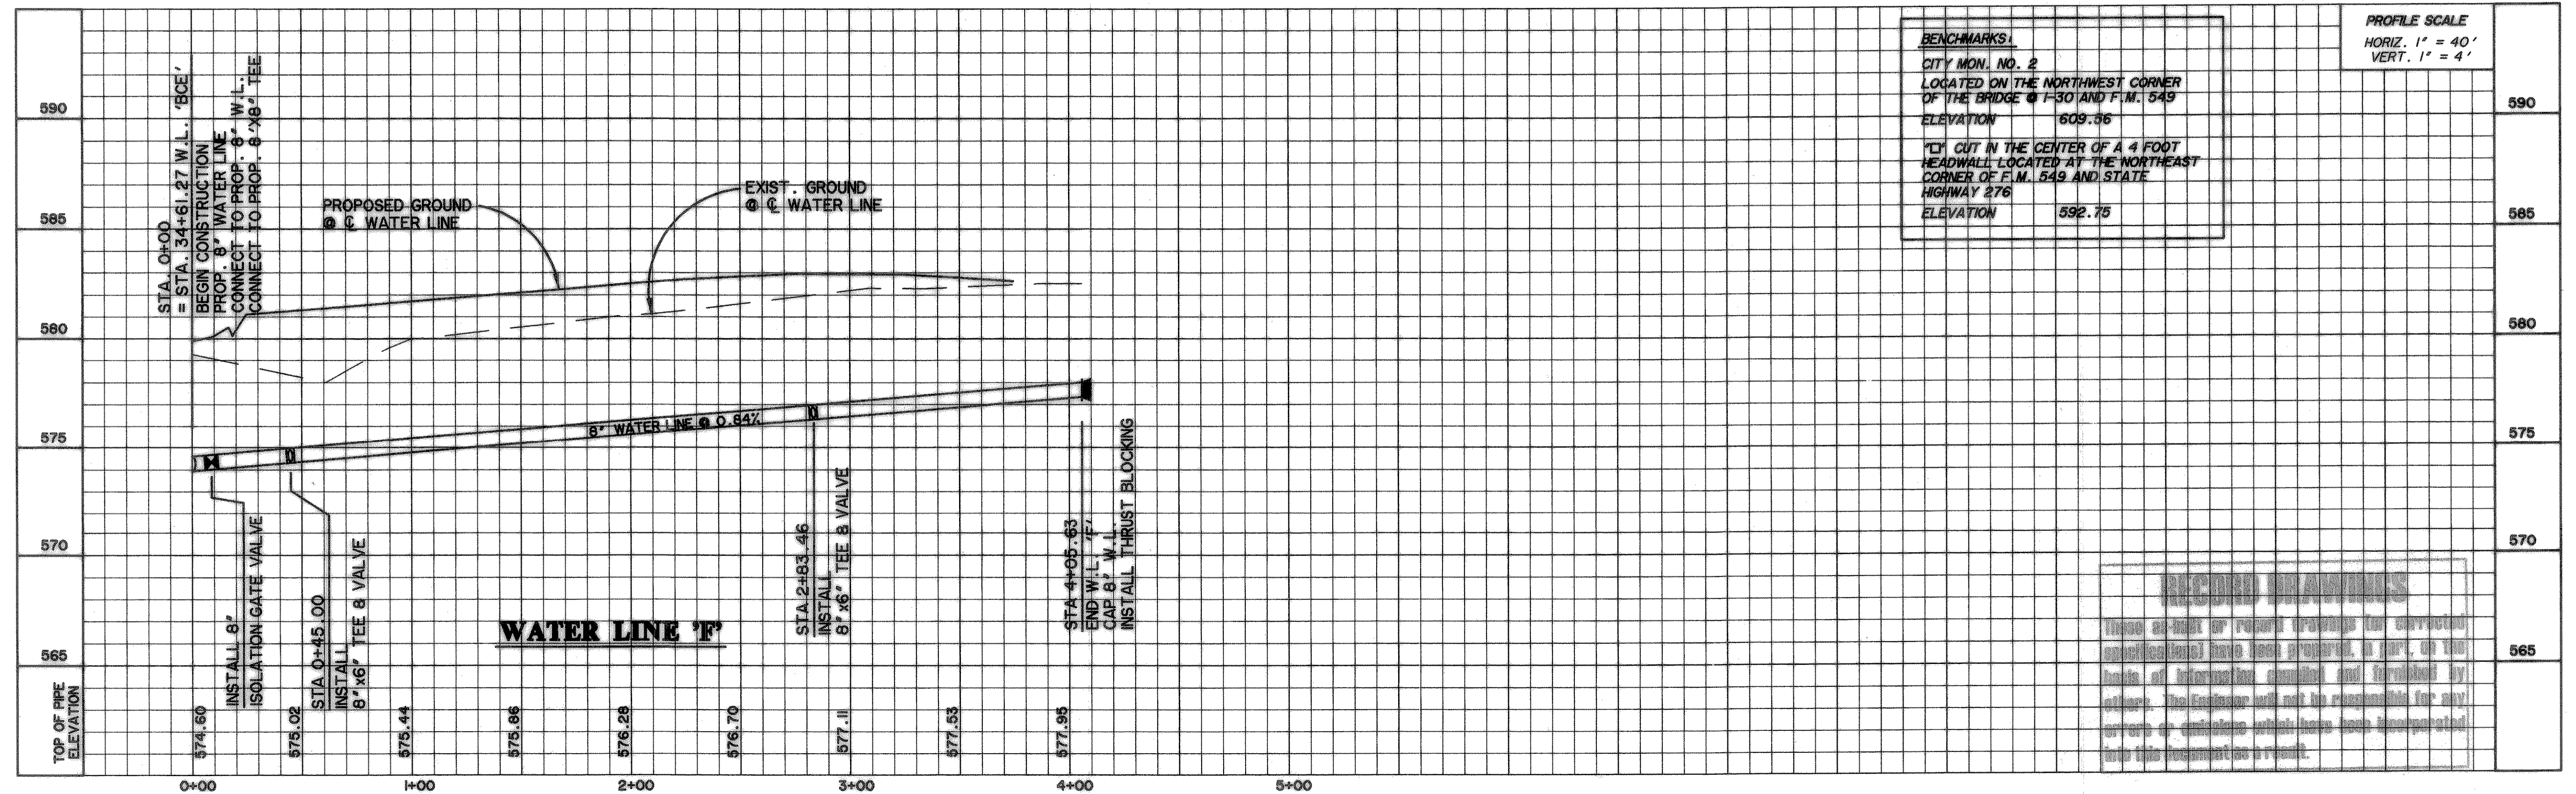


PREPARED BY:
VIA WIER & ASSOCIATES, INC.
 ENGINEERS SURVEYORS LAND PLANNERS
 4300 BELWAY PLACE SUITE 130 ARLINGTON, TEXAS 76016 METRO (817)467-7700
 4108 AMAR CARRIER BLVD. SUITE 200 FORT WORTH, TEXAS 76155 METRO (817)555-9457

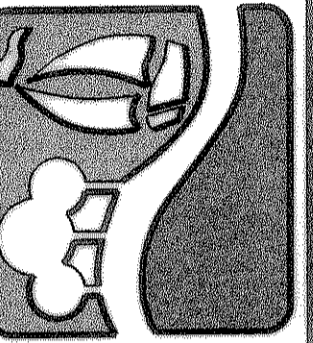

ROCKWALL TECHNOLOGY PARK

WATER LINE 'BCE' & 'F' PROFILES
 STA. 40+00 TO 46+73.95
 STA. 0+00 TO 4+05.63

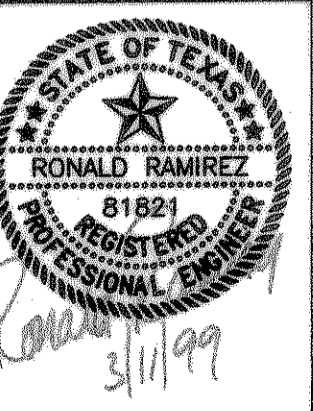

COPYRIGHT ©
 WIER & ASSOCIATES, INC.
 LAST SHEET EDIT
 DATE: 03-09-99
 W.A.# 9804
SHEET NO. 40