

CITY OF ROCKWALL, TEXAS

PAVING, DRAINAGE, WATER & SEWER IMPROVEMENTS

TO SERVE

ROCKWALL TECHNOLOGY PARK PHASE II

INDEX OF DRAWINGS

KEN JONES - MAYOR

COUNCIL MEMBERS:

TIM McCALLUM - Mayor Pro Tem

STEPHEN STRAUGHAN


BOB COTTI

JOHN KING

TERRY RAULSTON


BILL CECIL

JULIE COUCH - City Manager

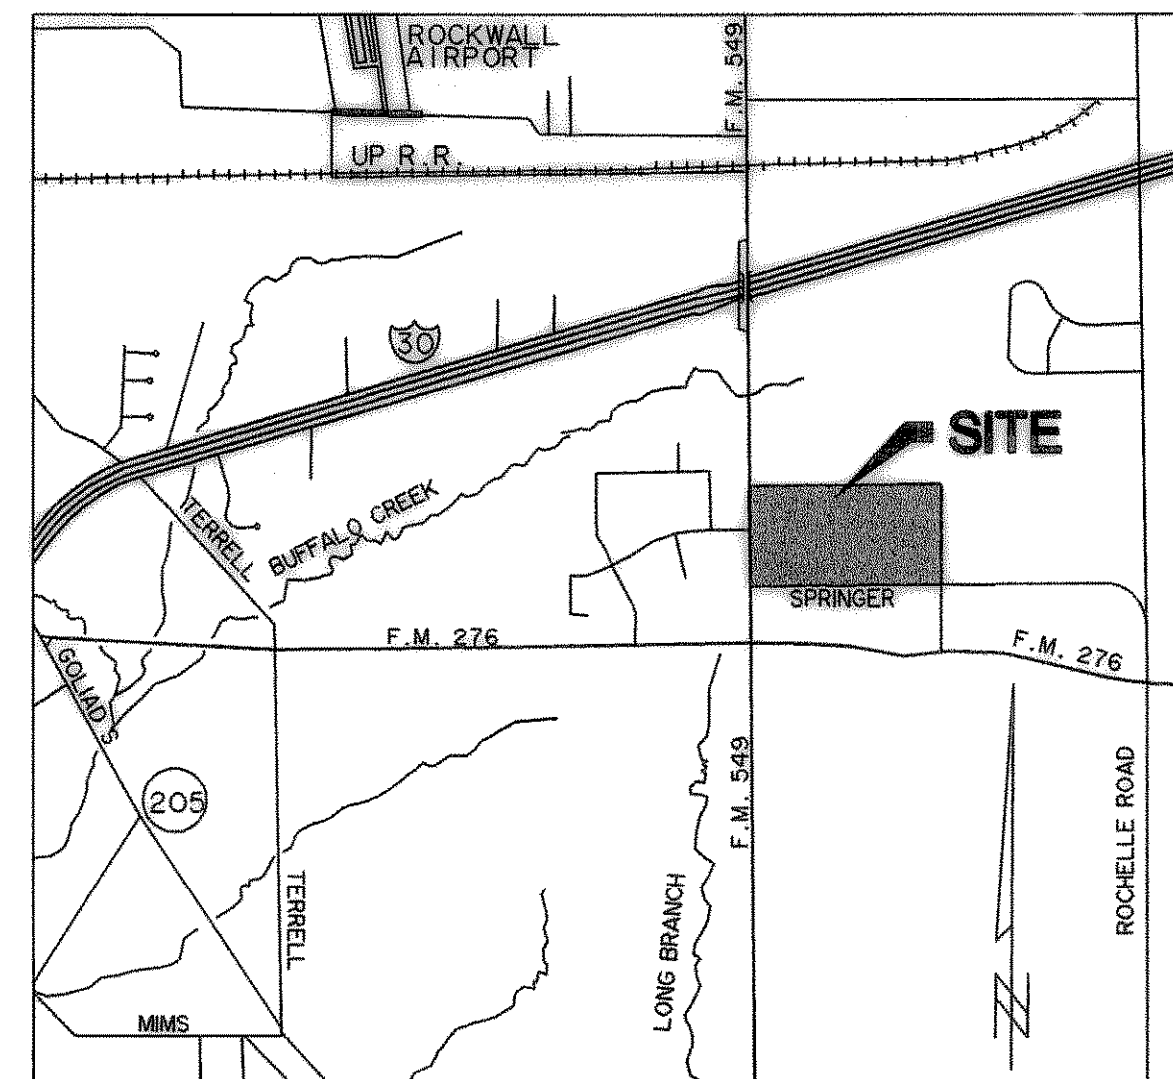

VICINITY MAP

N.T.S.

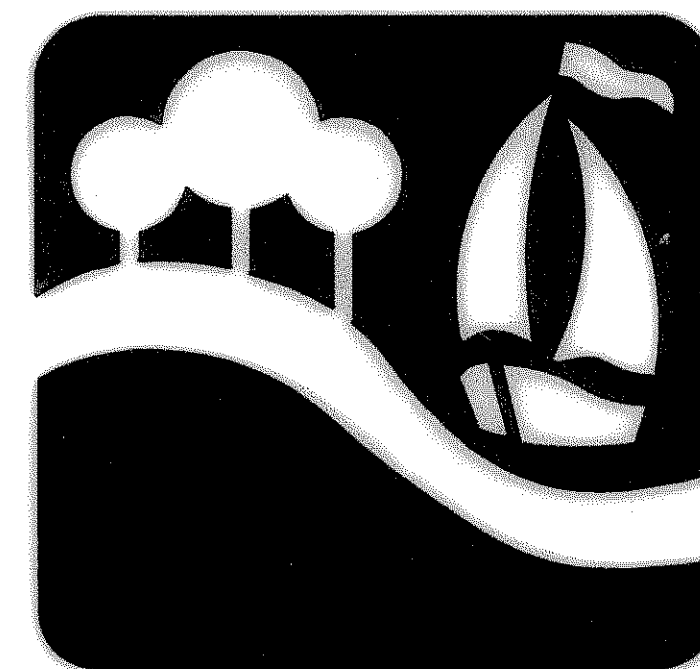

"THE NEW HORIZON"



Ronald Ramirez
8/24/06

**RECORD
DRAWING
08/04/06**

A001	COVER SHEET
A100	FINAL PLAT
A101	FINAL PLAT SHEET 2
A201	GENERAL NOTES
P001	TYPICAL SECTIONS
P002	PAVING DETAILS AND CURB DETAILS
P003	COORDINATE CONTROL MAP
P101	DISCOVERY BOULEVARD PAVING PLAN AND PROFILE STA. 0+00 TO 8+00
P102	SPRINGER ROAD PAVING PLAN AND PROFILE STA. 0+00 TO 10+00
P103	SPRINGER ROAD PAVING PLAN AND PROFILE STA. 10+00 TO 13+81.61
P104	F.M. 549 OVERLAY AND STRIPING PLAN
D001	OVERALL DRAINAGE AREA MAP
D002	TEMPORARY CONDITIONS DRAINAGE AREA MAP
D003	ON-SITE DRAINAGE AREA MAP
D101	DRAINAGE CHANNEL PLAN
D102	GUARDRAIL DETAIL
D201	STORM DRAIN CALCULATIONS
D202	STORM DRAIN CALCULATIONS
D301	STORM DRAIN LINE "A" PLAN AND PROFILE
D302	STORM DRAIN LINE "B" PLAN AND PROFILE
D302.1	STORM DRAIN LINE "D" PLAN AND PROFILE
D303	STORM DRAIN LINE "C" PLAN AND PROFILE STA. 0+00 TO STA. 8+00
D304	STORM DRAIN LINE "C" PLAN AND PROFILE STA. 8+00 TO STA. 13+19.68
D401	STORM DRAIN LATERALS LINE "A" & LINE "C"
D402	STORM DRAIN LATERALS LINE "C"
U101	WATER LAYOUT - DISCOVERY BLVD & SPRINGER RD
U102	SANITARY SEWER LAYOUT LINES "A", "B", & "C"
U103	SANITARY SEWER LAYOUT LINE "D"
U104	SANITARY SEWER PROFILES LINES "A" AND "B"
U105	SANITARY SEWER PROFILES LINES "B" AND "C"
U106	SANITARY SEWER PROFILES LINE "D"
S101	SLEEVING PLAN
E101	EROSION CONTROL PLAN
E201	EROSION CONTROL DETAILS
E202	EROSION CONTROL DETAILS
E301	STORM WATER POLLUTION PREVENTION NOTES
E302	STORM WATER POLLUTION PREVENTION NOTES
E303	STORM WATER POLLUTION PREVENTION NOTES

FEBRUARY, 2005