


TIME 16:54 FILE: DAMAP.dwg

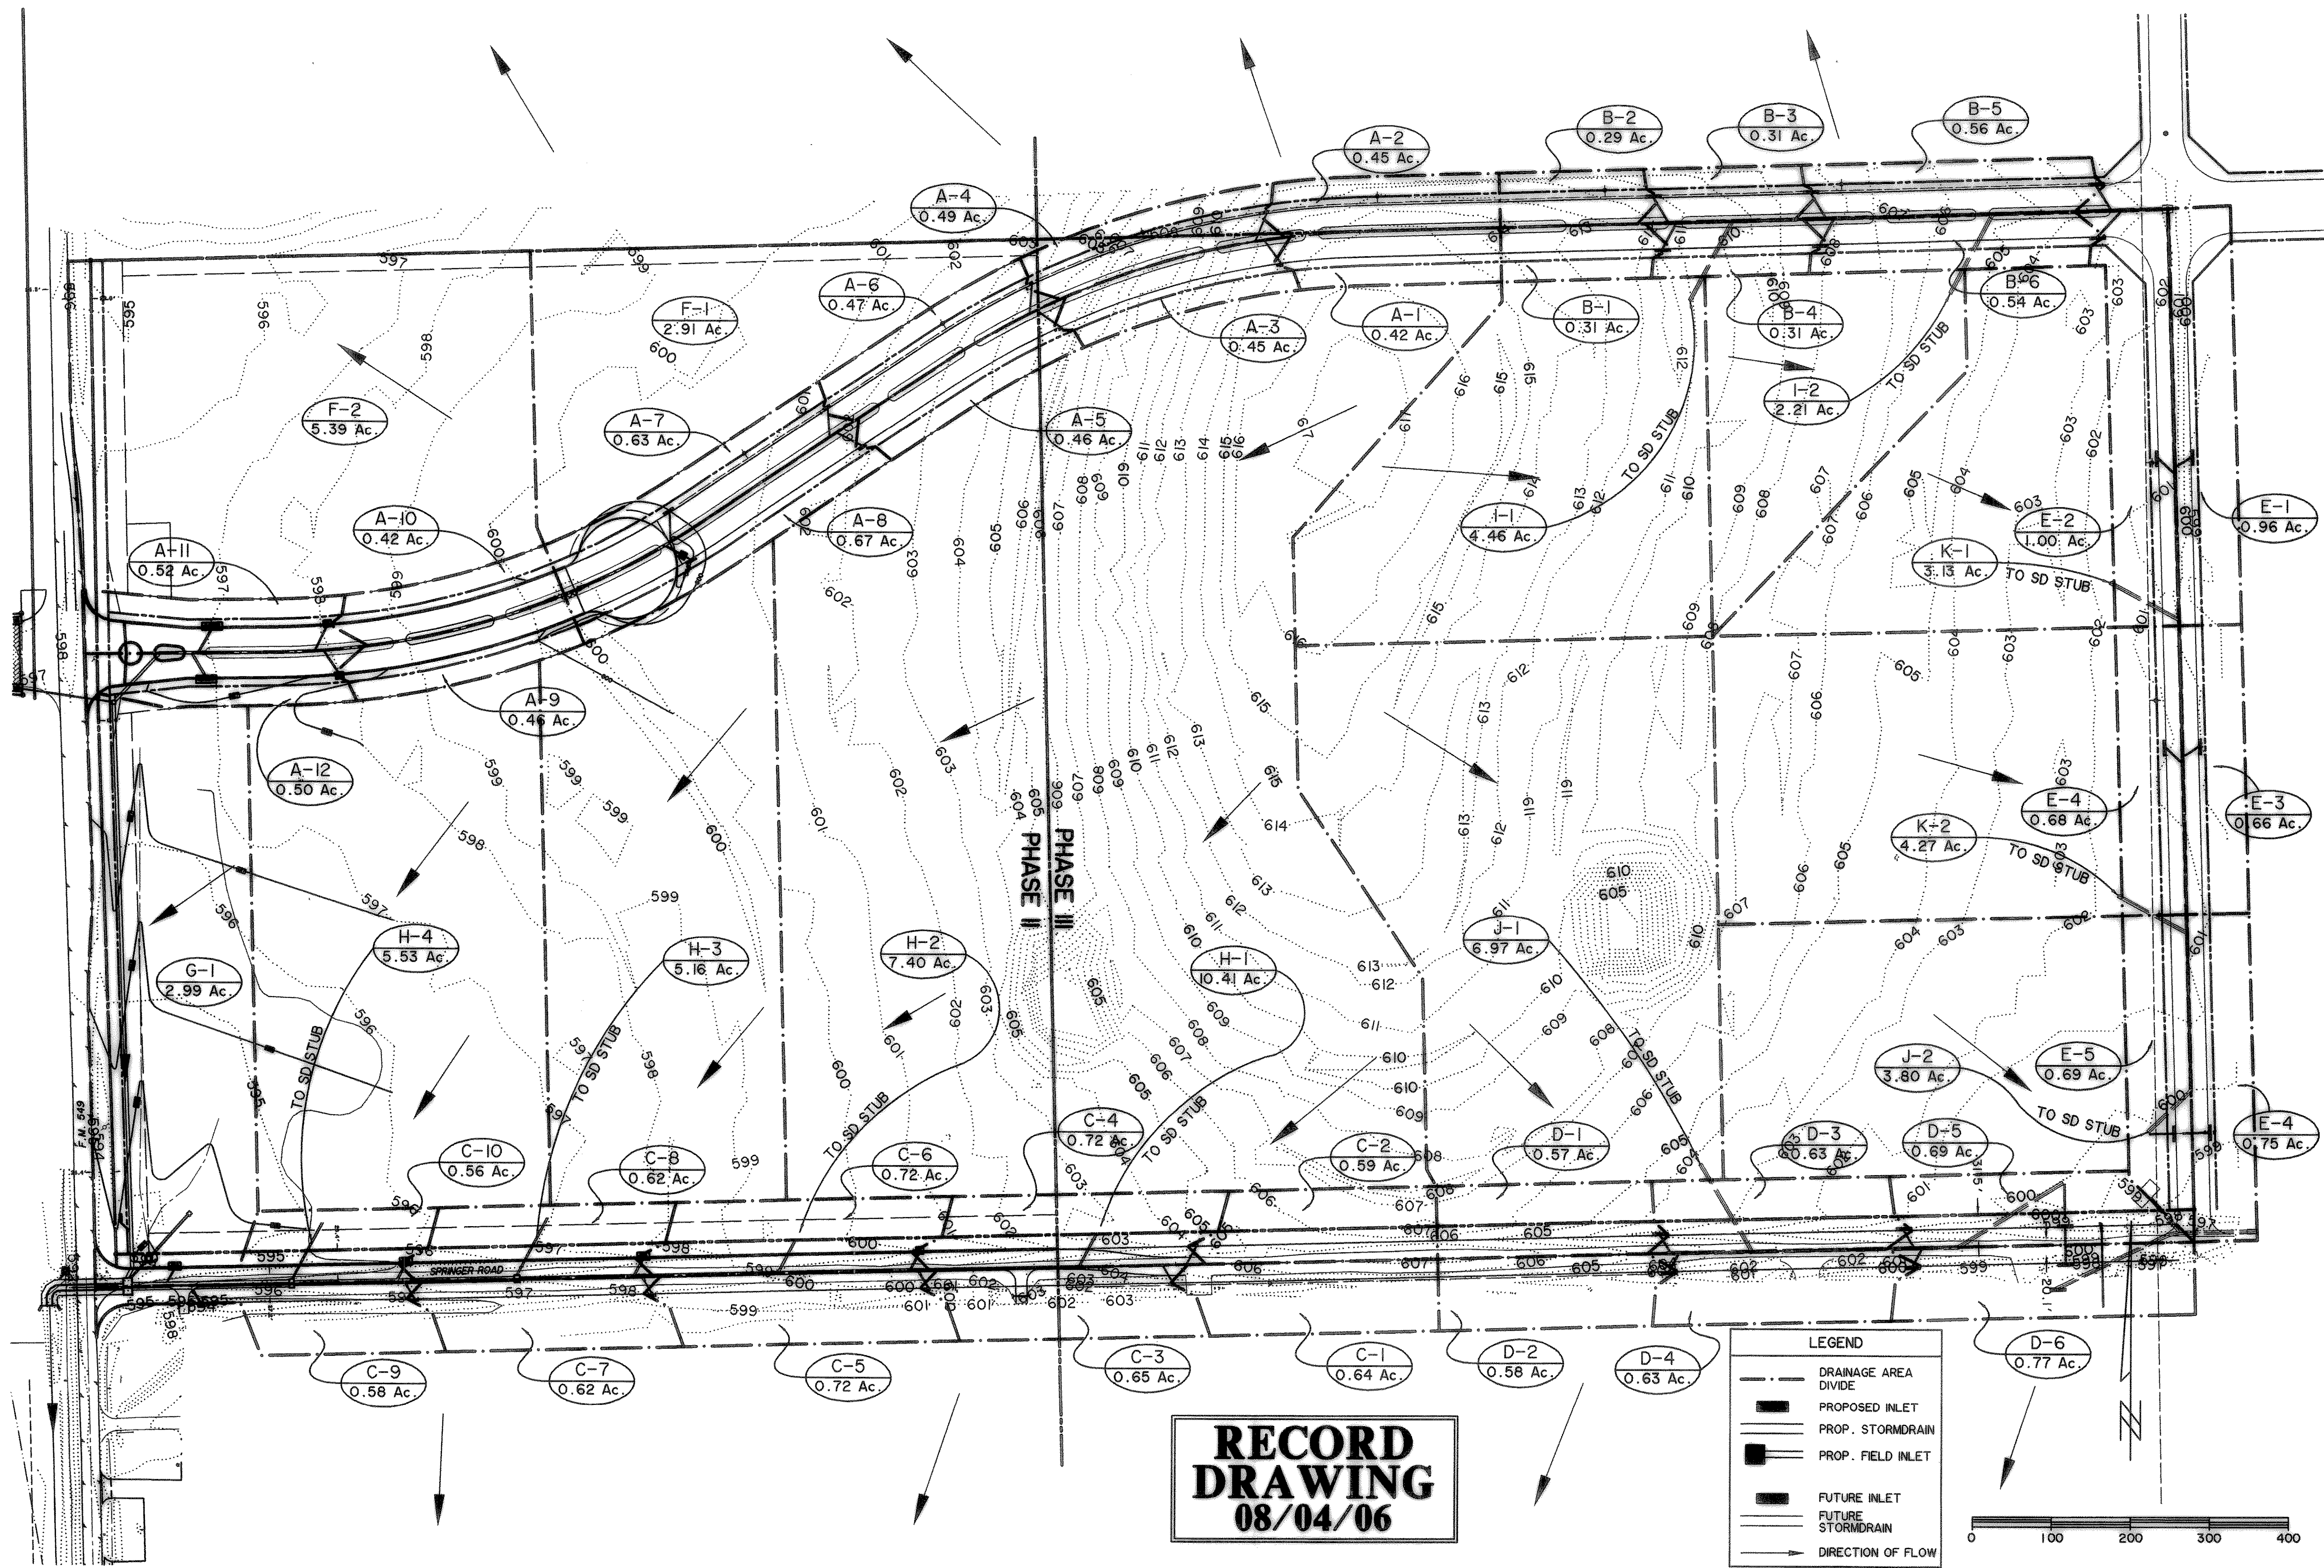


**RECORD
DRAWING**
08/04/06

LEGEND

	DRAINAGE AREA DIVIDE
	PROPOSED INLET
	PROP. STORMDRAIN
	PROP. FIELD INLET
	FUTURE INLET
	FUTURE STORMDRAIN
	DIRECTION OF FLOW



PREPARED BY:
WIA WIER & ASSOCIATES, INC.
 ENGINEERS SURVEYORS LAND PLANNERS
 4300 BELTWAY PLACE SUITE 130 ARLINGTON, TEXAS 76018 METRO (817)467-7700
 1380 U.S. HIGHWAY 287 N. SUITE 101 MANSFIELD, TEXAS 76063 METRO (817)477-0700
 6849 ELM STREET PRISCO, TEXAS 75304 METRO (214)387-6000
 www.wierassociates.com

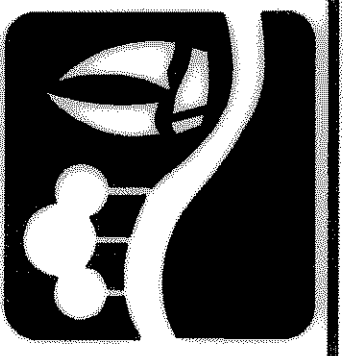

**ROCKWALL
TECHNOLOGY
PARK
PHASE II**

**OVERALL
DRAINAGE
AREA MAP**

STATE OF TEXAS
 RONALD RAMIREZ
 31821
 REGISTERED
 PROFESSIONAL ENGINEER
 Ronald Ramirez
 COPYRIGHT ©
 WIER & ASSOCIATES, INC.
 LAST SHEET EDIT
 DATE 08-18-2006
 WA# 98041
**SHEET NO.
D001**