

CAUTION !!!
UNDERGROUND UTILITIES

EXISTING UTILITIES AND UNDERGROUND FACILITIES INDICATED ON THESE PLANS HAVE BEEN LOCATED FROM REFERENCE INFORMATION SUPPLIED BY VARIOUS OWNERS OF THE FACILITIES. THE ENGINEER DOES NOT ACCEPT THE RESPONSIBILITY FOR THE UTILITY LOCATIONS SHOWN, IT SHALL BE THE RESPONSIBILITY OF THE CONTRACTOR TO VERIFY BOTH HORIZONTALLY AND VERTICALLY THE LOCATION OF ALL EXISTING UTILITIES AND UNDERGROUND FACILITIES PRIOR TO CONSTRUCTION, TO TAKE NECESSARY PRECAUTIONS IN ORDER TO PROTECT ALL FACILITIES ENCOUNTERED, AND TO NOTIFY THE ENGINEER PROMPTLY OF ALL CONFLICTS OF THE WORK WITH EXISTING FACILITIES. THE CONTRACTOR SHALL PRESERVE AND PROTECT ALL EXISTING UTILITIES FROM DAMAGE DURING CONSTRUCTION. ANY DAMAGE BY THE CONTRACTOR TO EXISTING UTILITIES SHALL BE REPAIRED BY THE CONTRACTOR AT HIS EXPENSE. CONTACT ALL POSSIBLE UTILITY AND UNDERGROUND FACILITY OWNERS.

- NOTES:**
- CONTRACTOR SHALL HAVE COPY OF TXDOT UTILITY CONSTRUCTION PERMITS ON SITE AT ALL TIMES. INFORM TXDOT INSPECTOR 48 HOURS PRIOR TO CONSTRUCTION
 - CONSTRUCT 10 L.F. OF CONCRETE ENCASEMENT WHERE S.S. STUB OUTS CROSS STORM DRAIN LINE

RECORD DRAWING
08/04/06

PHASE II
PHASE III

*** UTILITY LEGEND ***

	EXISTING WATER LINE		PROPOSED FIRE HYDRANT
	EXISTING WATER VALVE		PROPOSED WATER METER
	EXISTING WATER METER BOX		PROPOSED WATER VALVE
	EXISTING FIRE HYDRANT		PROPOSED WATER
	EXISTING LIGHT POLE		PROPOSED SEWER
	EXISTING POWER POLE		PROPOSED TELEPHONE
	EXIST. SANITARY SEWER MANHOLE		PROPOSED ELECTRIC
	EXISTING SANITARY SEWER		PROPOSED GAS
	CONCRETE STORM DRAIN PIPE		PROPOSED GAS METER
	EXISTING GAS LINE		W. L.
	EXISTING UNDERGROUND TELEPHONE		D. C. P.

BENCHMARKS:
CITY MON. NO. 2
LOCATED ON THE NORTHWEST CORNER OF THE BRIDGE AT I-30 AND F.M. 549
ELEVATION 609.56
"X" CUT IN THE CENTER OF A 4 FOOT HEADWALL LOCATED AT THE NORTHEAST CORNER OF F.M. 549 AND STATE HIGHWAY 276
ELEVATION 592.75

STA 12+58.48 SS LINE "B"
= 25.00' RT STA 12+58.26
SPRINGER RD.
END SS LINE B
INSTALL:
1 - 4' DIA. SSMH
5 L.F. 8" STUB EAST
WITH CAP
ℓ IN = 590.10
ℓ OUT = 602.91 +/-




PREPARED BY:
WIER & ASSOCIATES, INC.
ENGINEERS SURVEYORS LAND PLANNERS
4300 BELTWAY PLACE SUITE 130 ARLINGTON, TEXAS 76010 METRO (817) 467-7700
1380 U.S. HIGHWAY 281 N. SUITE 101 WASHINGTON, TEXAS 76093 METRO (817) 477-8700
6849 ELM STREET FRIEDCO, TEXAS 75034 METRO (214) 387-8000
www.wierassociates.com



ROCKWALL TECHNOLOGY PARK
PHASE II

SANITARY SEWER LAYOUT
LINES "A", "B" & "C"

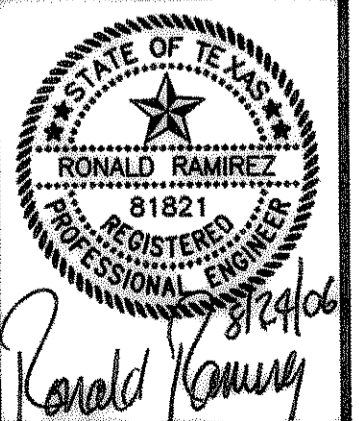

COPYRIGHT ©
WIER & ASSOCIATES, INC.
LAST SHEET EDIT
DATE 08-16-2006
WA# 38041

SHEET NO.
U102

TIME 18:59 FILE: I-SS-CHANGE-ORDER.dwg