


TIME: 01  
FILE: Slewing Plan.dwg

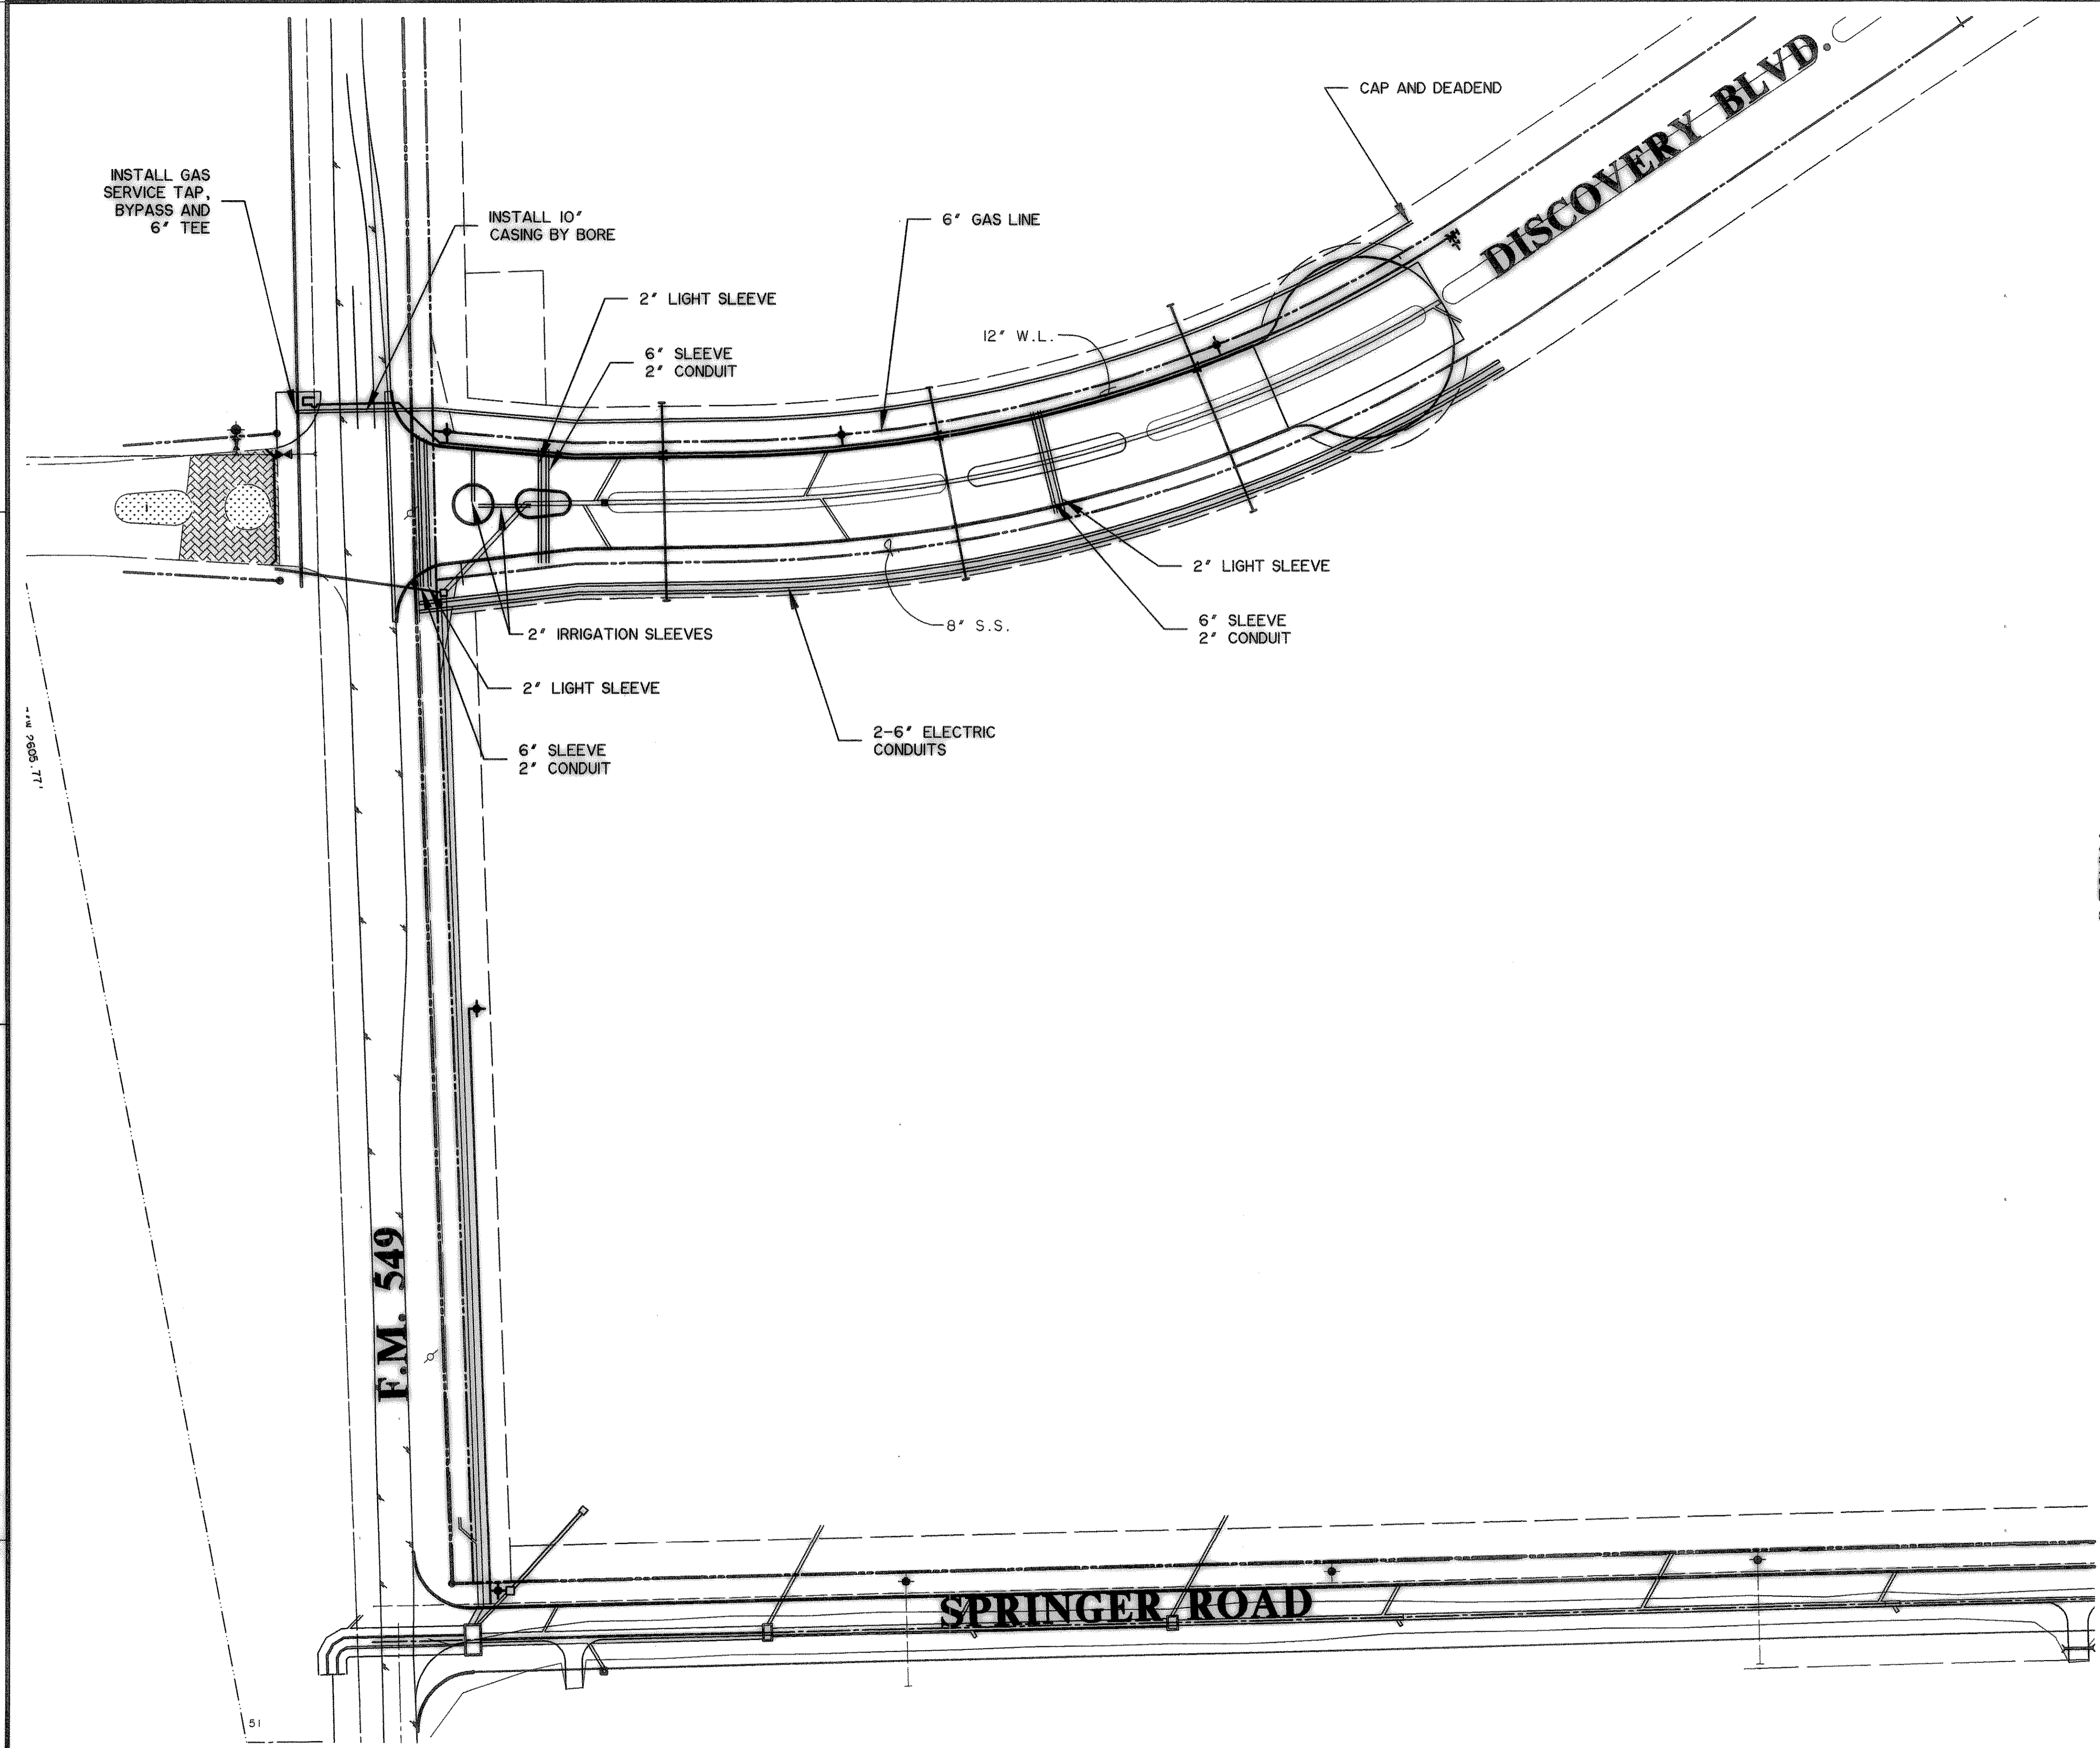

INSTALL GAS SERVICE TAP, BYPASS AND 6" TEE

INSTALL 10" CASING BY BORE

2" LIGHT SLEEVE

6" SLEEVE 2" CONDUIT

6" GAS LINE

12" W.L.

CAP AND DEADEND

DISCOVERY BLVD.

2" LIGHT SLEEVE

6" SLEEVE 2" CONDUIT

2" IRRIGATION SLEEVES

8" S.S.

2-6" ELECTRIC CONDUITS

2" LIGHT SLEEVE


6" SLEEVE 2" CONDUIT

F.M. 549

SPRINGER ROAD

PHASE II  
PHASE III

**RECORD  
DRAWING**  
08/04/06

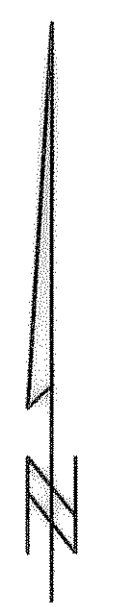


PREPARED BY:  
**WIA WIER & ASSOCIATES, INC.**  
 ENGINEERS SURVEYORS LAND PLANNERS  
 4300 BELTWAY PLACE SUITE 130 ARLINGTON, TEXAS 76018 METRO (817)467-7700  
 1380 U.S. HIGHWAY 287 N. SUITE 101 MANSFIELD, TEXAS 76063 METRO (817)477-6700  
 6849 ELM STREET FRISCO, TEXAS 75034 METRO (214)387-8000  
 www.wierassociates.com



**ROCK WALL  
TECHNOLOGY  
PARK  
PHASE II**

**SLEWING PLAN**

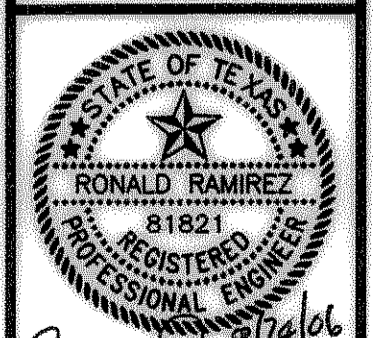

*Ronald Ramirez*

COPYRIGHT ©  
 WIER & ASSOCIATES, INC.  
 LAST SHEET EDIT  
 DATE 08-18-2006  
 WA# 98041

**SHEET NO.  
S101**