



TIME: 0:59 FILE: LAT1.dwg

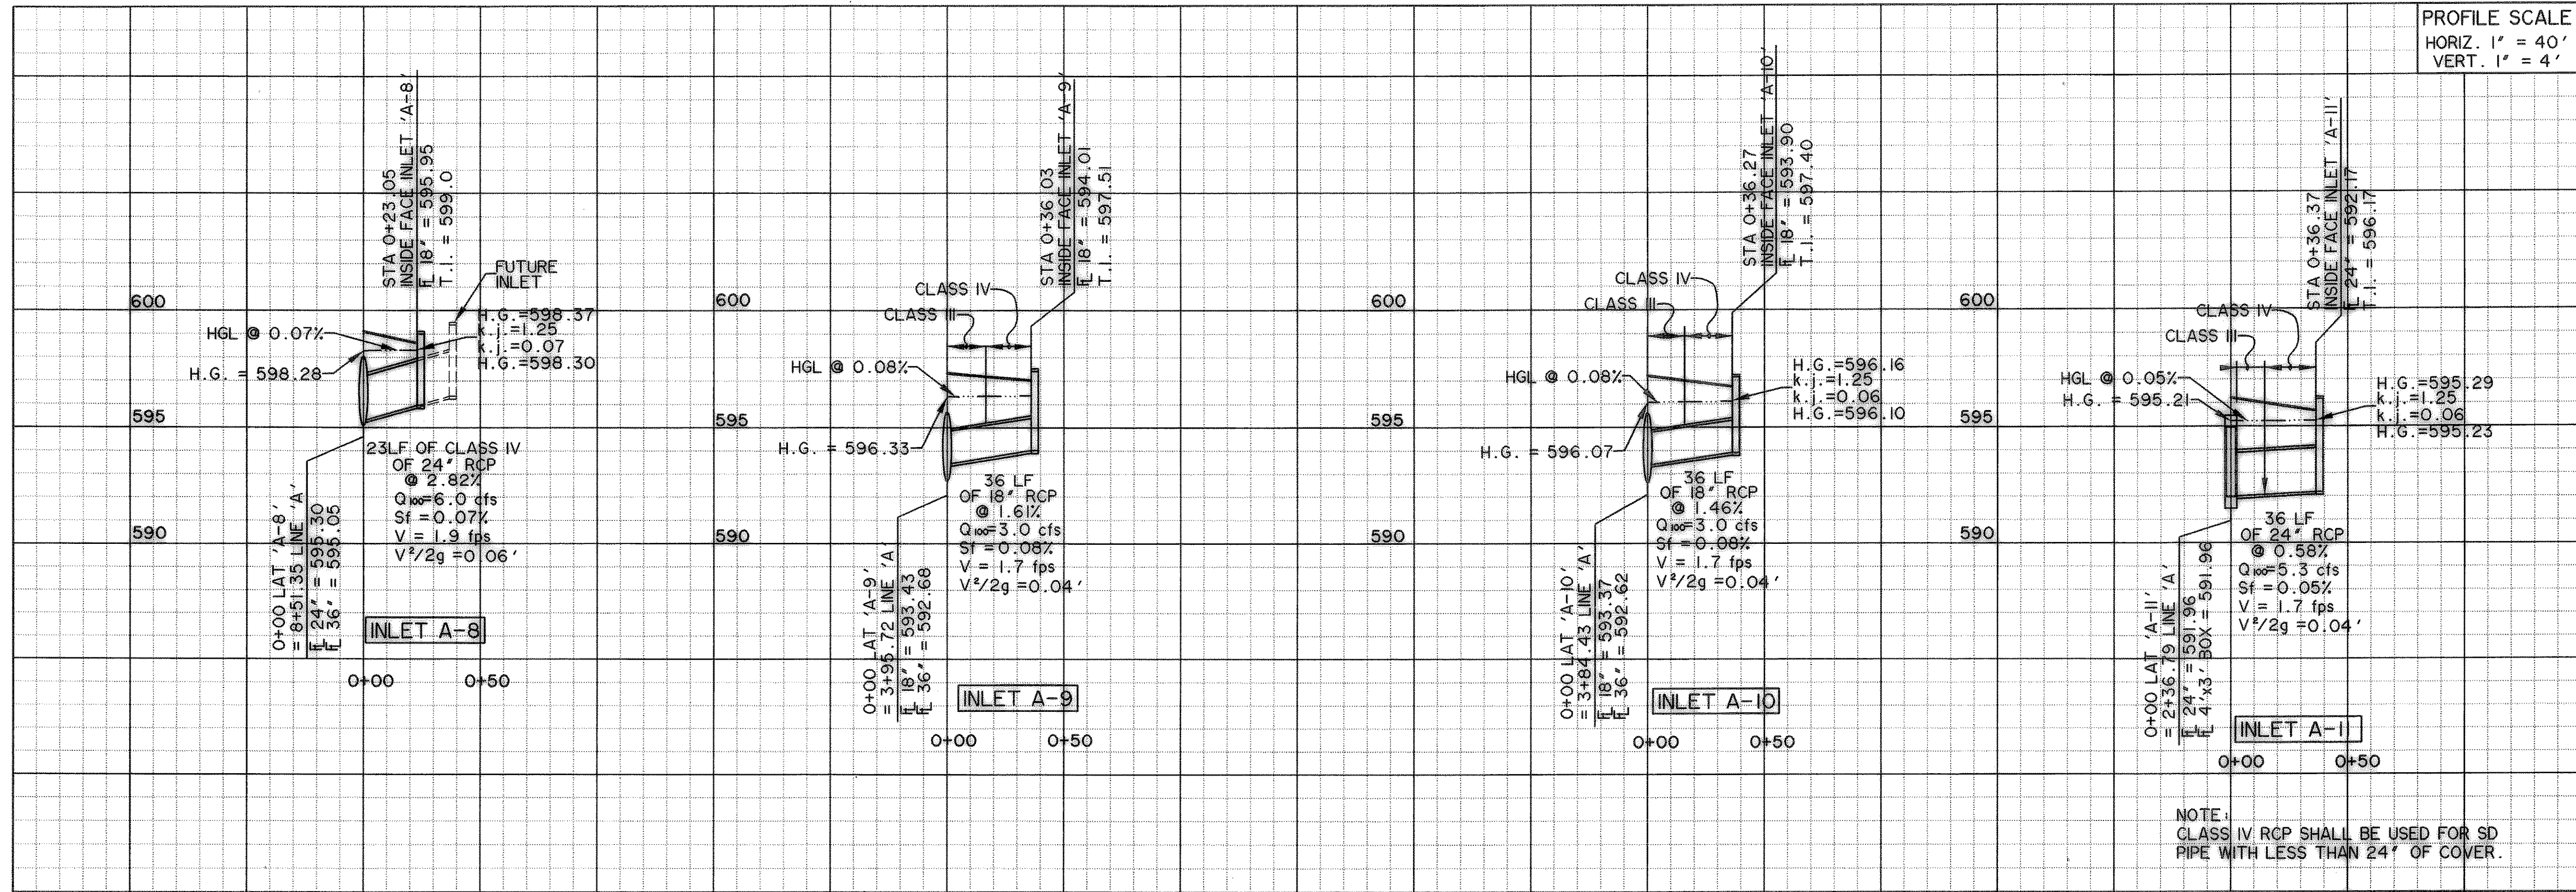

PROFILE SCALE
 HORIZ. 1" = 40'
 VERT. 1" = 4'

NOTE:
 CLASS IV RCP SHALL BE USED FOR SD
 PIPE WITH LESS THAN 24' OF COVER.

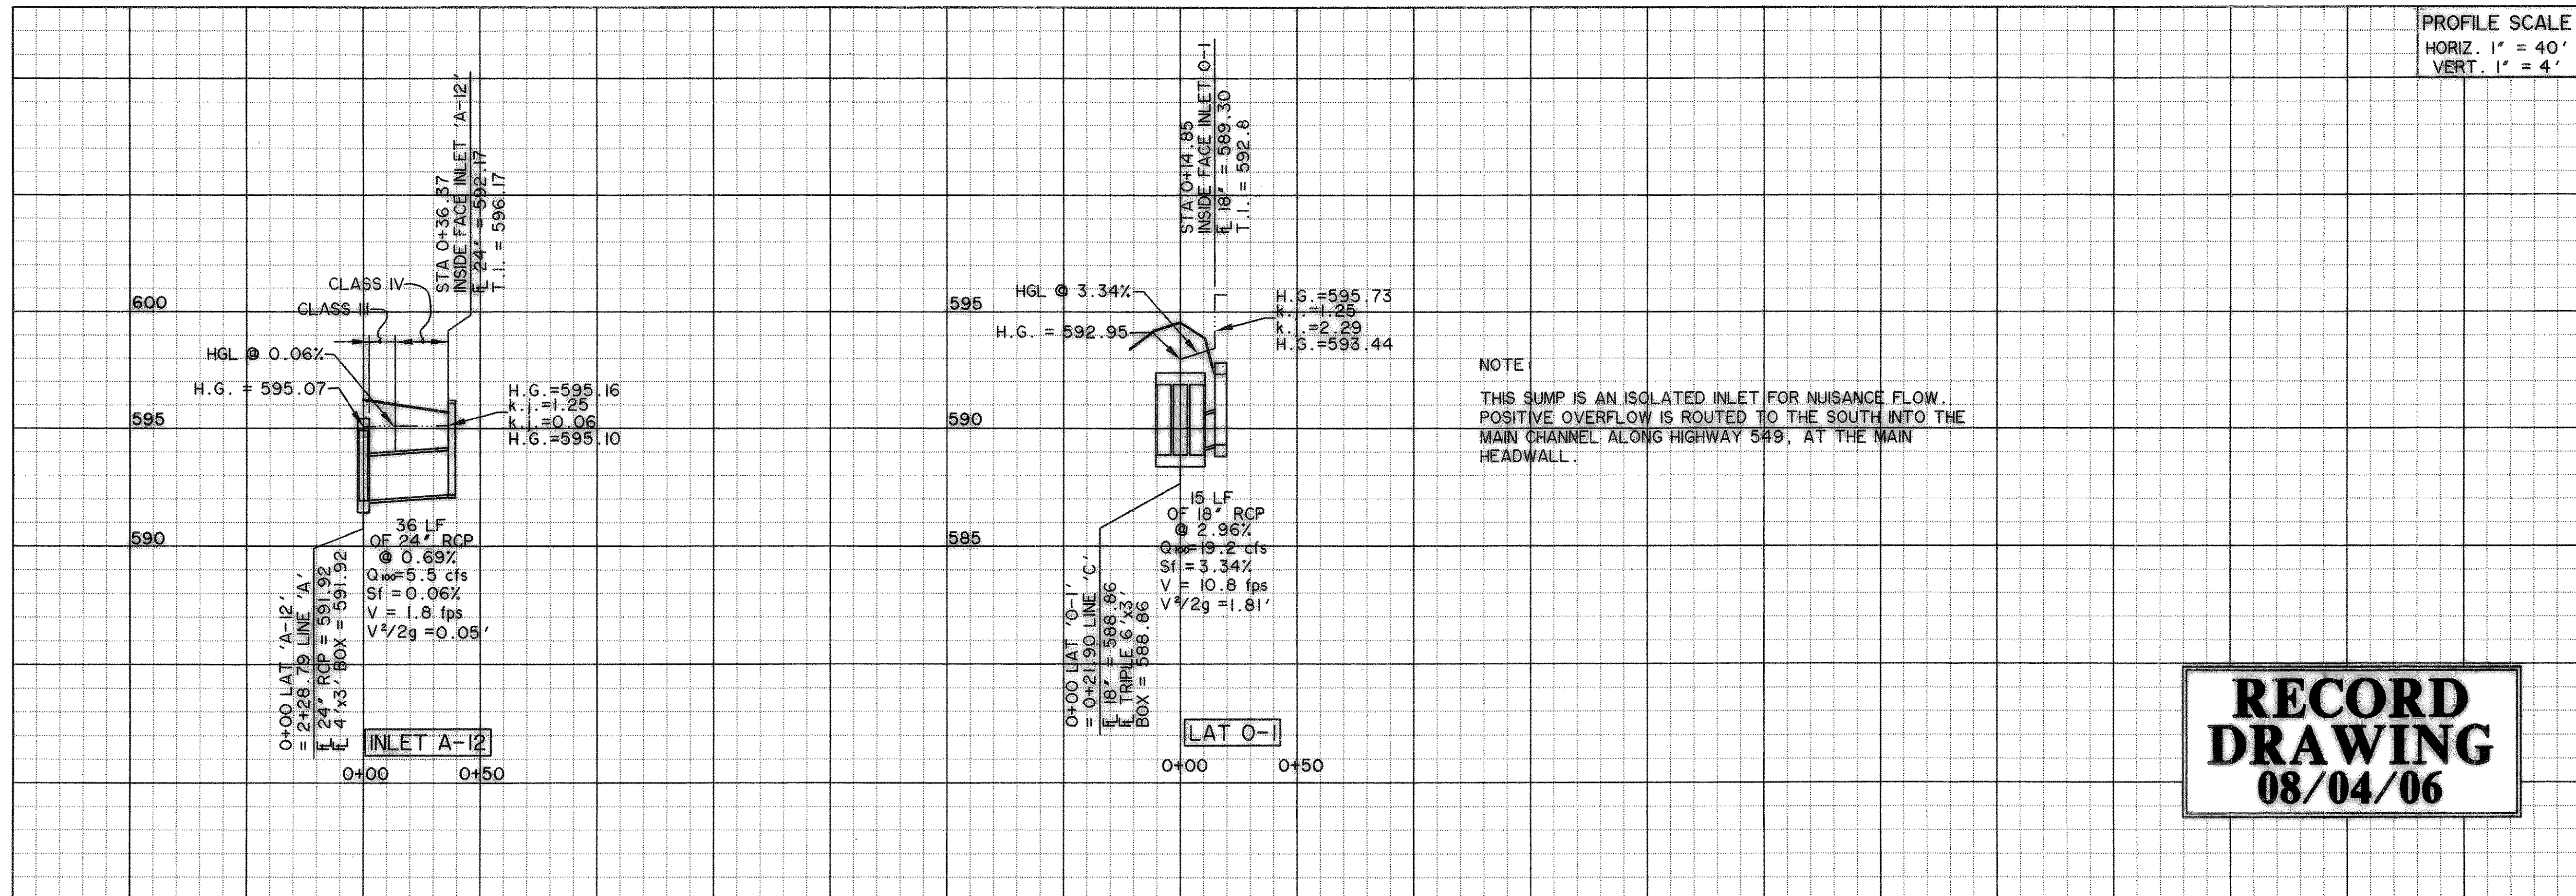


PROFILE SCALE
 HORIZ. 1" = 40'
 VERT. 1" = 4'

NOTE:
 THIS SUMP IS AN ISOLATED INLET FOR NUISANCE FLOW.
 POSITIVE OVERFLOW IS ROUTED TO THE SOUTH INTO THE
 MAIN CHANNEL ALONG HIGHWAY 549, AT THE MAIN
 HEADWALL.


**RECORD
 DRAWING**
 08/04/06

PREPARED BY:
VIA WIER & ASSOCIATES, INC.
ENGINEERS SURVEYORS LAND PLANNERS
 4300 BELTWAY PLACE SUITE 130 ARLINGTON, TEXAS 76018 METRO (817)467-7700
 1380 U.S. HIGHWAY 287 N. SUITE 101 MANSFIELD, TEXAS 76063 METRO (817)477-8700
 6849 ELM STREET FRODO, TEXAS 76034 METRO (214)387-8000
 www.viawier.com

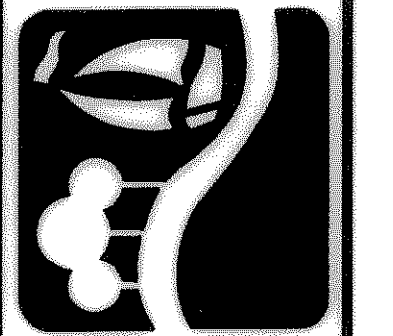

**ROCKWALL
 TECHNOLOGY
 PARK
 PHASE II**

**STORM DRAIN
 LATERALS
 LINE 'A' & LINE 'C'**

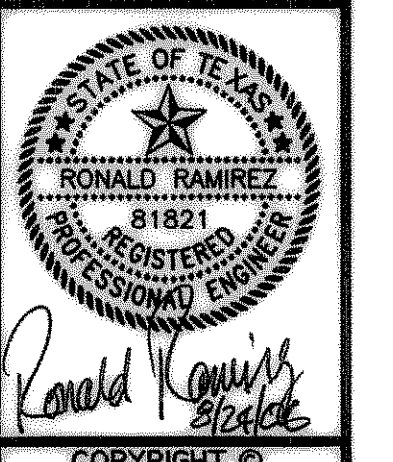

COPYRIGHT ©
 WIER & ASSOCIATES, INC.
 LAST SHEET EDIT
 DATE 08-18-2006
 WA# 98041
**SHEET NO.
 D401**