


PREPARED BY:  
**WIA WIER & ASSOCIATES, INC.**  
**ENGINEERS SURVEYORS LAND PLANNERS**  
 4300 BELLEVUE PLACE SUITE 130 ARLINGTON, TEXAS 76018 METRO (817)467-7700  
 1380 U.S. HIGHWAY 287 N. SUITE 101 WANSFELD, TEXAS 76063 METRO (817)477-8700  
 6849 ELM STREET, SUITE 75034 METRO (214)387-8000  
 www.wierassociates.com




**ROCKWALL TECHNOLOGY PARK PHASE II**

**STORM DRAIN PLAN AND PROFILE LINE 'A'**

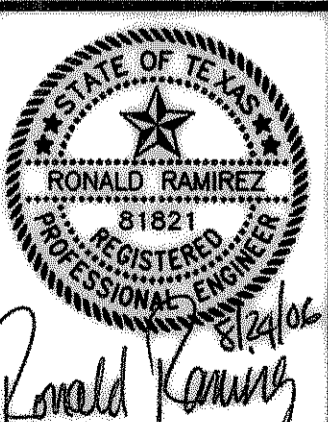

COPYRIGHT ©  
 WIER & ASSOCIATES, INC.  
 LAST SHEET EDIT  
 DATE 08-18-2006  
 WA# 98041  
**SHEET NO. D301**

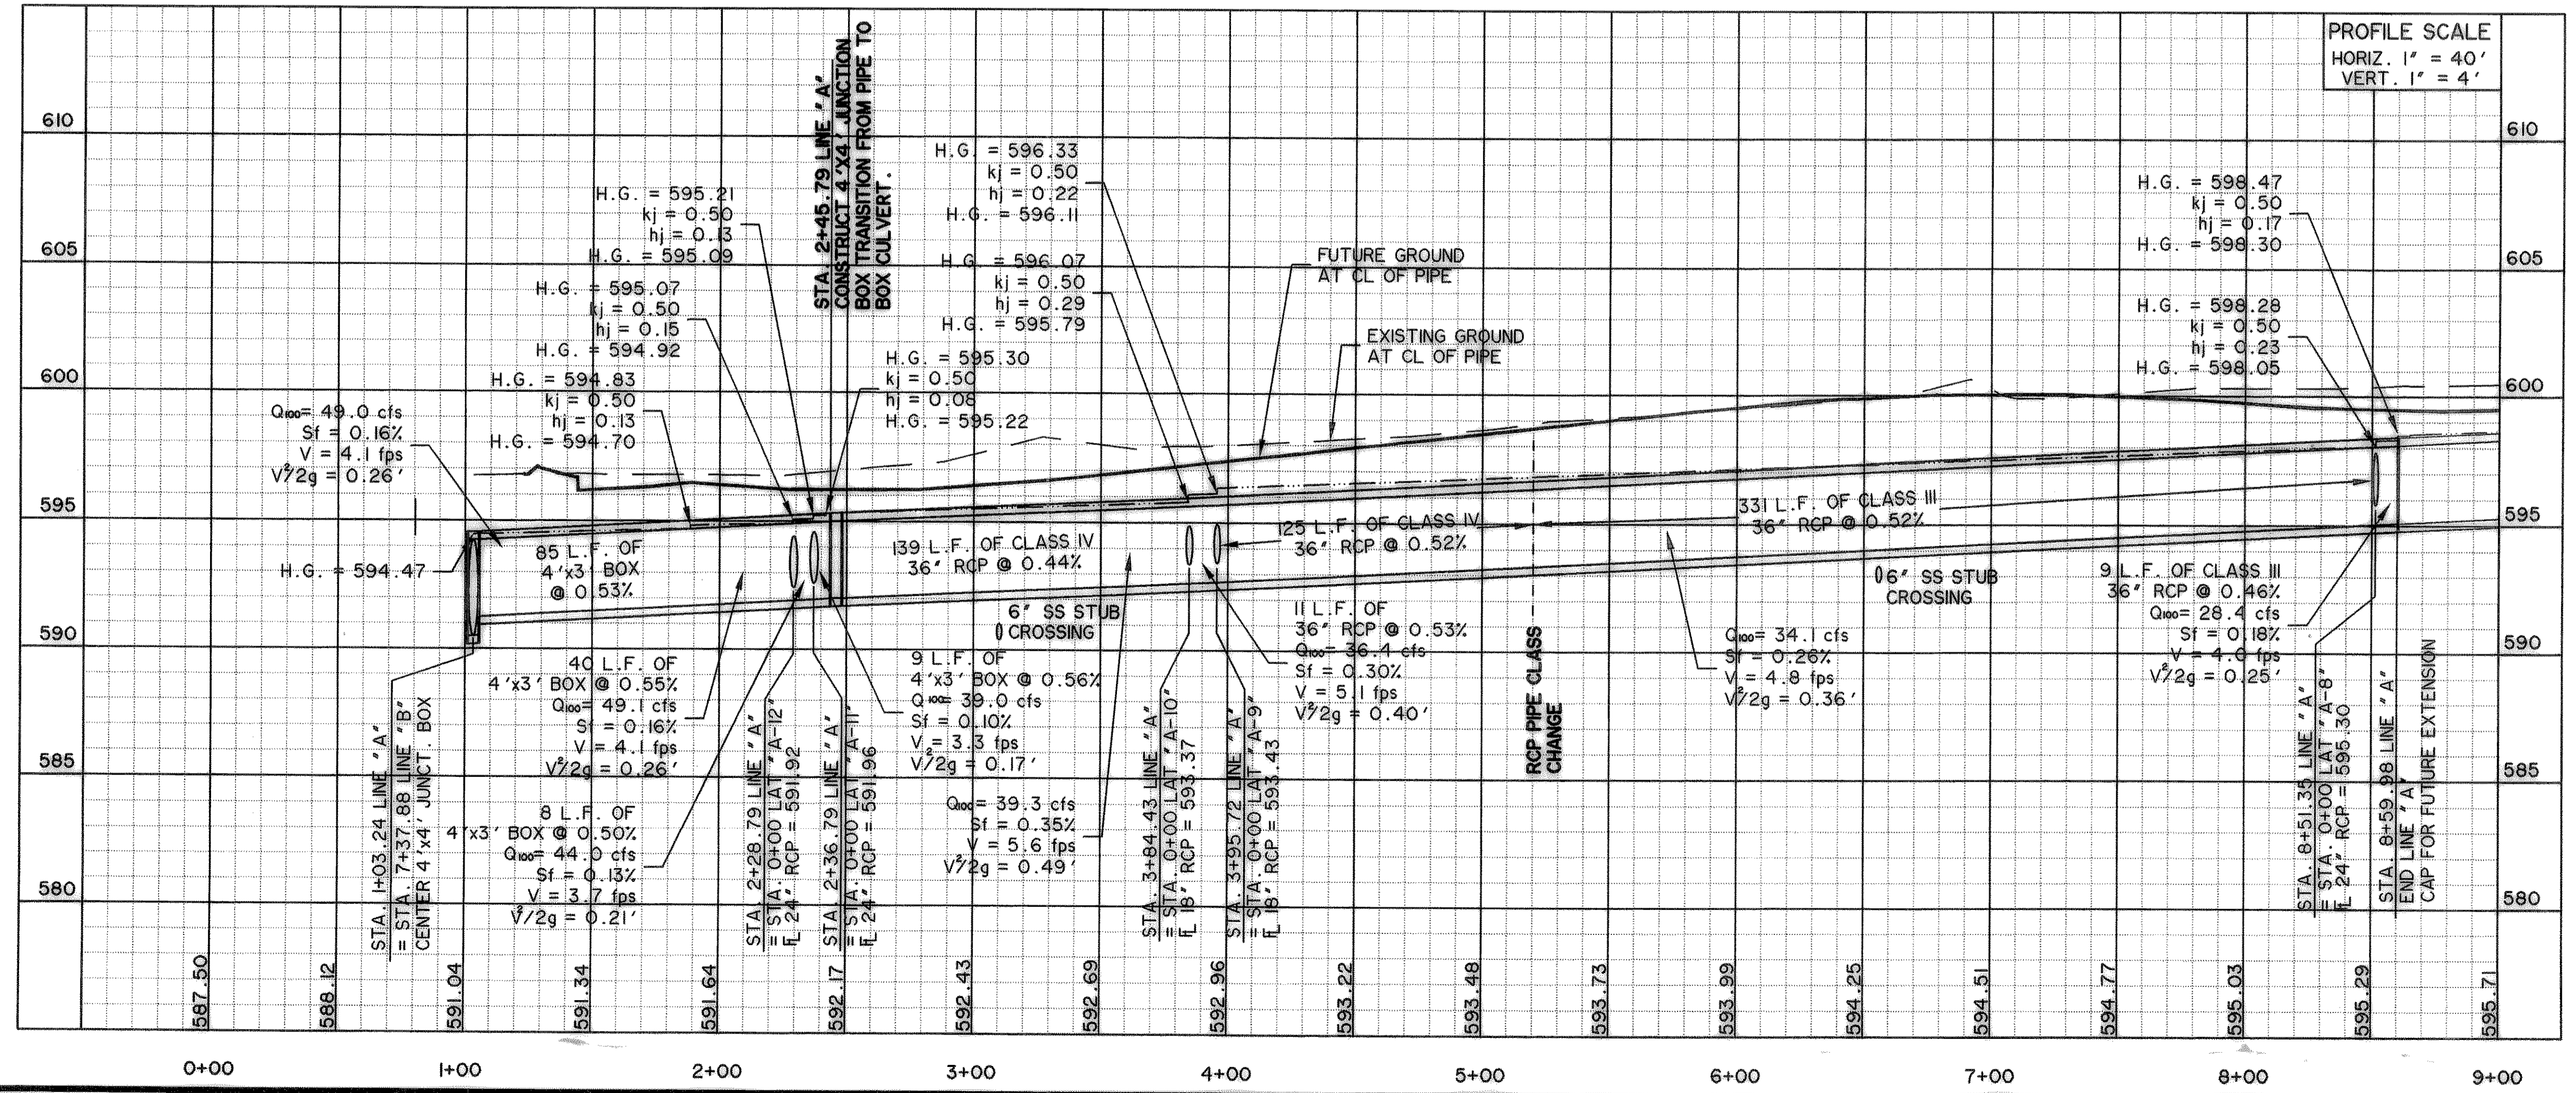

TIME: 8:56 FILE: STORM1.dwg