

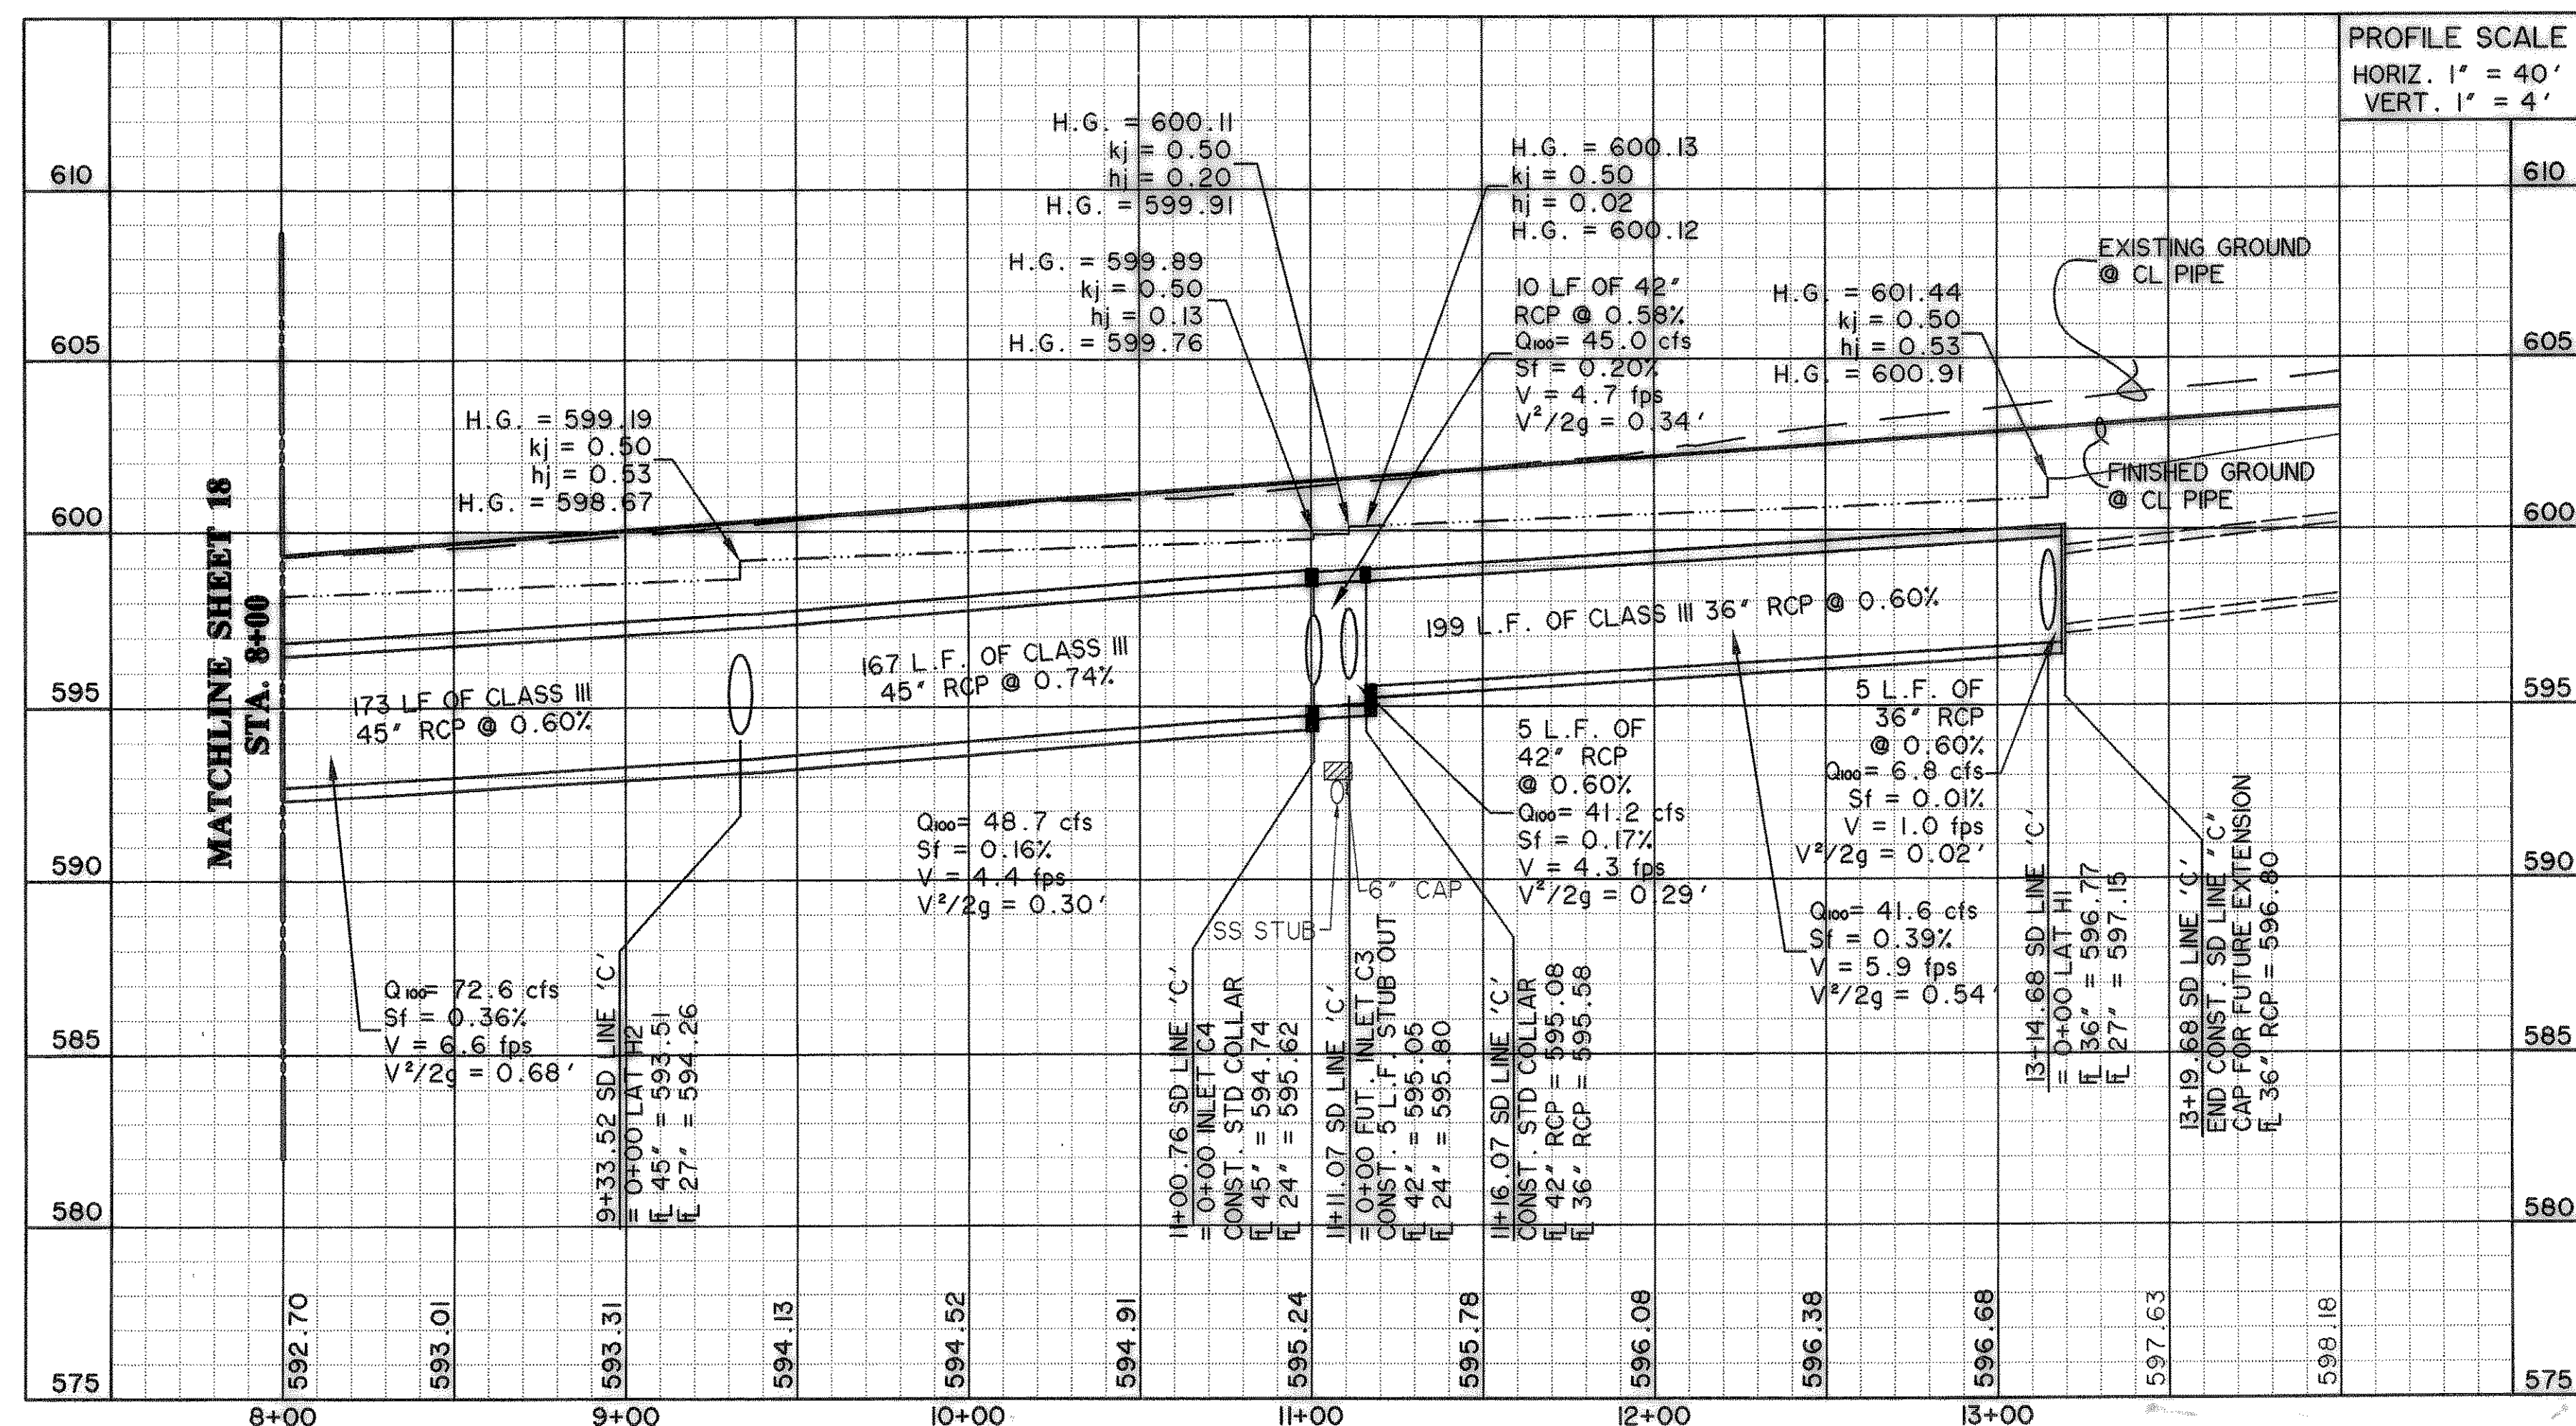
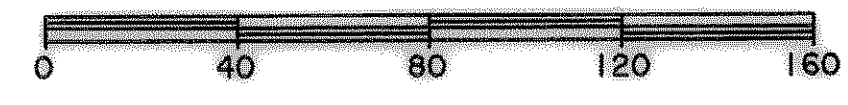


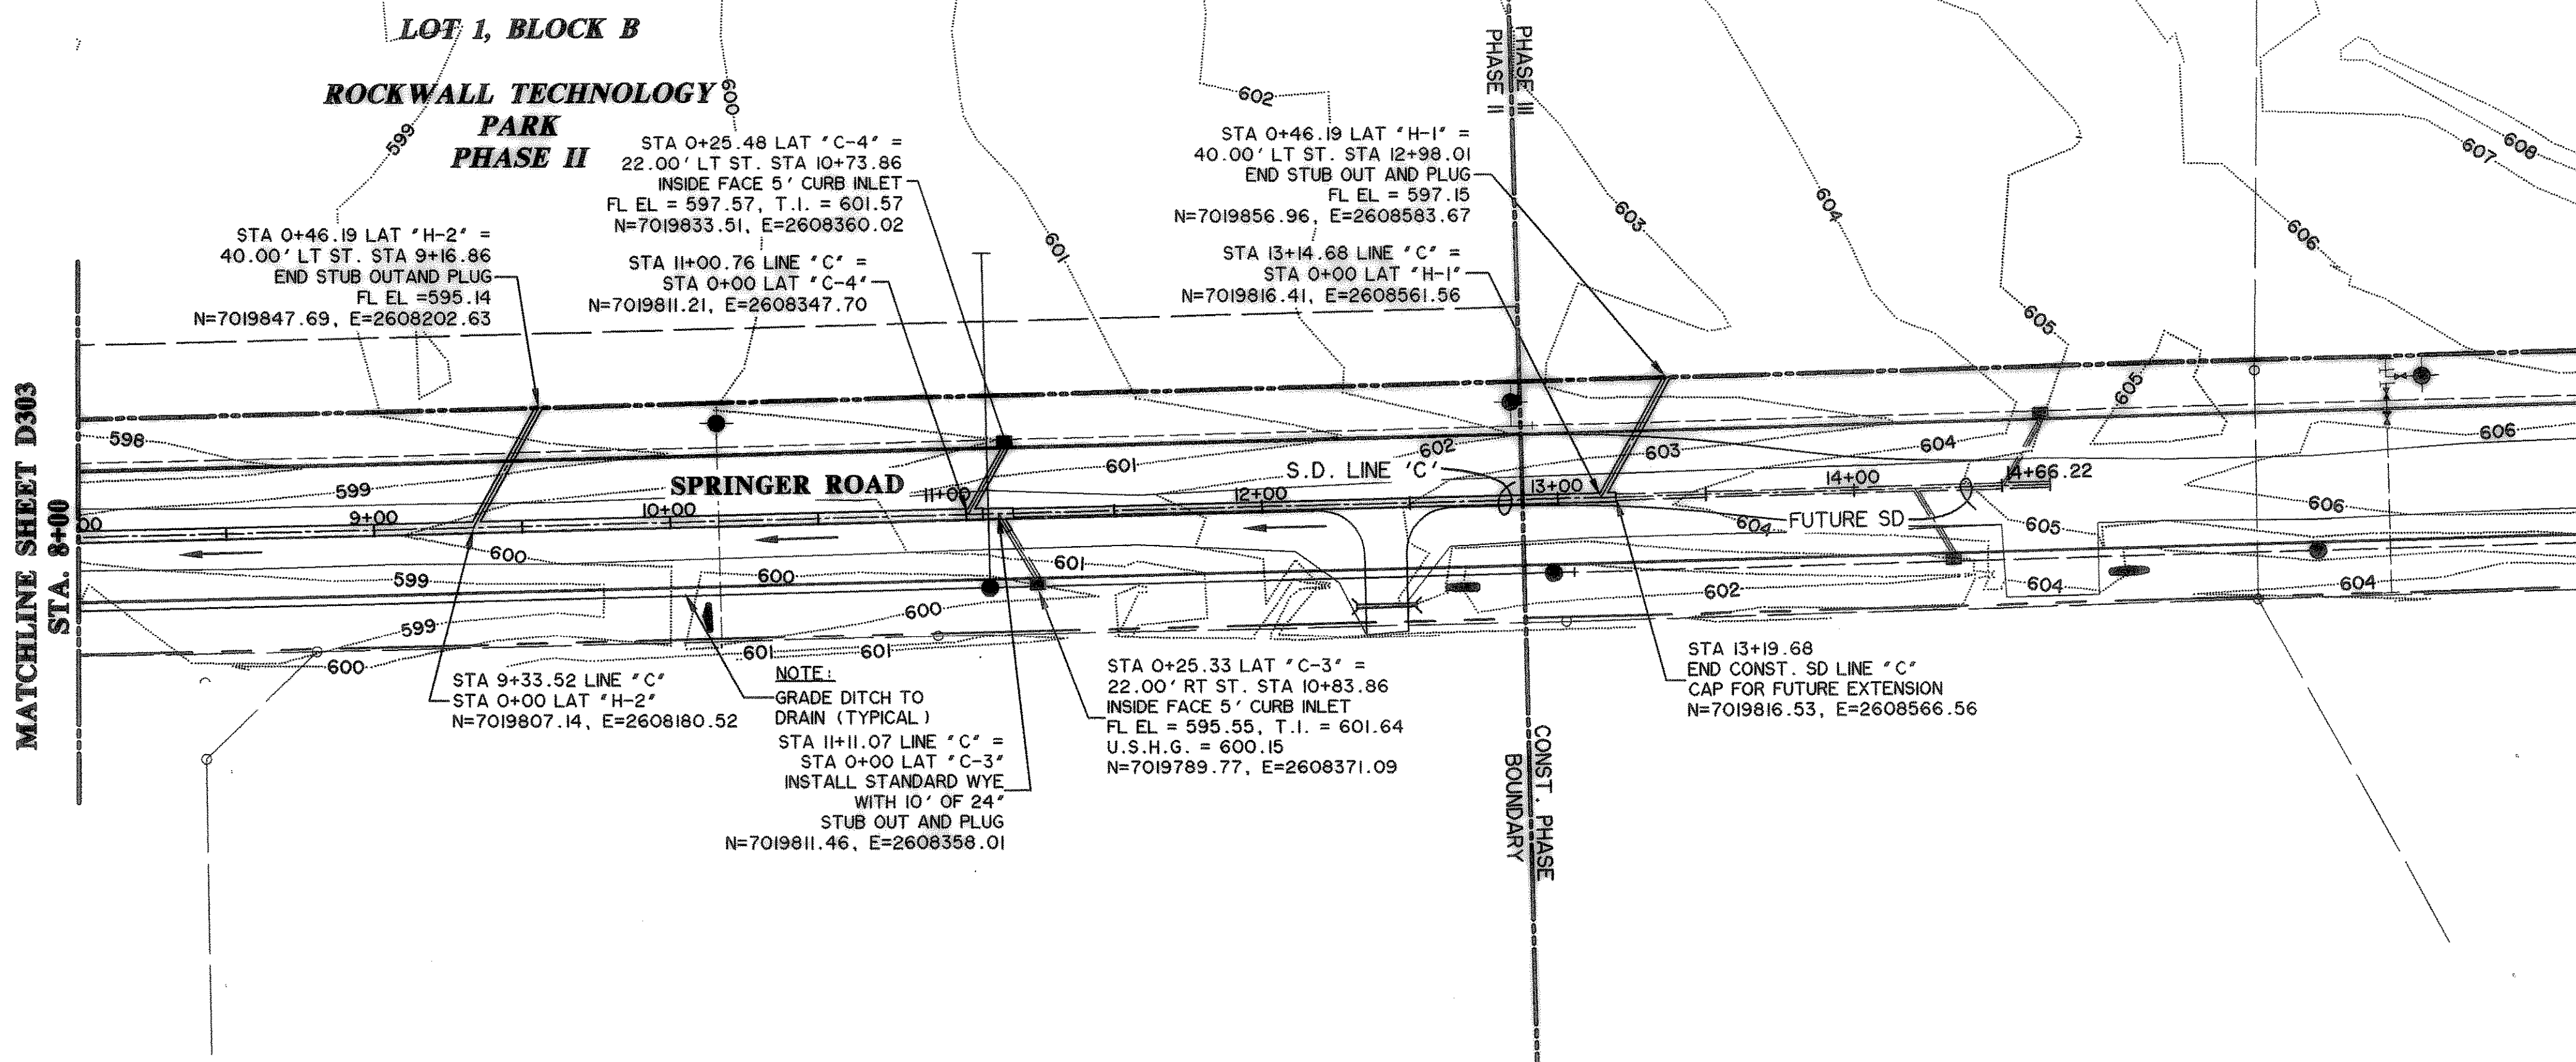

**ROCKWALL TECHNOLOGY PARK PHASE II**

**STORM DRAIN PLAN AND PROFILE LINE 'C' STA. 8+00 TO 13+19.68**

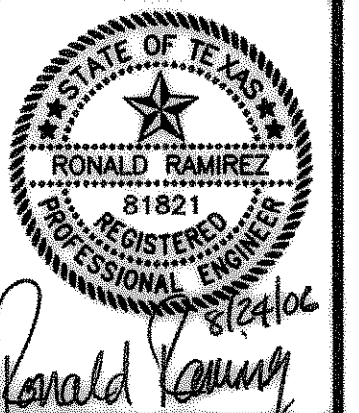

**RECORD DRAWING**  
 08/04/06