
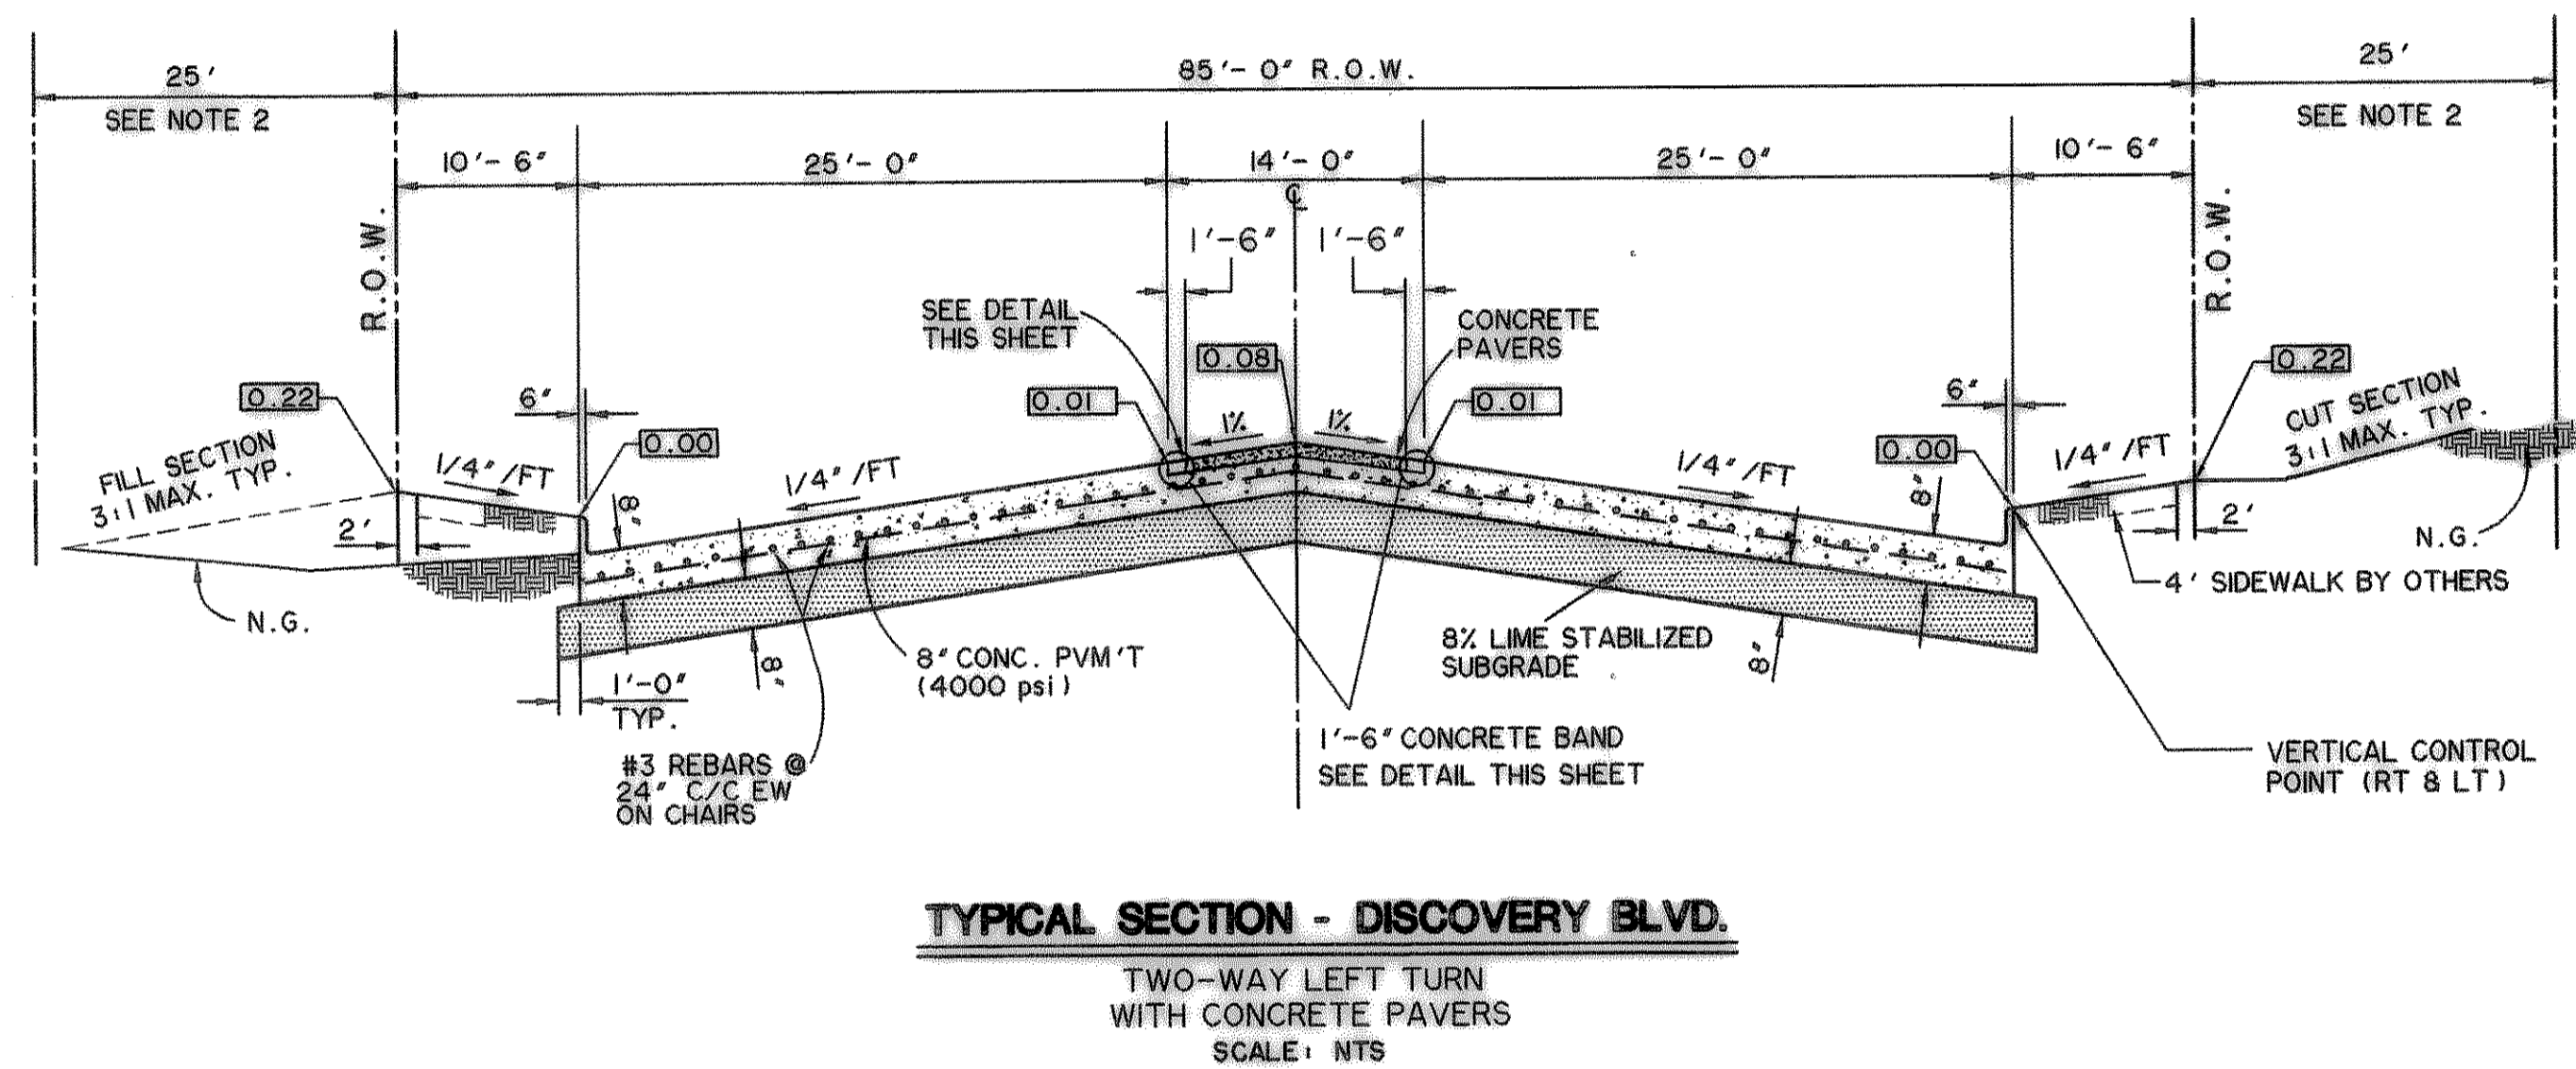



- NOTE:
1. CONTRACTOR SHALL COORDINATE COLOR AND TYPE OF PAVER WITH THE ARCHITECT AND ENGINEER. SUBMITTAL TO THE ARCHITECT AND ENGINEER IS REQUIRED PRIOR TO ORDERING THE MATERIAL.
 2. ALL CONSTRUCTION SHALL CONFORM TO THE CITY OF ROCKWALL STANDARD CONSTRUCTION DETAILS. TYPICAL SECTIONS ARE REPLACED BY THOSE SHOWN ON THIS SHEET.
 3. PLACE MIN. 4" TOPSOIL FROM ON SITE SOURCE IN PARK WAYS, SLOPES, AND DISTURBED AREAS. HYDROMULCH SEED WITH BERMUDA GRASS PER SPECIFICATIONS.
 4. ALL FILLS SHALL BE COMPACTED TO 95% MIN. PROCTOR DENSITY. FILLS SHALL BE PLACED IN 8" MAXIMUM LIFTS, AND COMPACTION SHALL BE ACCOMPLISHED BY THE USE OF A SHEEPS-FOOT ROLLER.

**RECORD
DRAWING
08/04/06**


- NOTES: 0.50 1. DENOTES DISTANCE IN DECIMAL FEET ABOVE PROFILE GRADE LT. & RT.
2. A 25' LANDSCAPE, PEDESTRIAN, AND UTILITY EASEMENT IS PROVIDED ALONG INTERIOR STREETS (REFER TO PLAT). THIS IS TO ALLOW FOR AN AESTHETIC MEANDERING SIDEWALK TO BE CONSTRUCTED BY THE DEVELOPER. IN NO CASE WILL THE SIDEWALK BE PLACED ANY MORE THAN 2' IN THE RIGHT-OF-WAY.

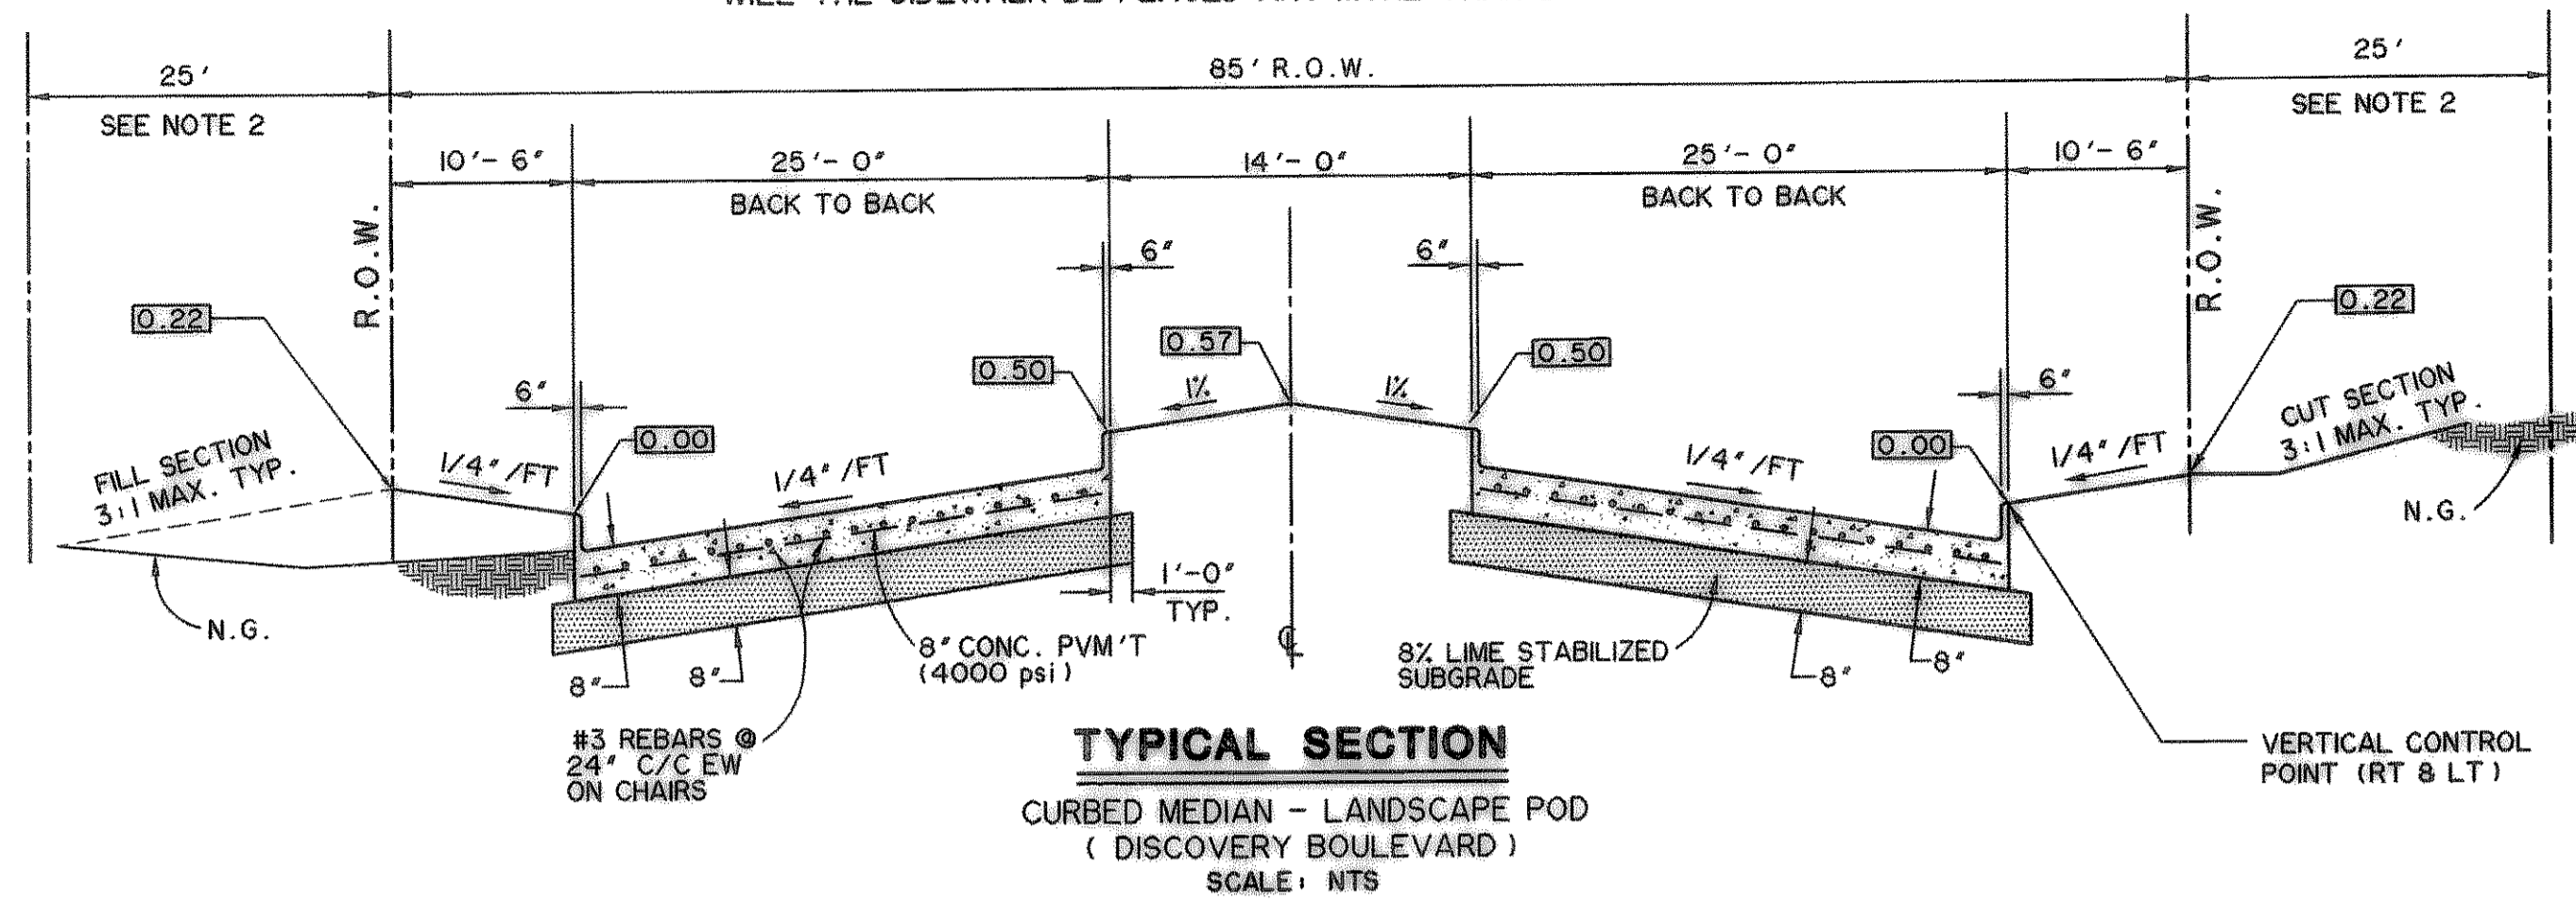

* SEE SHEET No. 3 FOR PAVEMENT NOTES

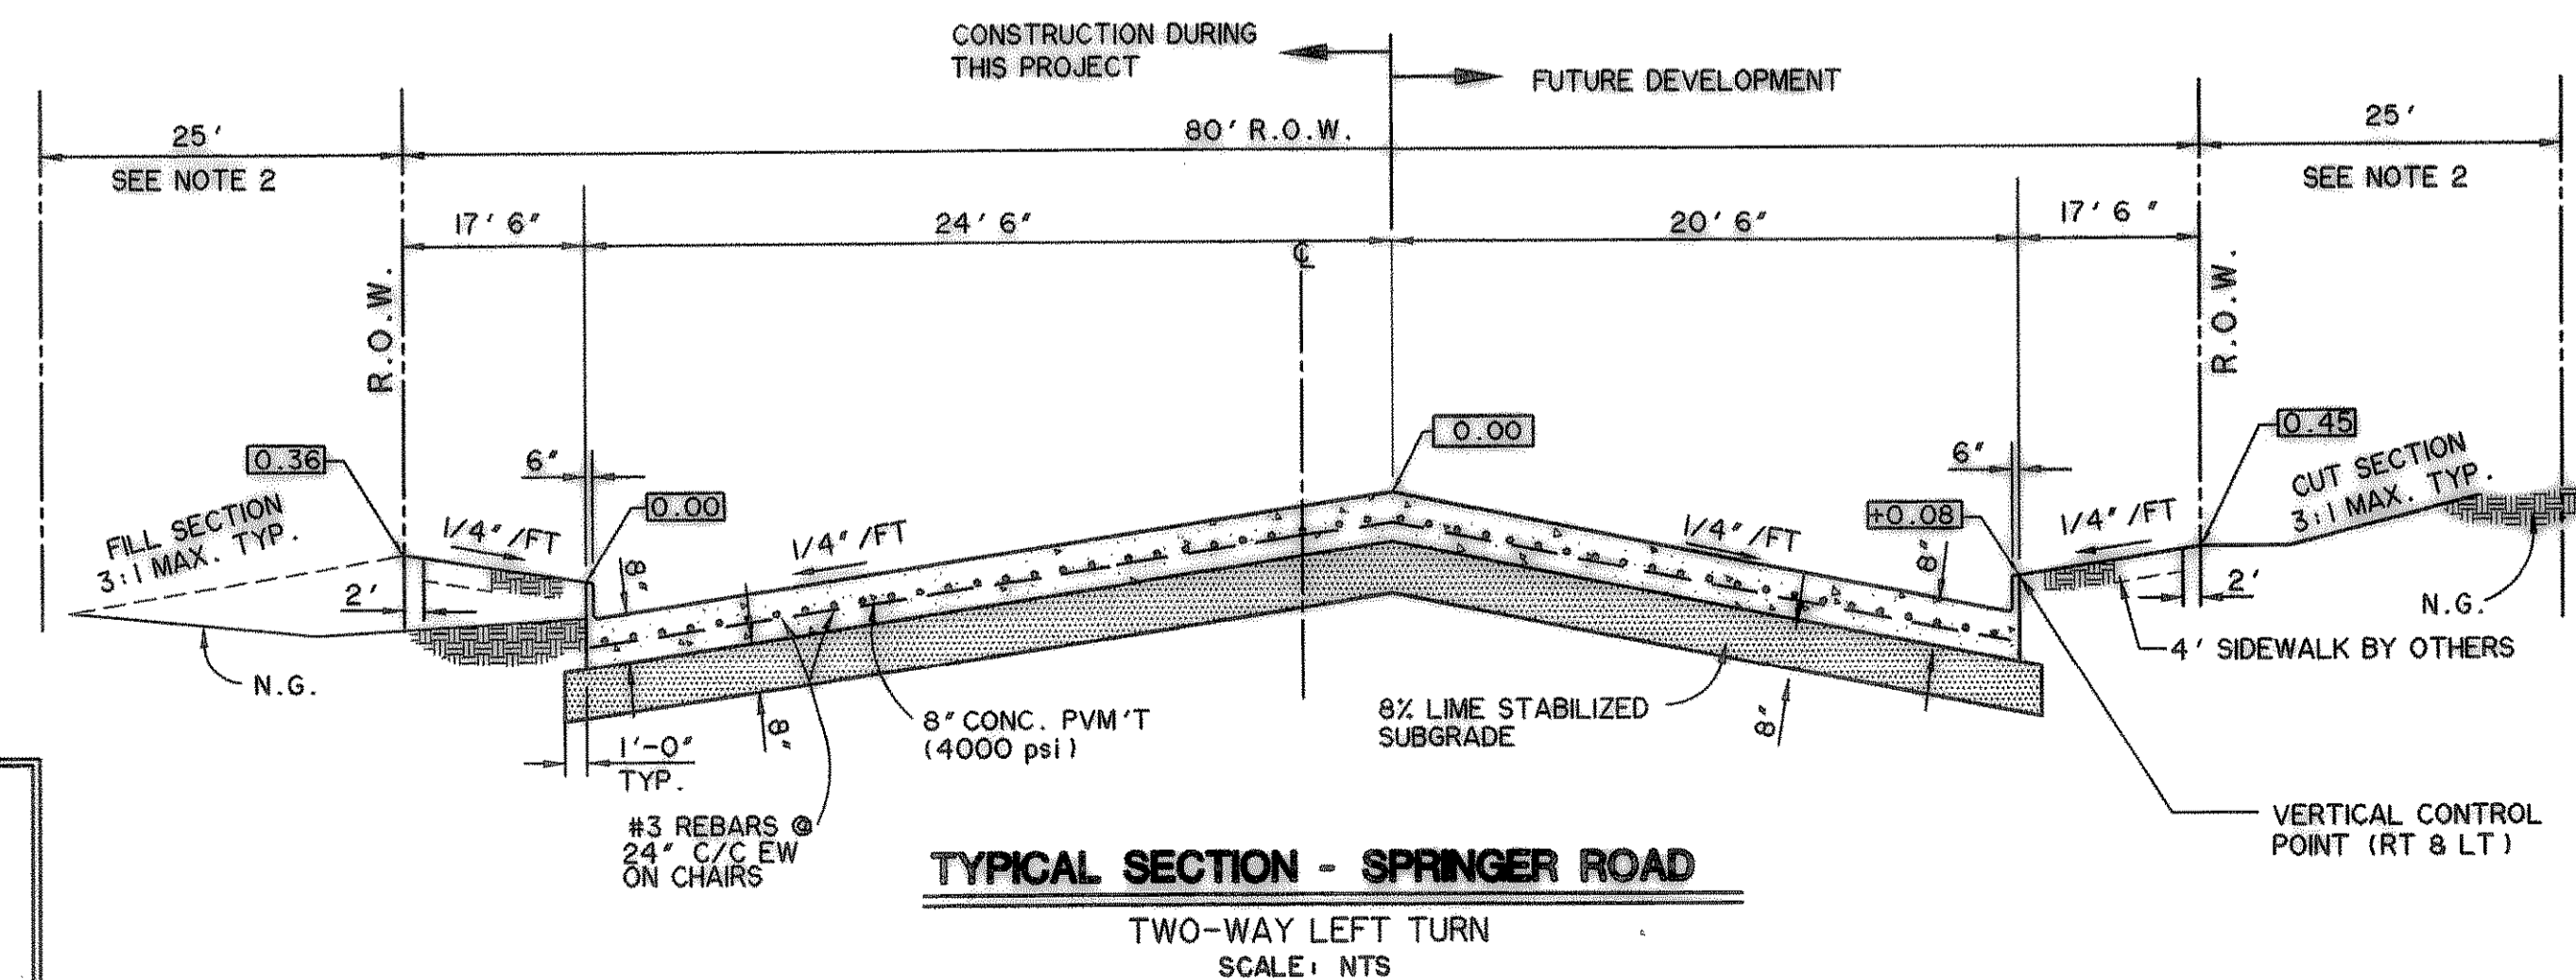


PREPARED BY:
WIER & ASSOCIATES, INC.
 ENGINEERS SURVEYORS LAND PLANNERS
 4300 RELIANCE PLACE SUITE 130 ARLINGTON, TEXAS 76018 METRO (817)467-7700
 1380 U.S. HIGHWAY 287 N. SUITE 101 MANSFIELD, TEXAS 76063 METRO (817)477-8700
 6848 ELM STREET FORTCO, TEXAS 75084 METRO (214)387-8800
 www.wierassociates.com

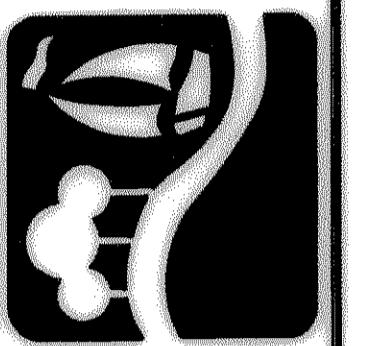

**ROCKWALL
TECHNOLOGY
PARK
PHASE II**

**TYPICAL
SECTIONS**

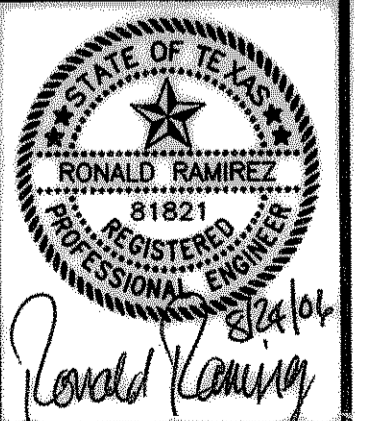

COPYRIGHT ©
 WIER & ASSOCIATES, INC.
 LAST SHEET EDIT
 DATE 08-18-2006
 WAR 96041

**SHEET NO.
P001**