



LAT. 'A1'

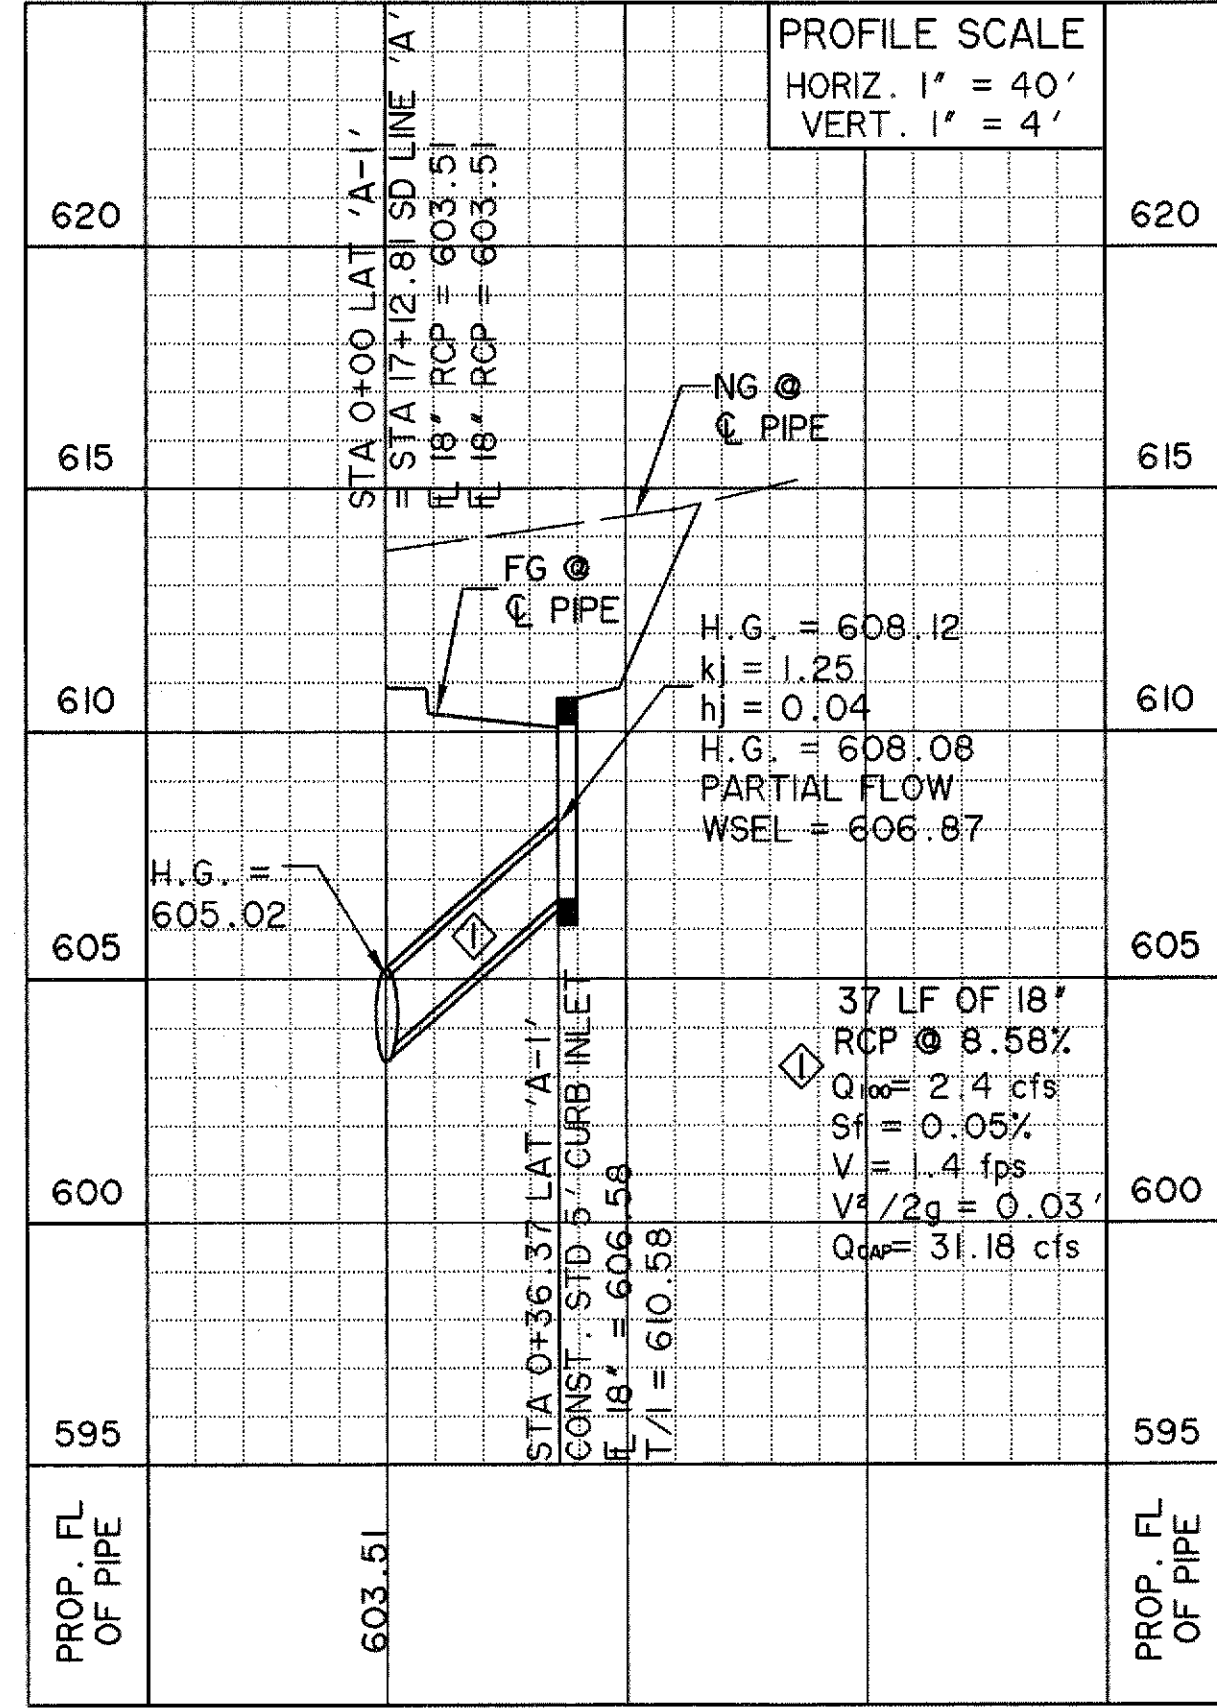


0+00 1+00

LAT. 'A2'

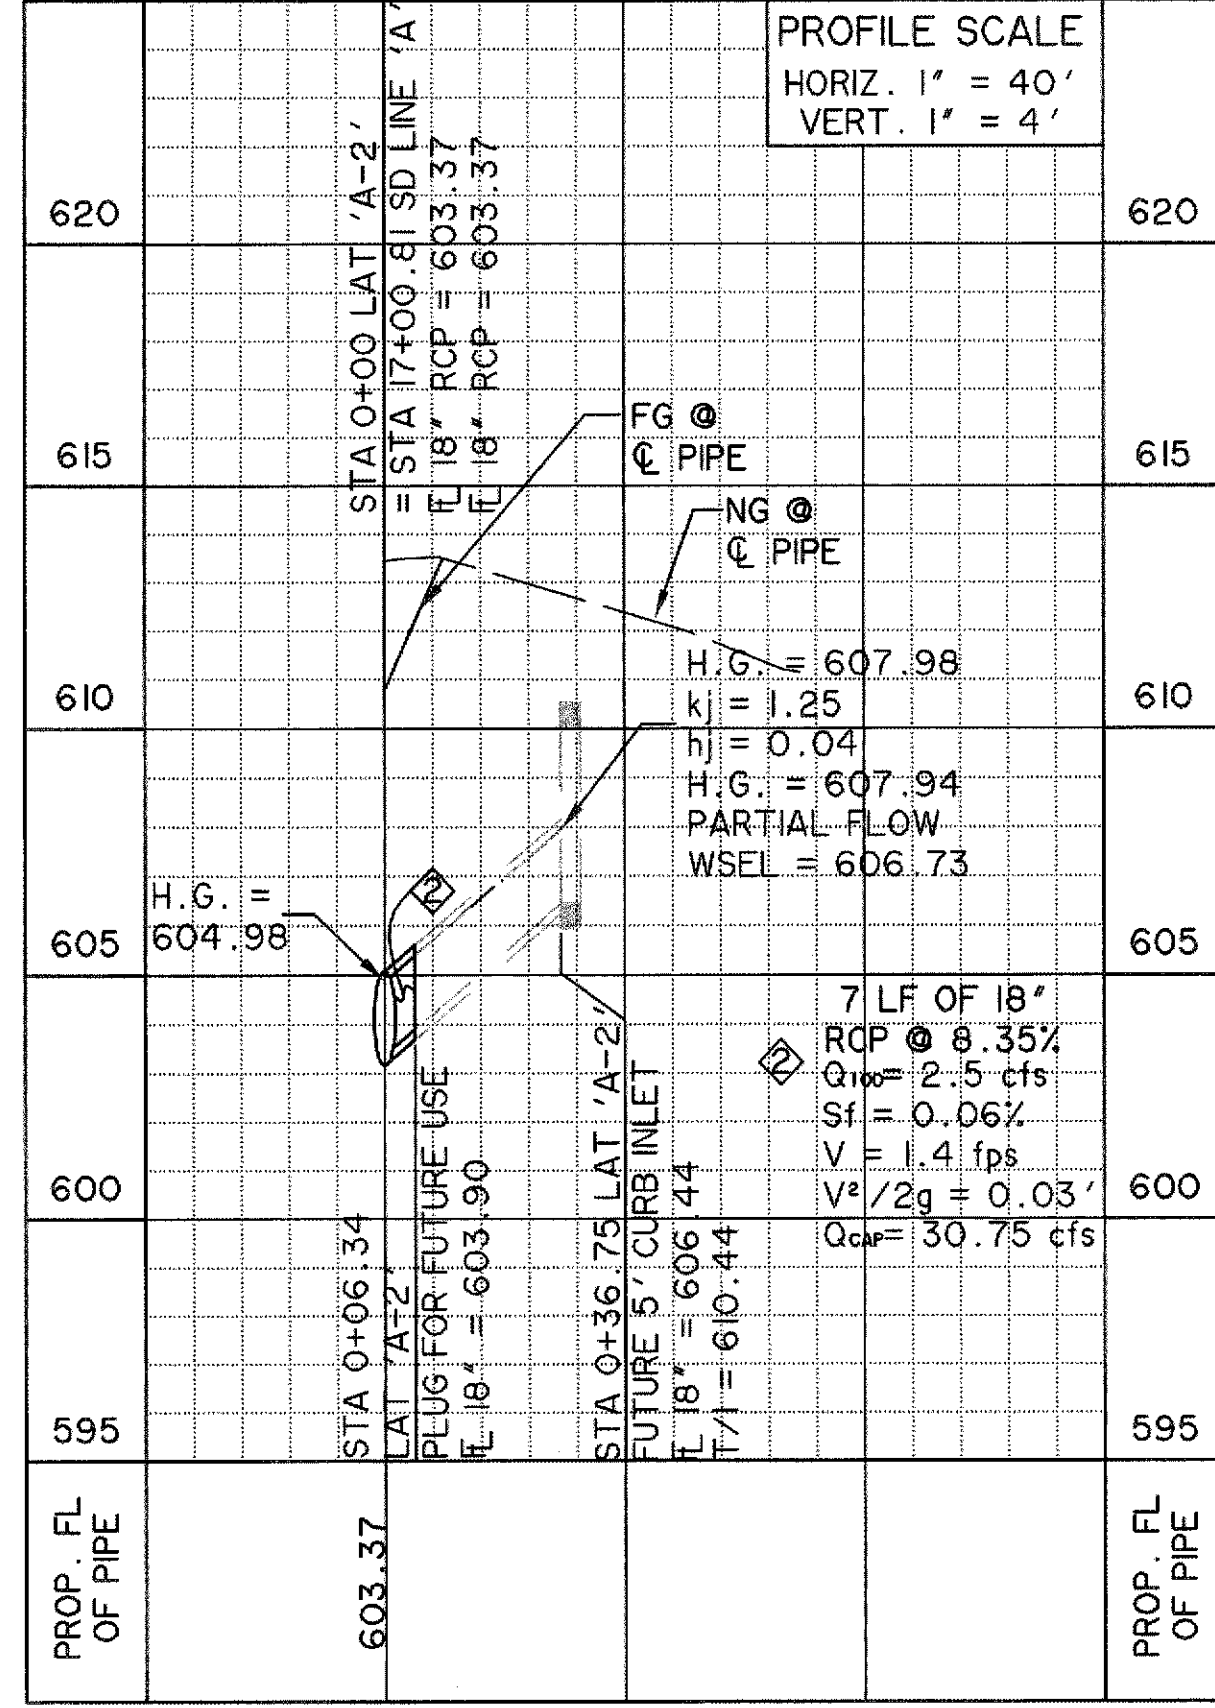


0+00 1+00

LAT. 'A3'

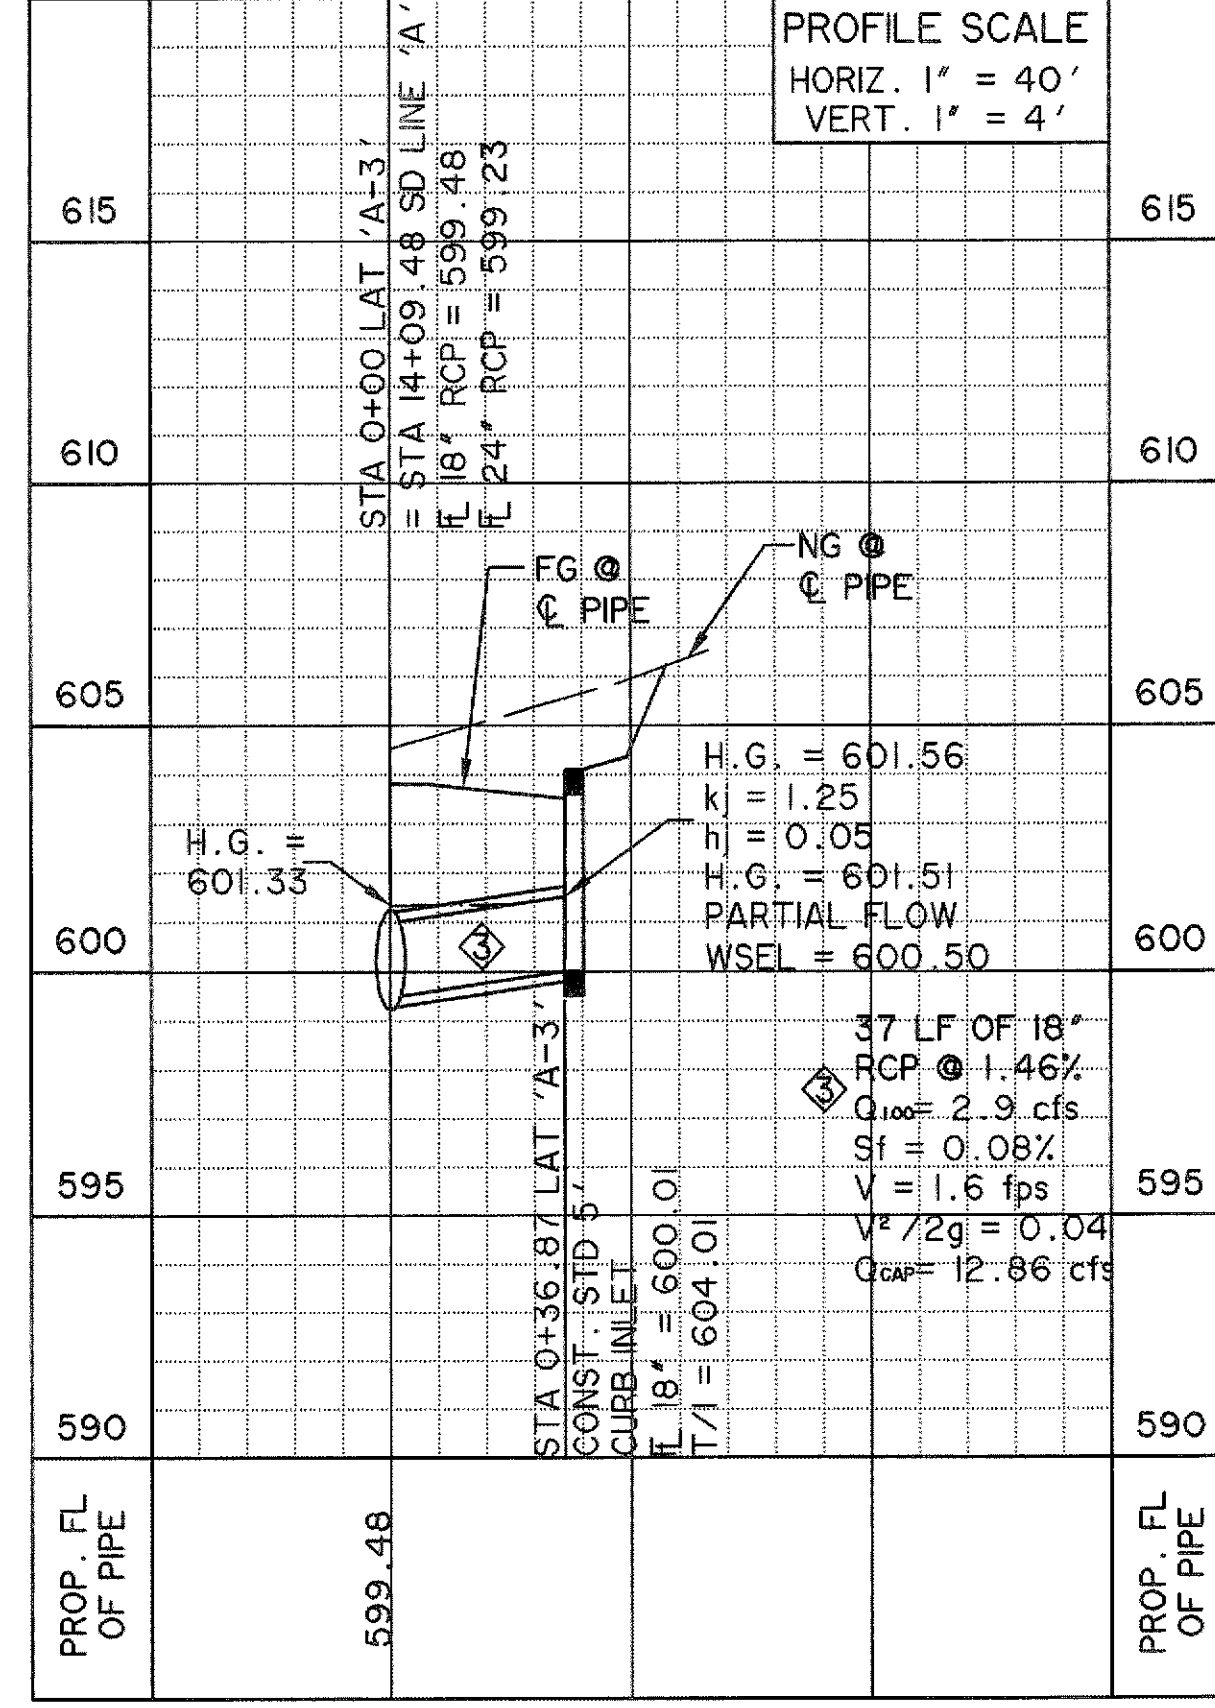


0+00 1+00

LAT. 'A4'

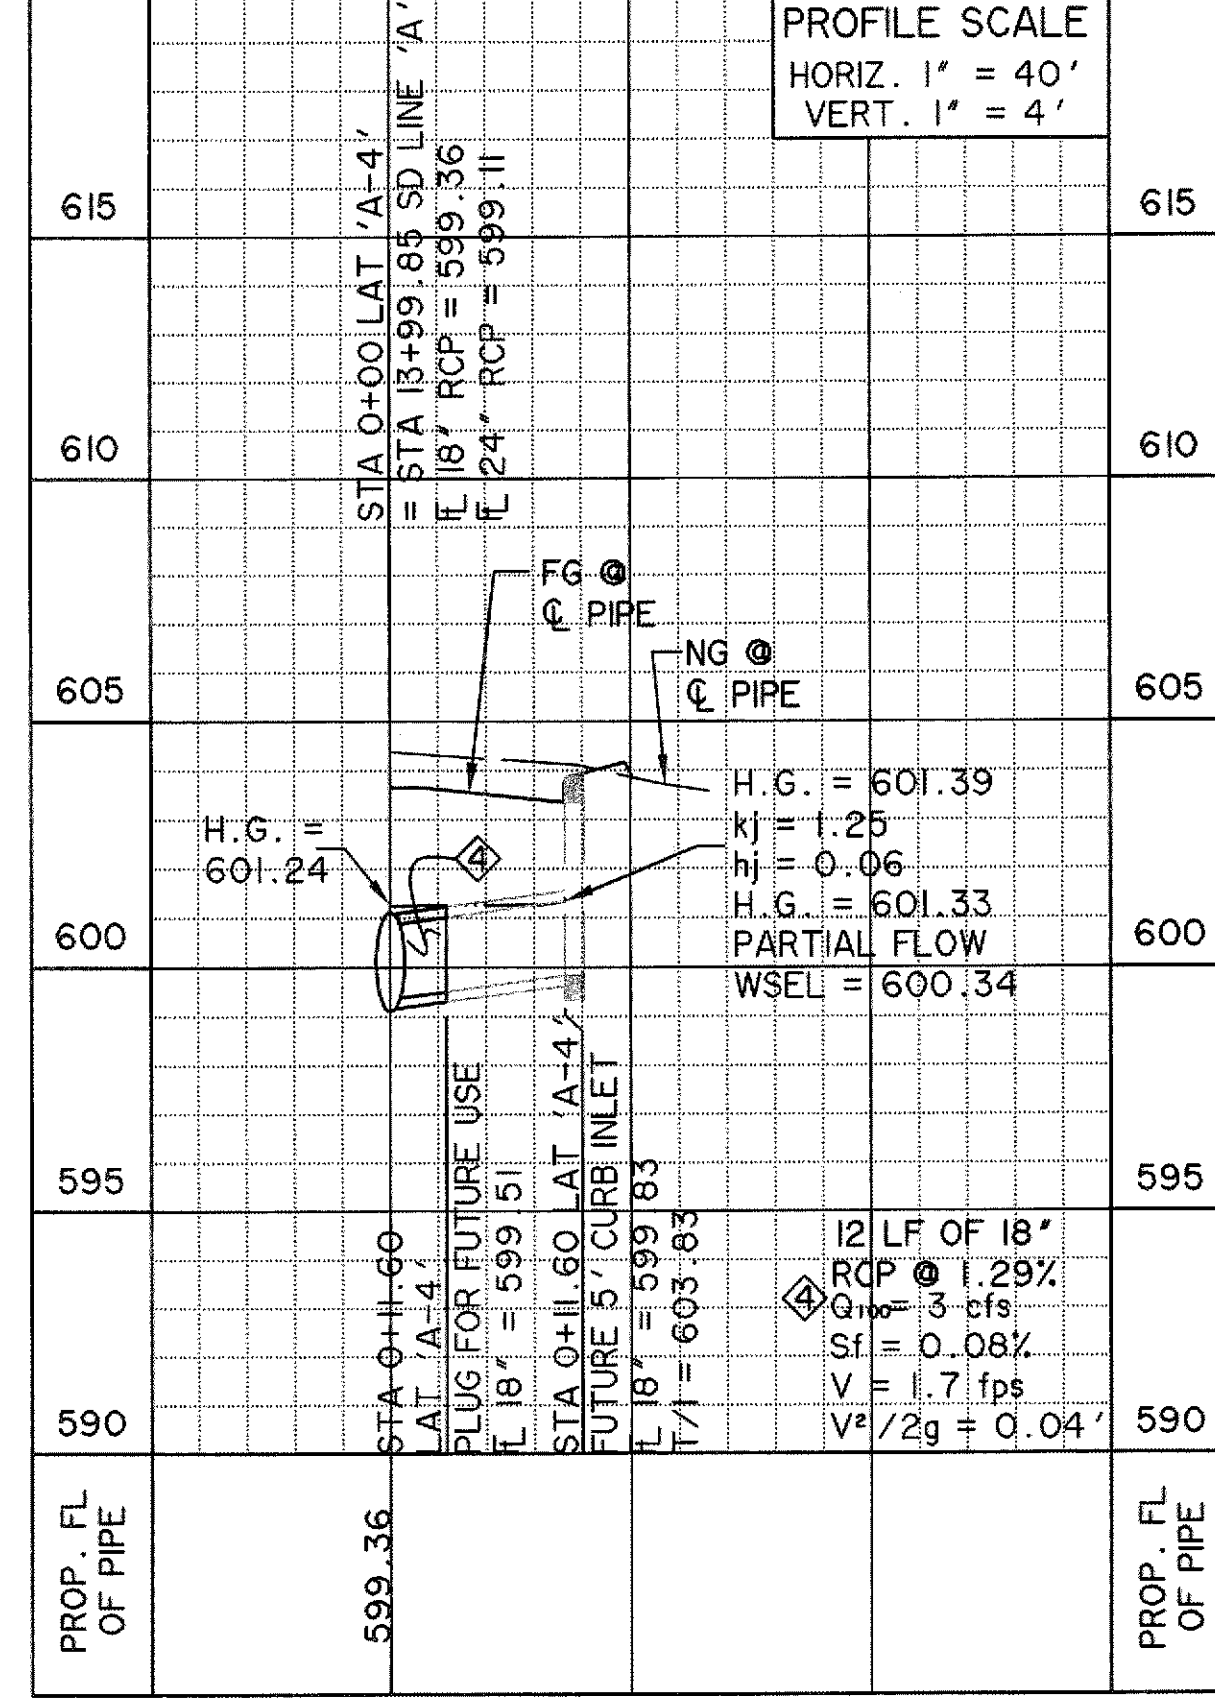


0+00 1+00

LAT. 'A5'

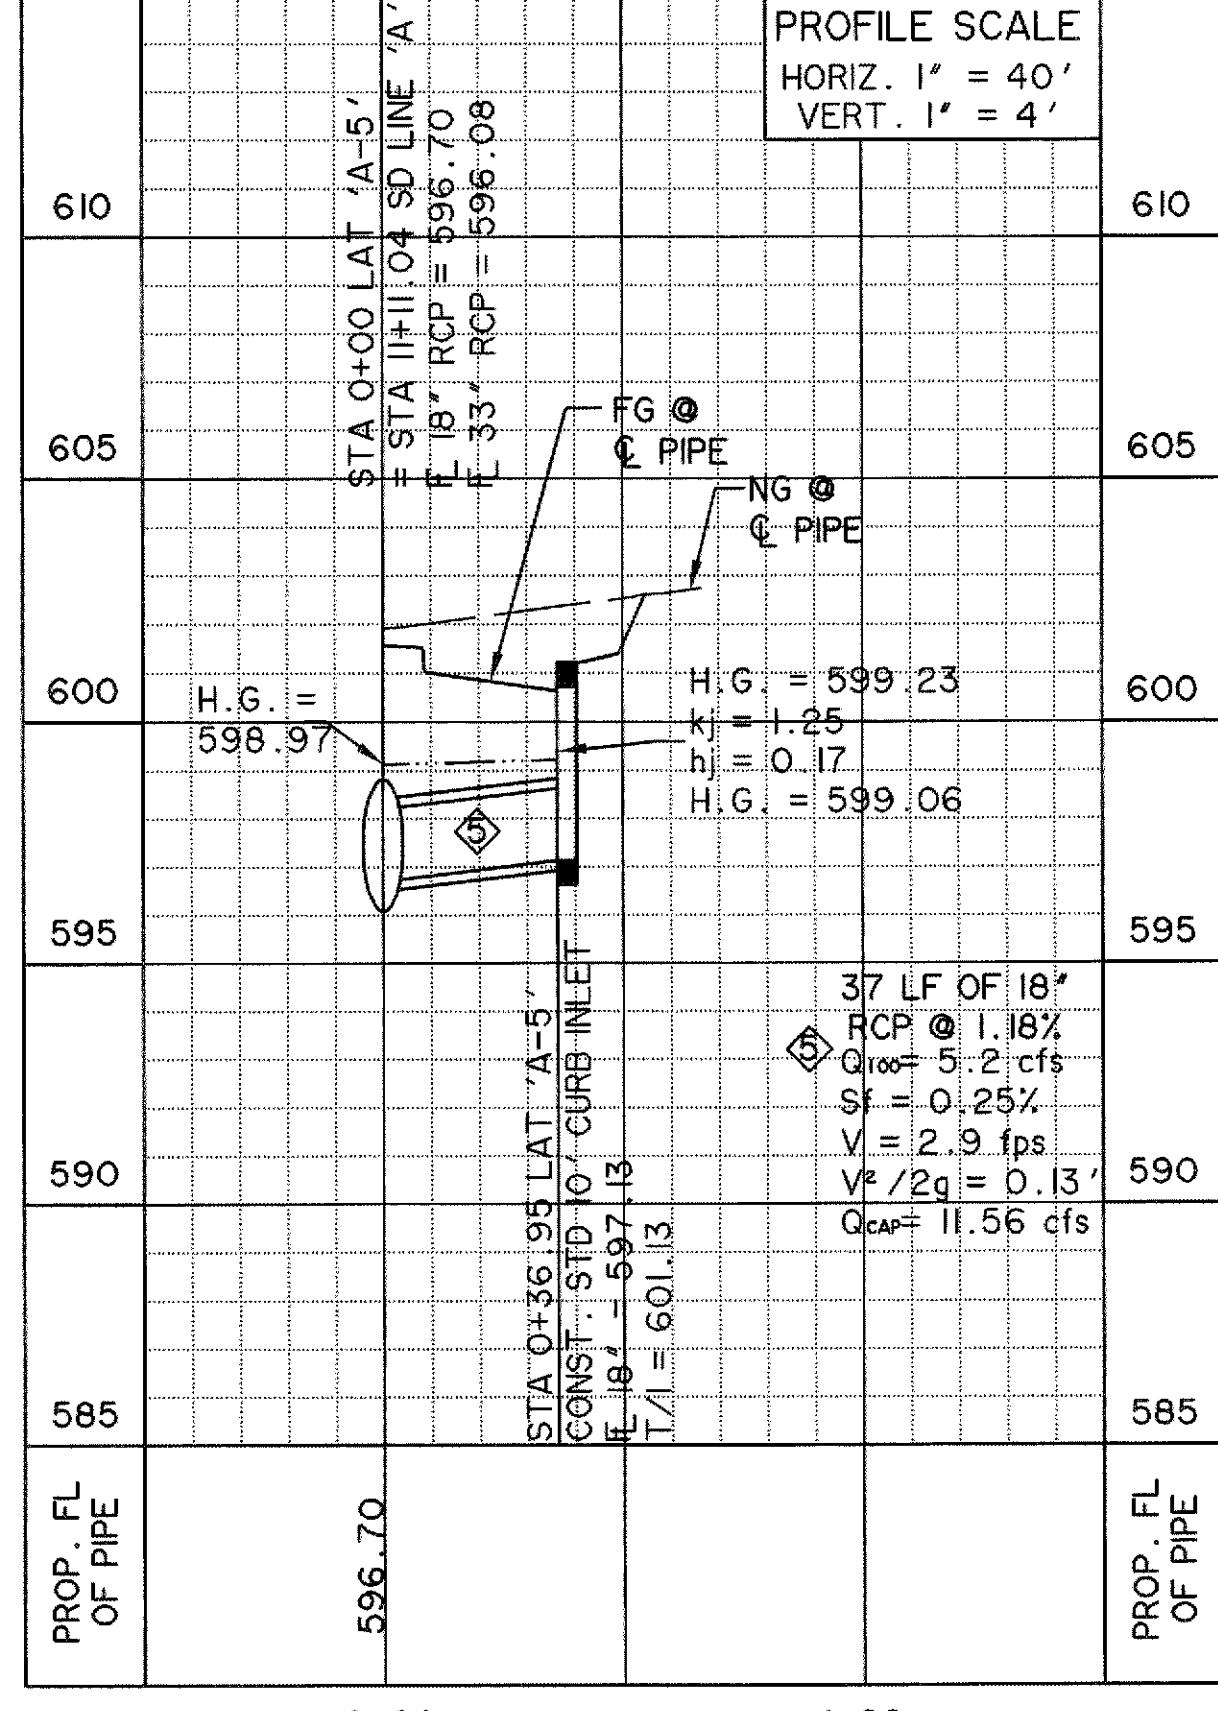


0+00 1+00

LAT. 'A6'

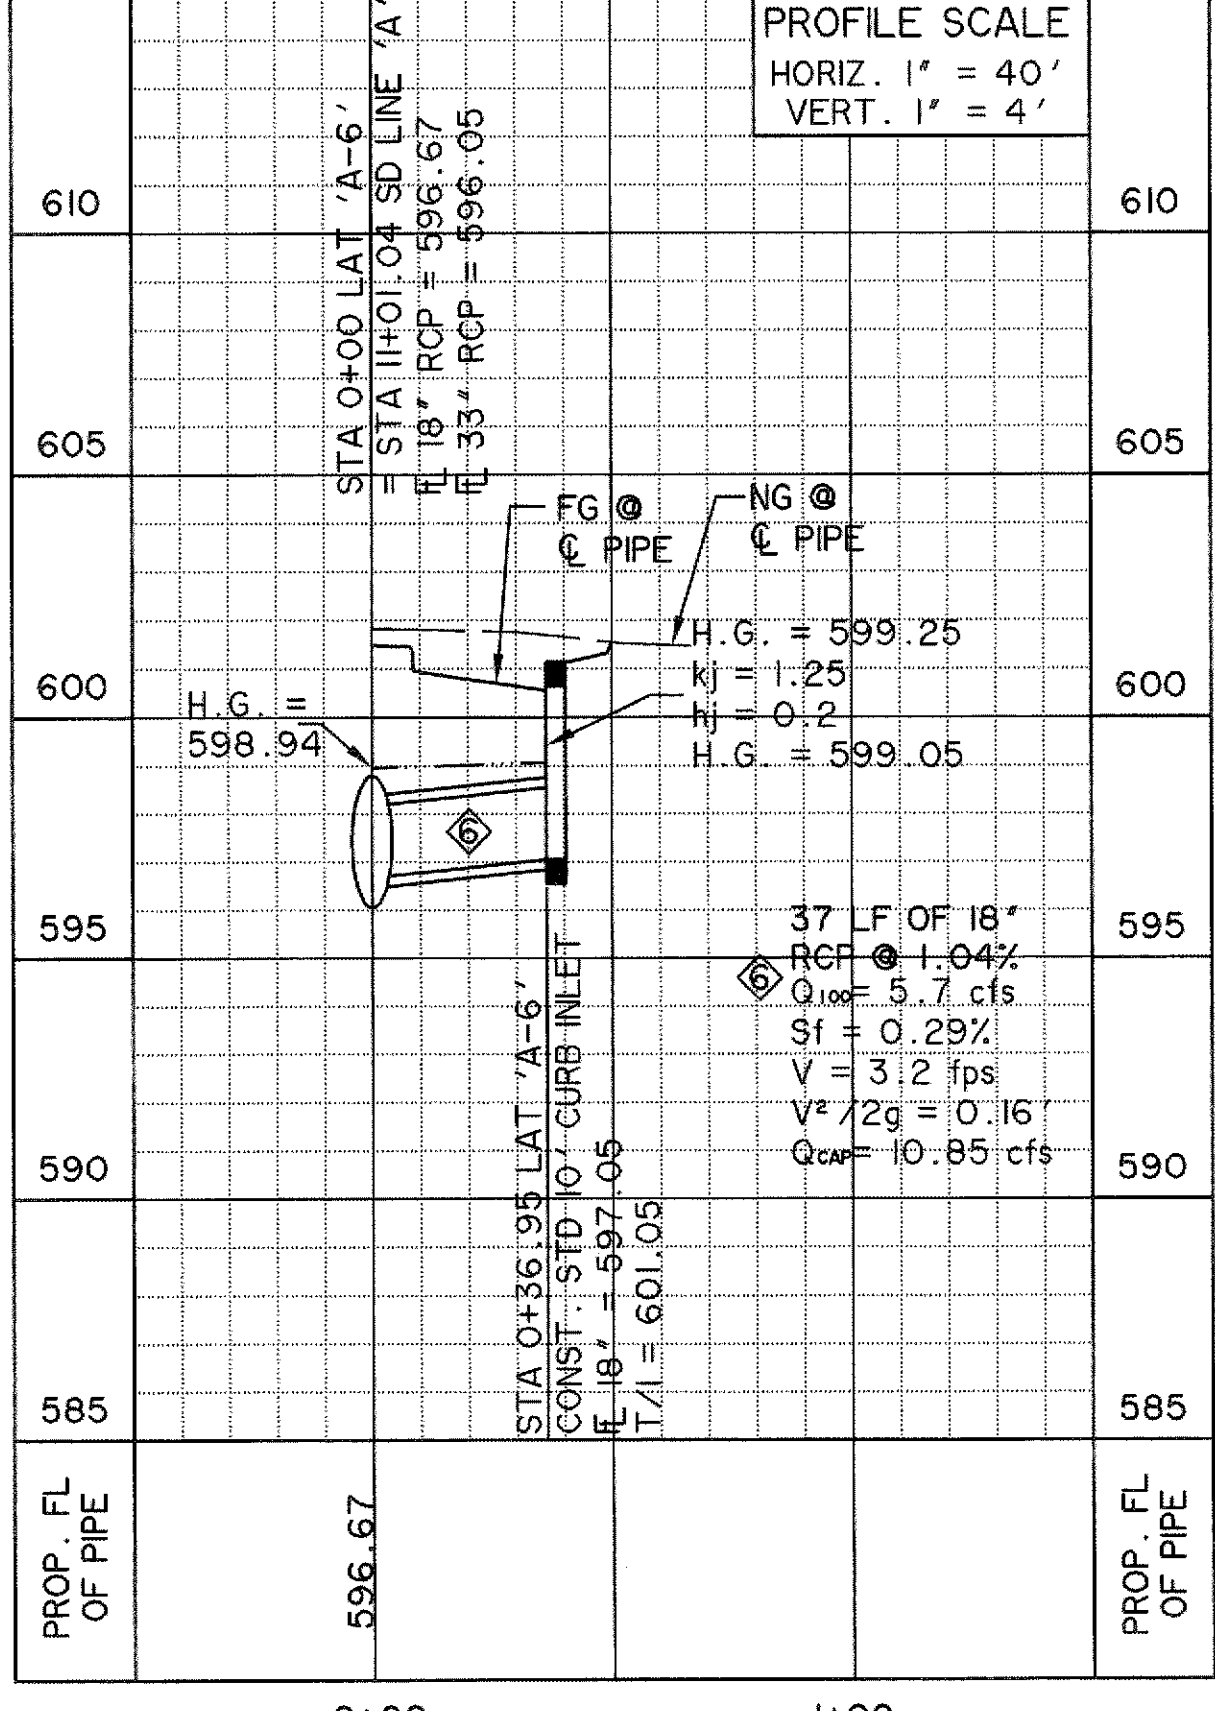


0+00 1+00

LAT. 'A7'

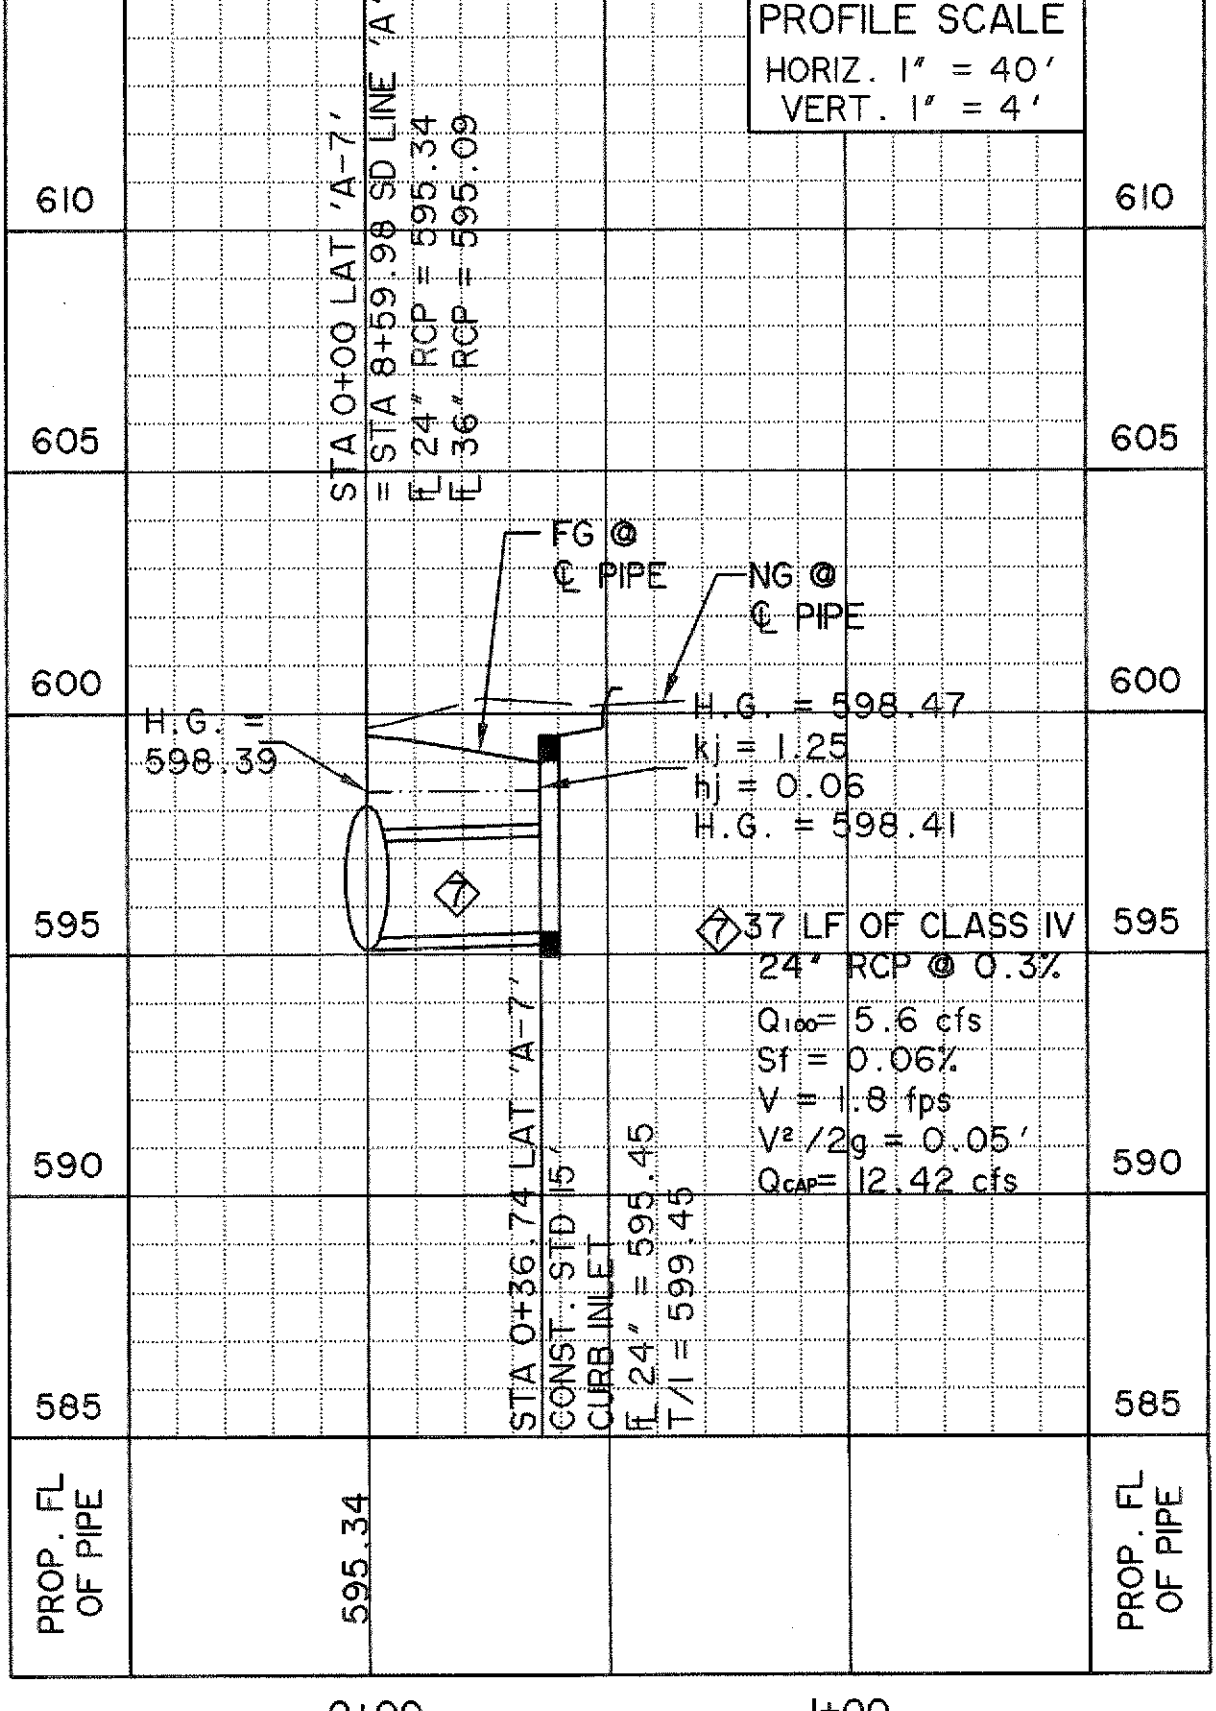

0+00 1+00

LAT. 'A8'

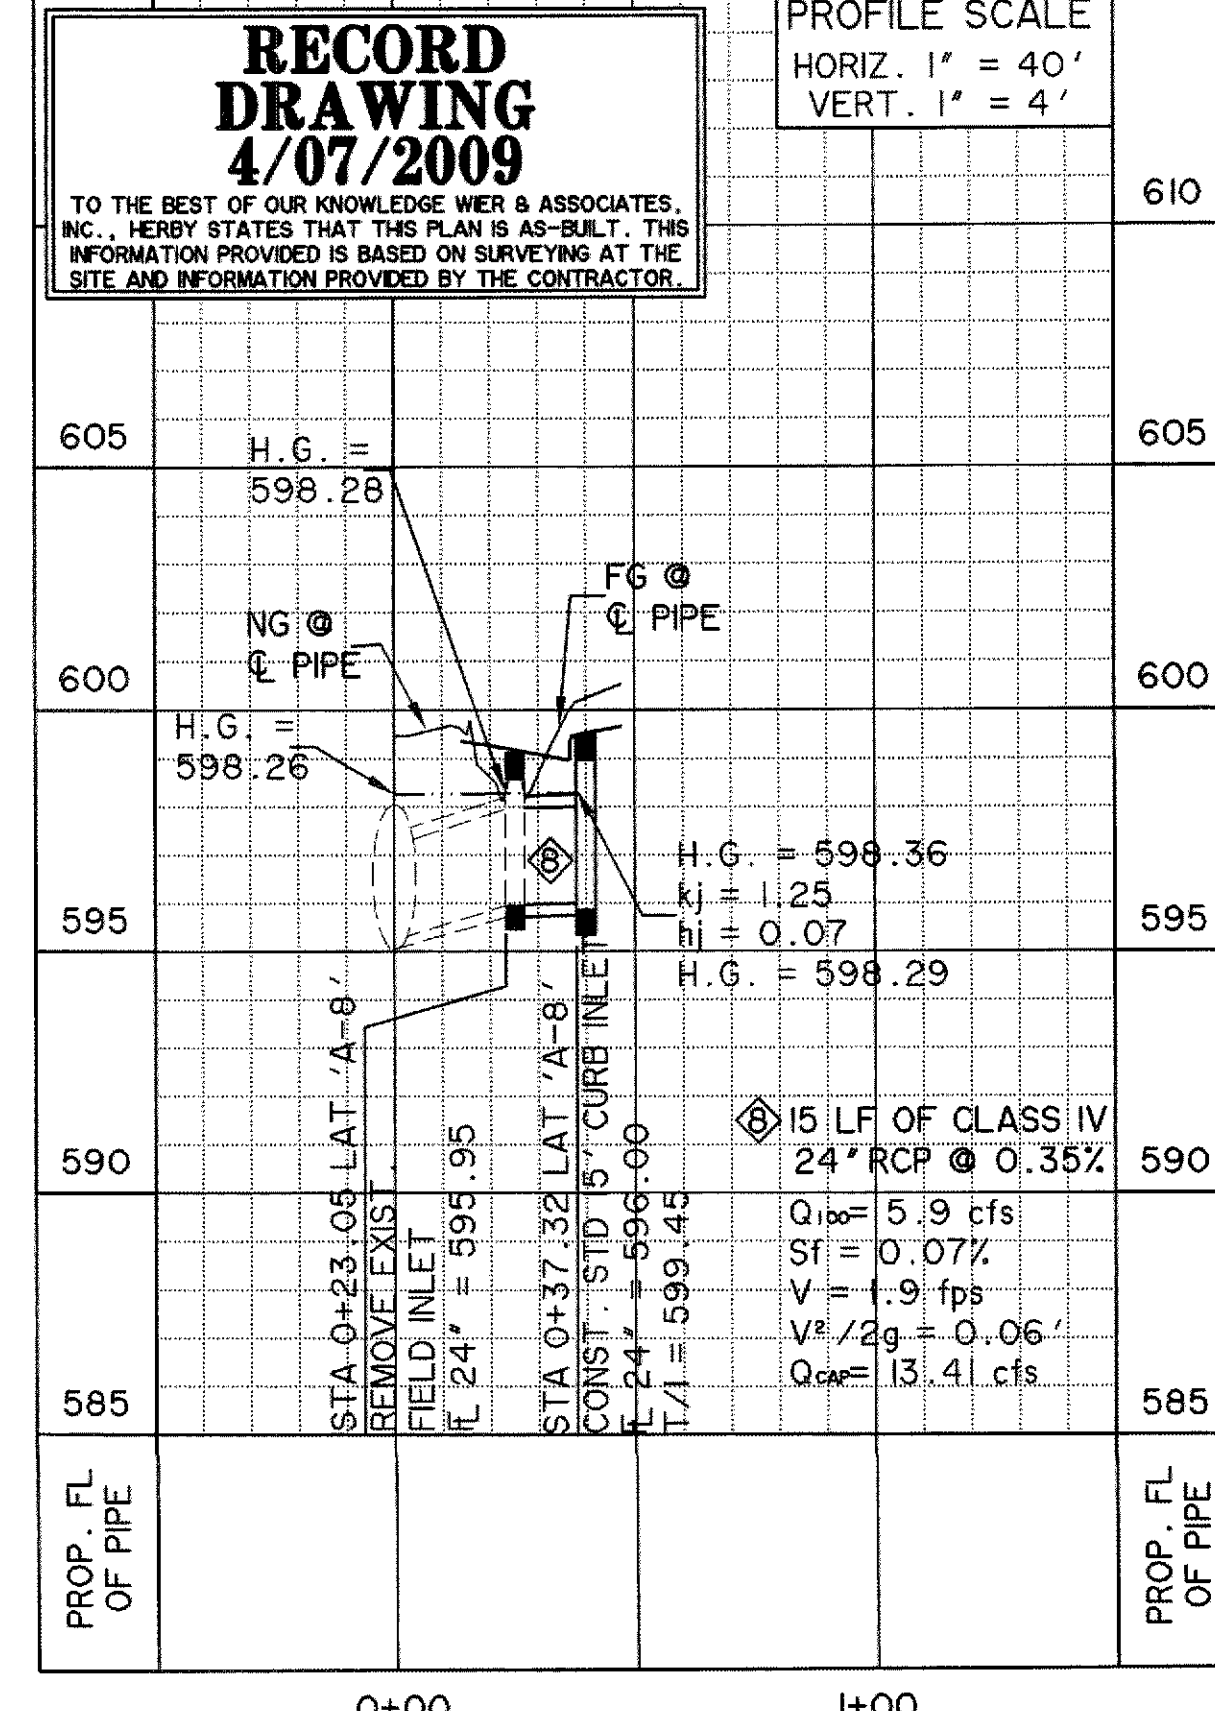


0+00 1+00

RECORD DRAWING
4/07/2009

TO THE BEST OF OUR KNOWLEDGE WIER & ASSOCIATES, INC., HEREBY STATES THAT THIS PLAN IS AS-BUILT. THIS INFORMATION PROVIDED IS BASED ON SURVEYING AT THE SITE AND INFORMATION PROVIDED BY THE CONTRACTOR.


TIME: 8:41 FILE: D401-SD-LAT1-98041-04.dwg

PREPARED BY:
WIER & ASSOCIATES, INC.
ENGINEERS SURVEYORS LAND PLANNERS
701 HIGHLANDER BLVD., SUITE 300 ARLINGTON, TEXAS 76015 METRO (817)467-7700
6849 ELM STREET FRISCO, TEXAS 75034 METRO (214)387-8000
Texas State Registration No. 2776 www.WierAssociates.com

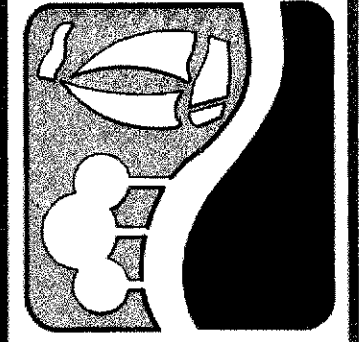

ROCKWALL TECHNOLOGY PARK PHASE III

STORM DRAIN LATERALS LINE 'A'

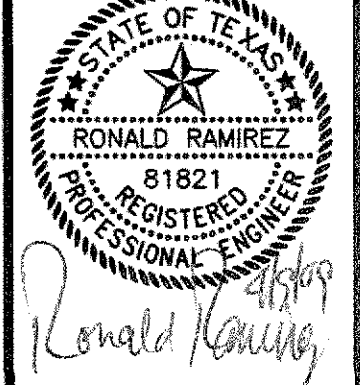

COPYRIGHT © WIER & ASSOCIATES, INC.
LAST SHEET EDIT DATE: 04-07-2009
WA# 98041.04
SHEET NO. D401