

EXISTING TOPOGRAPHIC LEGEND

|                   |  |
|-------------------|--|
|                   | ASPHALT PAVEMENT                           |
| BOL/GP ○          | BOLLARD/GUARD POST                         |
| B/C               | DIMENSION TO BACK OF CURB                  |
| CATV □            | CABLE TV                                   |
| CM                | CONTROL MONUMENT                           |
| CONC.             | CONCRETE                                   |
| EAP               | EDGE OF ASPHALT PAVEMENT                   |
| EB □              | ELEC BOX (GROUND)                          |
| EM □              | ELEC METER                                 |
| FH ⊙              | FIRE HYDRANT                               |
| FO ⊖              | FIBER OPTIC CABLE                          |
| GM △              | GAS METER                                  |
| GMH ⊙             | GAS MANHOLE                                |
| GTS ▽             | GAS TEST STATION                           |
| GUY ∩             | GUY WIRE                                   |
| HDWL              | CONCRETE HEADWALL                          |
| ICV □             | IRRIGATION CONTROL VALVE                   |
| IRF               | IRON ROD FOUND                             |
| IRS               | IRON ROD SET                               |
| LP ⊙              | LIGHT POLE                                 |
| PP ○              | POWER POLE                                 |
| PP/LP ⊙           | POWER POLE W/LIGHT                         |
| SDMH ⊙            | STORM DRAIN MANHOLE                        |
| SHD ○             | SPRINKLER HEAD                             |
| SN ⊖              | SIGN                                       |
| SSMH ⊙            | SANITARY SEWER MANHOLE                     |
| SSCO ○            | SANITARY SEWER CLEANOUT                    |
| SWBT              | SOUTH WESTERN BELL TELEPHONE               |
| TPD ⊠             | TELEPHONE PEDESTAL                         |
| TSG □             | TELEPHONE SWITCH GEAR                      |
| TSB □             | TRAFFIC SIGNAL BOX                         |
| TSP ○             | TRAFFIC SIGNAL POLE                        |
| TSC               | TRAFFIC SIGNAL CONTROLLER                  |
| ⊠                 | TRANSFORMER PAD                            |
| WM □              | WATER METER                                |
| WV ⊠              | WATER VALVE                                |
| — OE —            | OVERHEAD ELECTRIC LINE                     |
| — UE —            | UNDERGROUND ELECTRIC LINE                  |
| — W —             | WATER LINE                                 |
| — SS —            | SANITARY SEWER LINE                        |
| — FO —            | FIBER OPTIC LINE                           |
| — UT —            | UNDERGROUND TELEPHONE                      |
| — OT —            | OVERHEAD TELEPHONE                         |
| — G —             | UNDERGROUND GAS                            |
| ---24" RCP---     | EXISTING CONCRETE STORM DRAIN LINE         |
| ---24" CMP---     | EXISTING CORRUGATED METAL STORM DRAIN LINE |
| —→—               | EXISTING FLOWLINE                          |
| BARBED WIRE FENCE | BARBED WIRE FENCE                          |
| CHAIN LINK FENCE  | CHAIN LINK FENCE                           |
| WOOD FENCE        | WOOD FENCE                                 |
| —○—               | GUARD RAIL / BARRICADE                     |
|                   | EXISTING TREE LINE                         |
|                   | EXISTING TREE                              |

PAVING PLAN LEGEND

|  |                                   |
|--|-----------------------------------|
|  | * 4000 PSI. CONC. PAVING          |
|  | BRICK PAVING                      |
|  | LANDSCAPING                       |
|  | COMPACTED FILL PER CITY STANDARDS |
|  | EXISTING ASPHALT TO BE REMOVED    |
|  | EXISTING CONCRETE TO BE REMOVED   |
|  | EXISTING GRAVEL TO BE REMOVED     |
|  | DIRECTION OF TRAFFIC              |
|  | DIRECTION OF FLOW                 |

\* NOTE: MIN 6 SACK FOR MACHINE POUR AND 6.5 SACK FOR HAND POUR.

GRADING PLAN LEGEND

|      |                      |
|------|----------------------|
|      | PROPOSED CONTOURS    |
|      | EXISTING CONTOURS    |
|      | PROPOSED SPOT GRADES |
|      | PROPOSED STORM DRAIN |
|      | FLOW ARROWS          |
| T/C  | TOP OF CURB          |
| T/P  | TOP OF PAVEMENT      |
| H.P. | HIGH POINT           |

DRAINAGE PLAN LEGEND

|         |  |
|---------|--|
|         | DRAINAGE AREA DESIGNATION<br>DRAINAGE AREA (ACRES) |
|         | WATERSHED LIMITS                                   |
|         | MAJOR DRAINAGE AREA DIVIDE                         |
|         | ZONING BOUNDARY                                    |
|         | FLOW DIRECTION ARROW                               |
| L2      | LINE IDENTIFIED IN LINE TABLE                      |
| C2      | CURVE IDENTIFIED IN CURVE TABLE                    |
|         | INDICATES PROPOSED RECESSED CURB INLET             |
|         | INDICATES PROPOSED STANDARD CURB INLET             |
|         | INDICATES FUTURE INLET                             |
|         | INDICATES EXISTING INLET                           |
|         | INDICATES PROPOSED DROP INLET                      |
|         | INDICATES PROPOSED JUNCTION BOX                    |
| 27" RCP | PROPOSED STORM DRAIN                               |
| 27" RCP | FUTURE STORM DRAIN                                 |
|         | PROPOSED SWALE                                     |

EROSION CONTROL LEGEND

|     |   |
|-----|---|
|     | LIMITS OF OPERATOR DAY TO DAY OPERATIONAL CONTROL |
|     | PROPOSED SWALE                                    |
|     | INDICATES STABILIZED CONSTRUCTION ENTRANCE        |
|     | INDICATES REINFORCED SILT FENCE                   |
|     | INDICATES ROCK BERM                               |
|     | INDICATES DROP INLET PROTECTION                   |
|     | INDICATES PROPOSED INLET TREATMENT                |
|     | STONE OVERFLOW STRUCTURE                          |
| 640 | EXISTING CONTOUR LINE                             |
| 640 | PROPOSED CONTOUR LINE                             |
|     | DRAINAGE AREA DIVIDE                              |


LEGEND

|  |                      |
|--|----------------------|
|  | DRAINAGE AREA DIVIDE |
|  | PROPOSED INLET       |
|  | PROP. STORMDRAIN     |
|  | PROP. FIELD INLET    |
|  | EXIST. INLET         |
|  | FUTURE INLET         |
|  | FUTURE STORMDRAIN    |
|  | DIRECTION OF FLOW    |

WATER AND SANITARY SEWER PLAN LEGEND


|  |                               |
|--|-------------------------------|
|  | PROPOSED FIRE HYDRANT         |
|  | PROPOSED WATER METER          |
|  | PROPOSED WATER VALVE          |
|  | PROPOSED WATER                |
|  | PROPOSED SEWER                |
|  | PROPOSED SEWER MANHOLE        |
|  | EXISTING WATER LINE           |
|  | EXISTING WATER VALVE          |
|  | EXISTING WATER METER BOX      |
|  | EXISTING FIRE HYDRANT         |
|  | EXISTING LIGHT POLE           |
|  | EXISTING POWER POLE           |
|  | EXIST. SANITARY SEWER MANHOLE |
|  | EXISTING SANITARY SEWER       |
|  | EXISTING INLET                |
|  | PROPOSED INLET                |
|  | FUTURE INLET                  |

PREPARED BY:  
**WIER & ASSOCIATES, INC.**  
ENGINEERS SURVEYORS LAND PLANNERS  
701 HIGHLANDER BLVD., SUITE 300 ARLING, TEXAS 76015 METRO (817)467-7700  
6849 ELM STREET FRISCO, TEX 75034 METRO (214)397-8000  
www.WierAssociates.com  
Texas State Registration No. 76

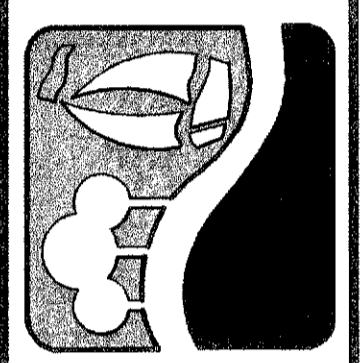

**ROCKWALL TECHNOLOGY PARK PHASE III**

**TOPOGRAPHIC LEGEND**

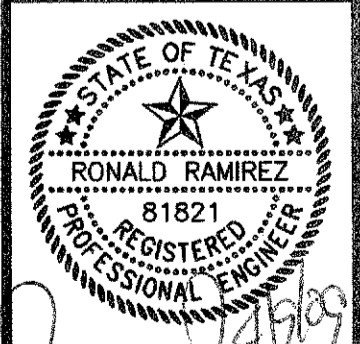

COPYRIGHT ©  
WIER & ASSOCIATES, INC.  
LAST SHEET EDIT  
DATE: 04-07-2009  
SHEET NO. A202

**RECORD DRAWING**  
**4/07/2009**  
TO THE BEST OF OUR KNOWLEDGE WIER & ASSOCIATES, INC., HERBY STATES THAT THIS PLAN IS AS-BUILT. THIS INFORMATION PROVIDED IS BASED ON SURVEYING AT THE SITE AND INFORMATION PROVIDED BY THE CONTRACTOR.