

**\* BENCH MARKS \***

BM A - AN "X" CUT IN THE BACK OF CURB LOCATED AT THE SOUTH RIGHT-OF-WAY LINE OF SPRINGER ROAD ±2470' EAST OF THE INTERSECTION OF SPRINGER ROAD AND F.M. 549. 598.80 FT.

BM B - AN "X" CUT IN THE BACK OF CURB LOCATED AT THE NORTH RIGHT-OF-WAY LINE OF DISCOVERY BOULEVARD ±580' EAST OF THE INTERSECTION OF DISCOVERY BOULEVARD AND F.M. 549. 599.82 FT.

BM C - AN "□" CUT IN DISCOVERY BOULEVARD IN A MEDIAN NOSE ±60' WEST OF THE INTERSECTION OF DISCOVERY BOULEVARD AND F.M. 549. 598.20 FT.

**DISCOVERY BLVD**

**SPRINGER ROAD**

**DATA DRIVE**

**MATCH LINE SHEET D102**



DA H-1 (10.41 Ac.) REMOVED FROM PH-III PLANS DA H-2 INCREASED FROM 7.40 AC TO 8.53 AC DUE TO SITE GRADING. SEE BIMBO SITE PLANS FOR GRADING AND DETAILS.

**CORPORATE CROSSING**


LOT 1, BLOCK A  
ROCKWALL TECHNOLOGY PARK  
PHASE II  
CAB. E. SLIDE 305-306  
P.R.R.C.T.

LOT 2, BLOCK B  
ROCKWALL TECHNOLOGY PARK  
PHASE III  
CAB. H. SLIDE 273-274  
P.R.R.C.T.

**ROCKWALL TECHNOLOGY PARK PHASE IV**

**OVERALL DRAINAGE AREA MAP**


PREPARED BY:  
**WIER & ASSOCIATES, INC.**  
ENGINEERS SURVEYORS LAND PLANNERS  
701 HIGHLANDER BLVD., SUITE 300 ARLINGTON, TEXAS 76015 METRO (817)467-7700  
www.wierassociates.com  
Texas Firm Registration No. F-2776

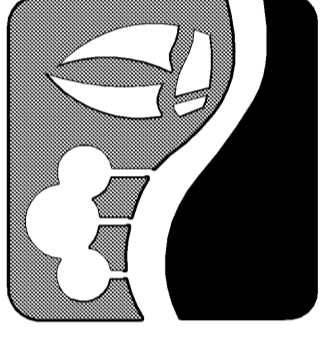

**RECORD DRAWING**  
**02/02/2015**

TO THE BEST OF OUR KNOWLEDGE WIER & ASSOCIATES, INC., HERBY STATES THAT THIS PLAN IS AS-BUILT. THIS INFORMATION PROVIDED IS BASED ON SURVEYING AT THE SITE AND INFORMATION PROVIDED BY THE CONTRACTOR.

\* ALL RESPONSIBILITY FOR ADEQUACY OF DESIGN REMAINS WITH THE DESIGN ENGINEER. THE CITY OF ROCKWALL, IN REVIEWING AND RELEASING PLANS FOR CONSTRUCTION, ASSUMES NO RESPONSIBILITY FOR ADEQUACY OF DESIGN. \*

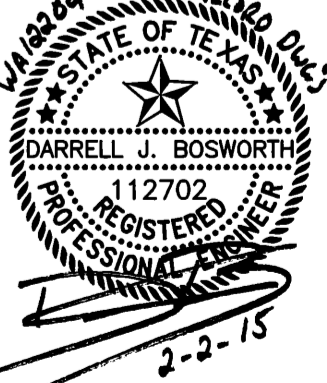

COPYRIGHT ©  
WIER & ASSOCIATES, INC.  
LAST SHEET EDIT  
DATE 10-07-2015  
WA# 12209

**SHEET NO. D101**

TIME 12:00 FILE: D101-DAMAP-12209.dwg

