

CURVE DATA
 R = 65.00'
 L = 59.56'
 T = 32.05'
 D = 52°30'00"E
 CH = S27°53'10"E
 57.50'

STA 2+82.11 LINE 'T'
 = STA 0+00 LAT 'T5'
 = C STA 25+60.59
 DATA DRIVE
 INSTALL 60° MANUF. WYE

STA 0+25.98 LAT 'T5'
 = 22.50' LT. STA 25+73.58
 DATA DRIVE
 CONST. STD. 10' CURB INLET
 T/I = 597.80
 H.G. = 596.54


STA 6+08.53 LINE 'T'
 = STA 0+00 LAT 'T3'
 = C STA 28+87.01
 DATA DRIVE
 INSTALL 60° MANUF. WYE

STA 0+25.98 LAT 'T3'
 = 22.50' LT. STA 29+00.00
 DATA DRIVE
 CONST. STD. 10' CURB INLET
 T/I = 601.05
 H.G. = 598.60

STA 9+36.07 LINE 'T'
 = 12.00' RT STA 27+48.15
 CAPITAL BOULEVARD
 PLUG STORM DRAIN

THE WHITMORE
 MANUFACTURING CO.
 VOL. 6473, PG. 93
 VOL. 6393, PG. 322
 D.R.R.C.T.

CAUTION !!
 EXISTING UTILITIES
 ARE INDICATED ON
 THE PLANS FROM
 AVAILABLE
 INFORMATION. IT
 SHALL BE THE
 RESPONSIBILITY OF
 THE CONTRACTOR TO
 VERIFY THE LOCATION
 OF ALL UTILITIES, TO
 NOTIFY ALL UTILITY
 COMPANIES OF THE
 CONTRACTORS
 OPERATIONS, TO
 PROTECT ALL
 UTILITIES FROM
 DAMAGE, TO REPAIR
 ALL UTILITIES
 DAMAGED DUE TO THE
 CONTRACTORS
 OPERATIONS, AND TO
 NOTIFY THE ENGINEER
 PROMPTLY OF ALL
 CONFLICTS OF THE
 WORK WITH EXISTING
 UTILITIES.


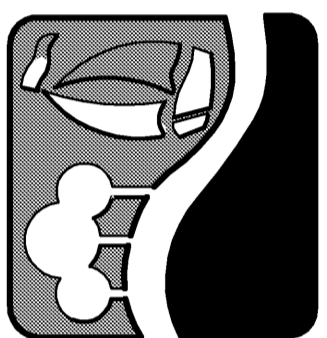


**ROCKWALL
 TECHNOLOGY
 PARK
 PHASE IV**

**STORM DRAIN
 PLAN AND PROFILE
 LINE 'T'**



COPYRIGHT ©
 WIER & ASSOCIATES, INC.
 LAST SHEET OF SET
 DATE: 02/02/2015
 WA# 12209
**SHEET NO.
 D303**

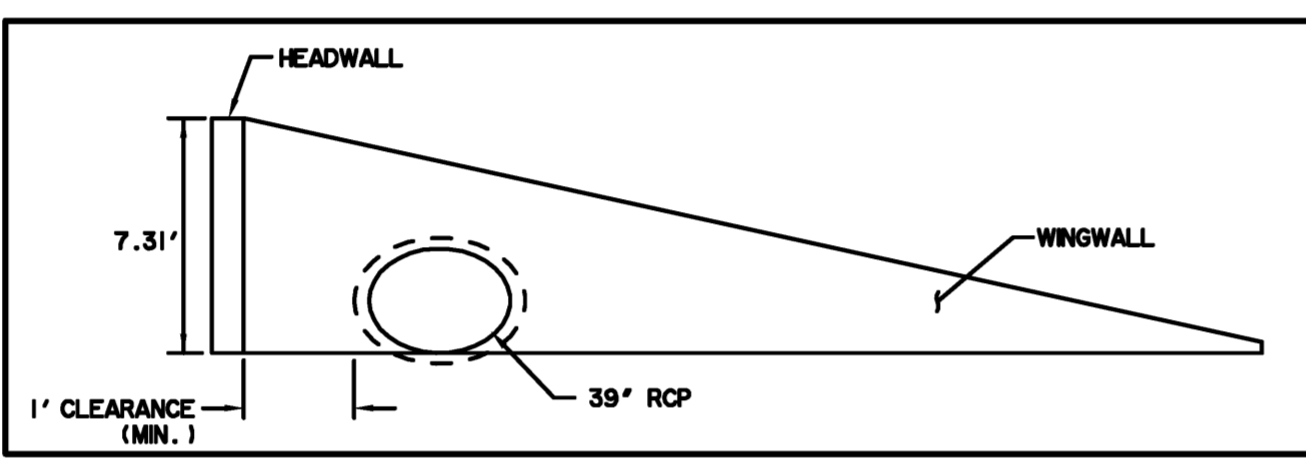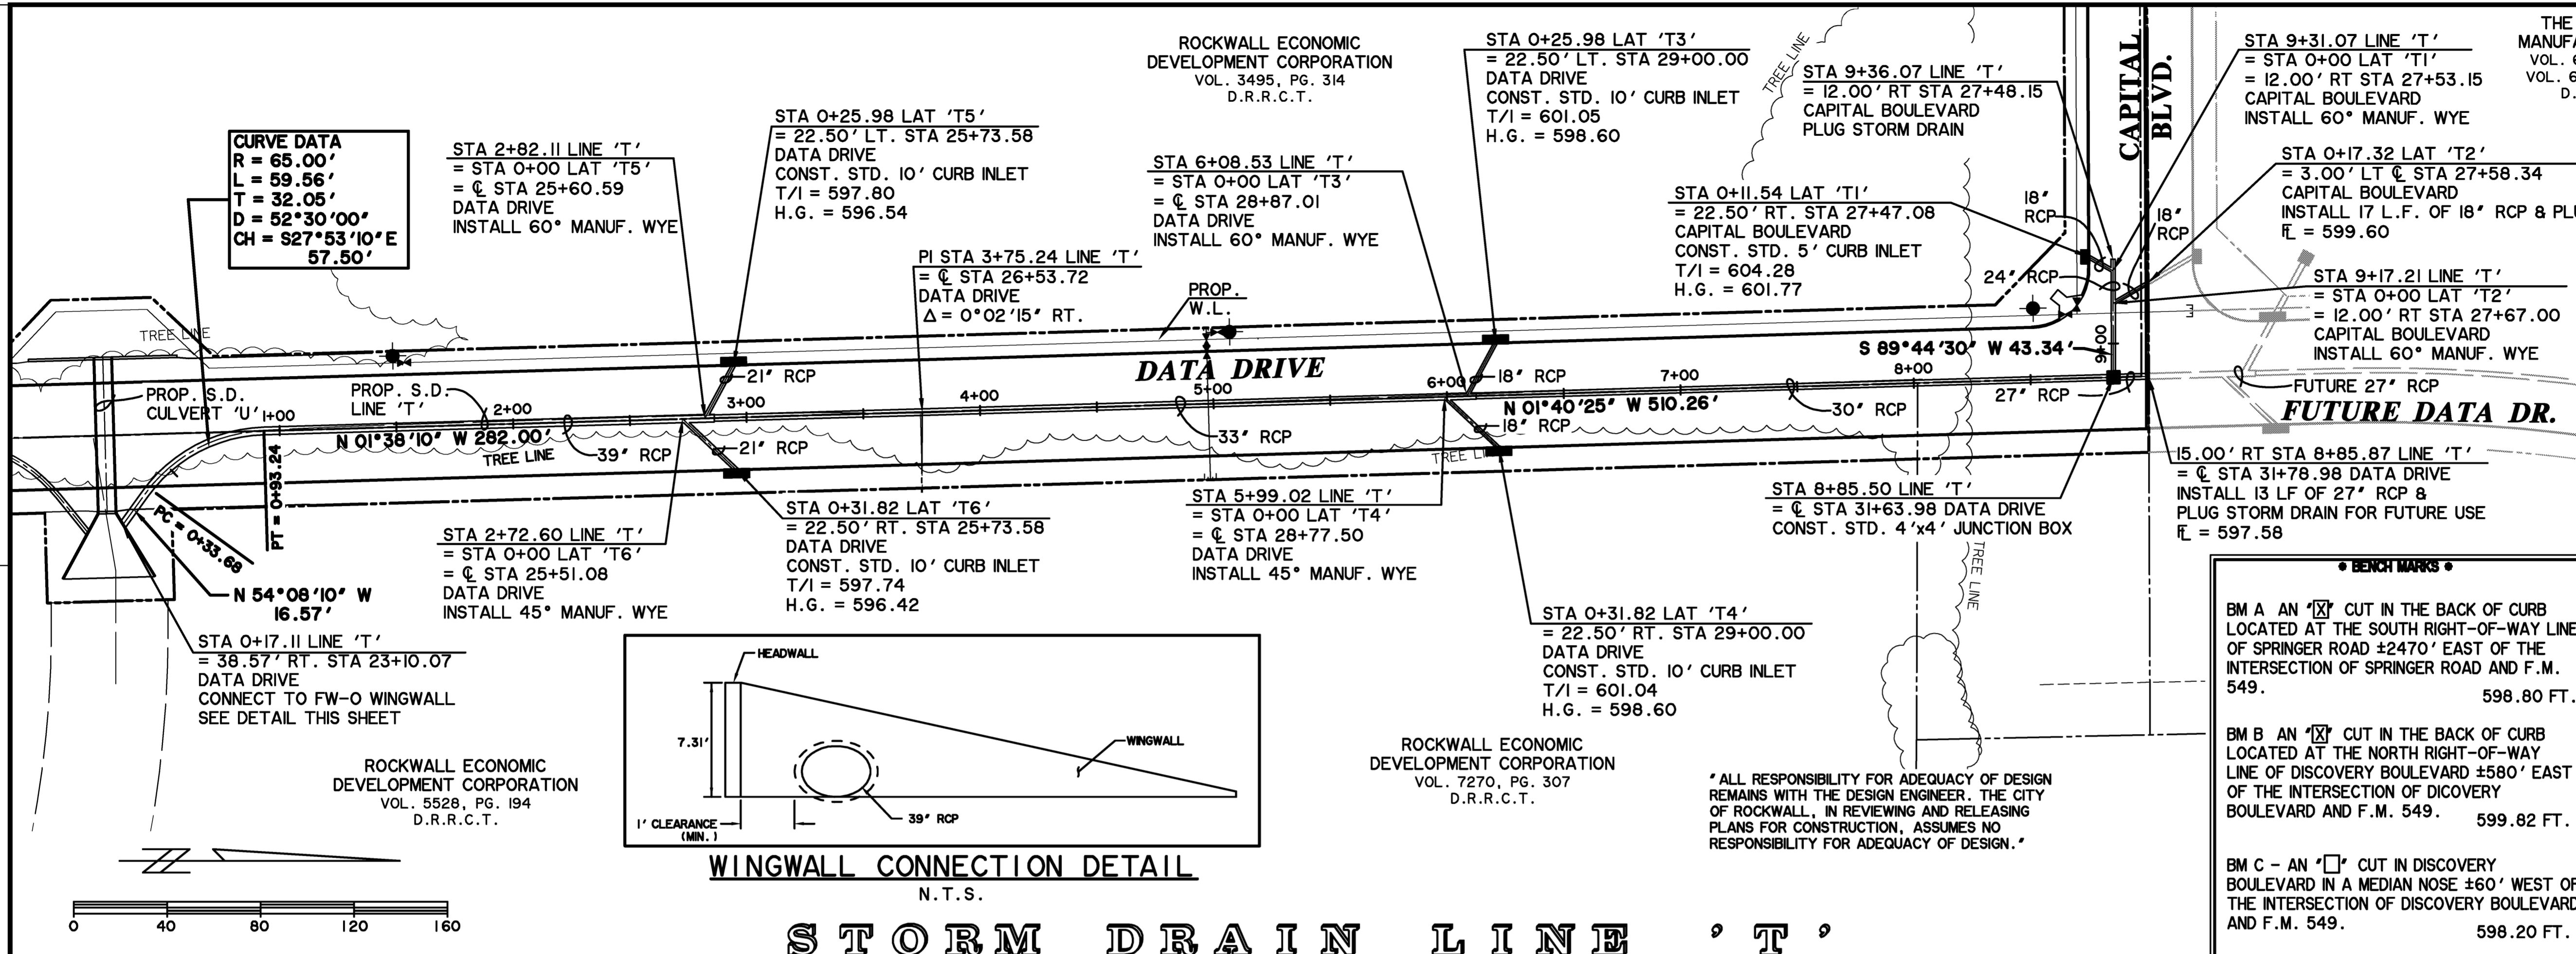


WINGWALL CONNECTION DETAIL
 N.T.S.

* ALL RESPONSIBILITY FOR ADEQUACY OF DESIGN
 REMAINS WITH THE DESIGN ENGINEER. THE CITY
 OF ROCKWALL, IN REVIEWING AND RELEASING
 PLANS FOR CONSTRUCTION, ASSUMES NO
 RESPONSIBILITY FOR ADEQUACY OF DESIGN.*

BENCH MARKS
 BM A AN 'X' CUT IN THE BACK OF CURB
 LOCATED AT THE SOUTH RIGHT-OF-WAY LINE
 OF SPRINGER ROAD ±2470' EAST OF THE
 INTERSECTION OF SPRINGER ROAD AND F.M.
 549. 598.80 FT.
 BM B AN 'X' CUT IN THE BACK OF CURB
 LOCATED AT THE NORTH RIGHT-OF-WAY
 LINE OF DISCOVERY BOULEVARD ±580' EAST
 OF THE INTERSECTION OF DISCOVERY
 BOULEVARD AND F.M. 549. 599.82 FT.
 BM C - AN 'X' CUT IN DISCOVERY
 BOULEVARD IN A MEDIAN NOSE ±60' WEST OF
 THE INTERSECTION OF DISCOVERY BOULEVARD
 AND F.M. 549. 598.20 FT.

STORM DRAIN LINE 'T'

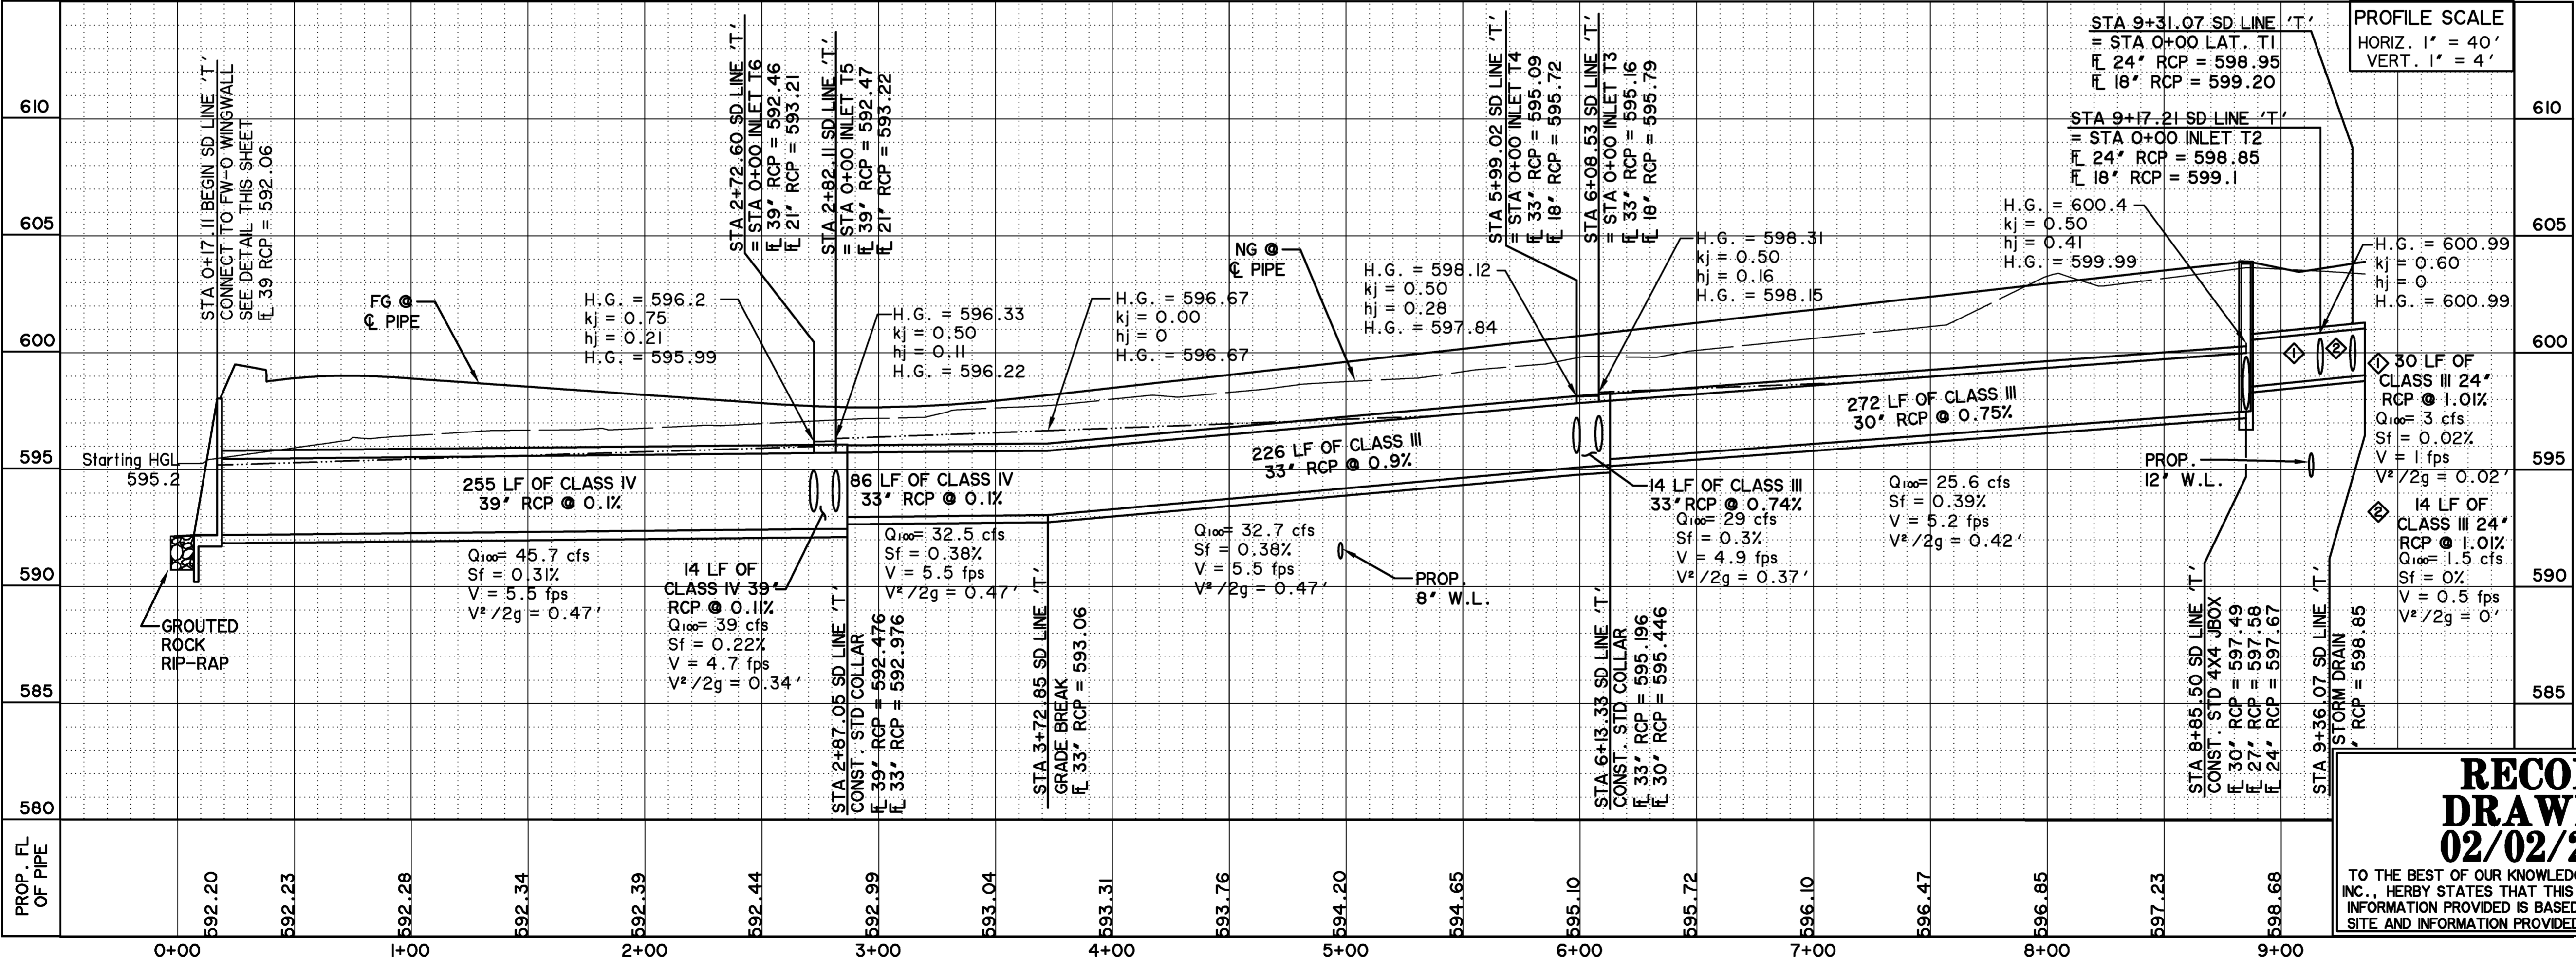

**RECORD
 DRAWING
 02/02/2015**
 TO THE BEST OF OUR KNOWLEDGE WIER & ASSOCIATES,
 INC., HERBY STATES THAT THIS PLAN IS AS-BUILT. THIS
 INFORMATION PROVIDED IS BASED ON SURVEYING AT THE
 SITE AND INFORMATION PROVIDED BY THE CONTRACTOR.

FILE: D303-SD-LN-T-12209.dwg
 TIME: 9:19

PREPARED BY:
WIER & ASSOCIATES, INC.
 ENGINEERS SURVEYORS LAND PLANNERS
 701 HIGHLANDER BLVD., SUITE 300 ARLINGTON, TEXAS 76015 METRO (817)467-7700
 Texas Firm Registration No. F-2776
 www.WierAssociates.com