

CITY OF ROCKWALL, TEXAS

CONSTRUCTION PLANS

FOR

PAVING, DRAINAGE & WATER IMPROVEMENTS

TO SERVE

LOT 3, BLOCK E

ROCKWALL TECHNOLOGY PARK

BILL CECIL - MAYOR

COUNCIL MEMBERS:

CLIFF SEVIER - Mayor Pro Tem

DAVID SWEET


MARK RUSSO

GLEN FARRIS

MARGO NIELSEN

MATT SCOTT


JULIE COUCH - City Manager

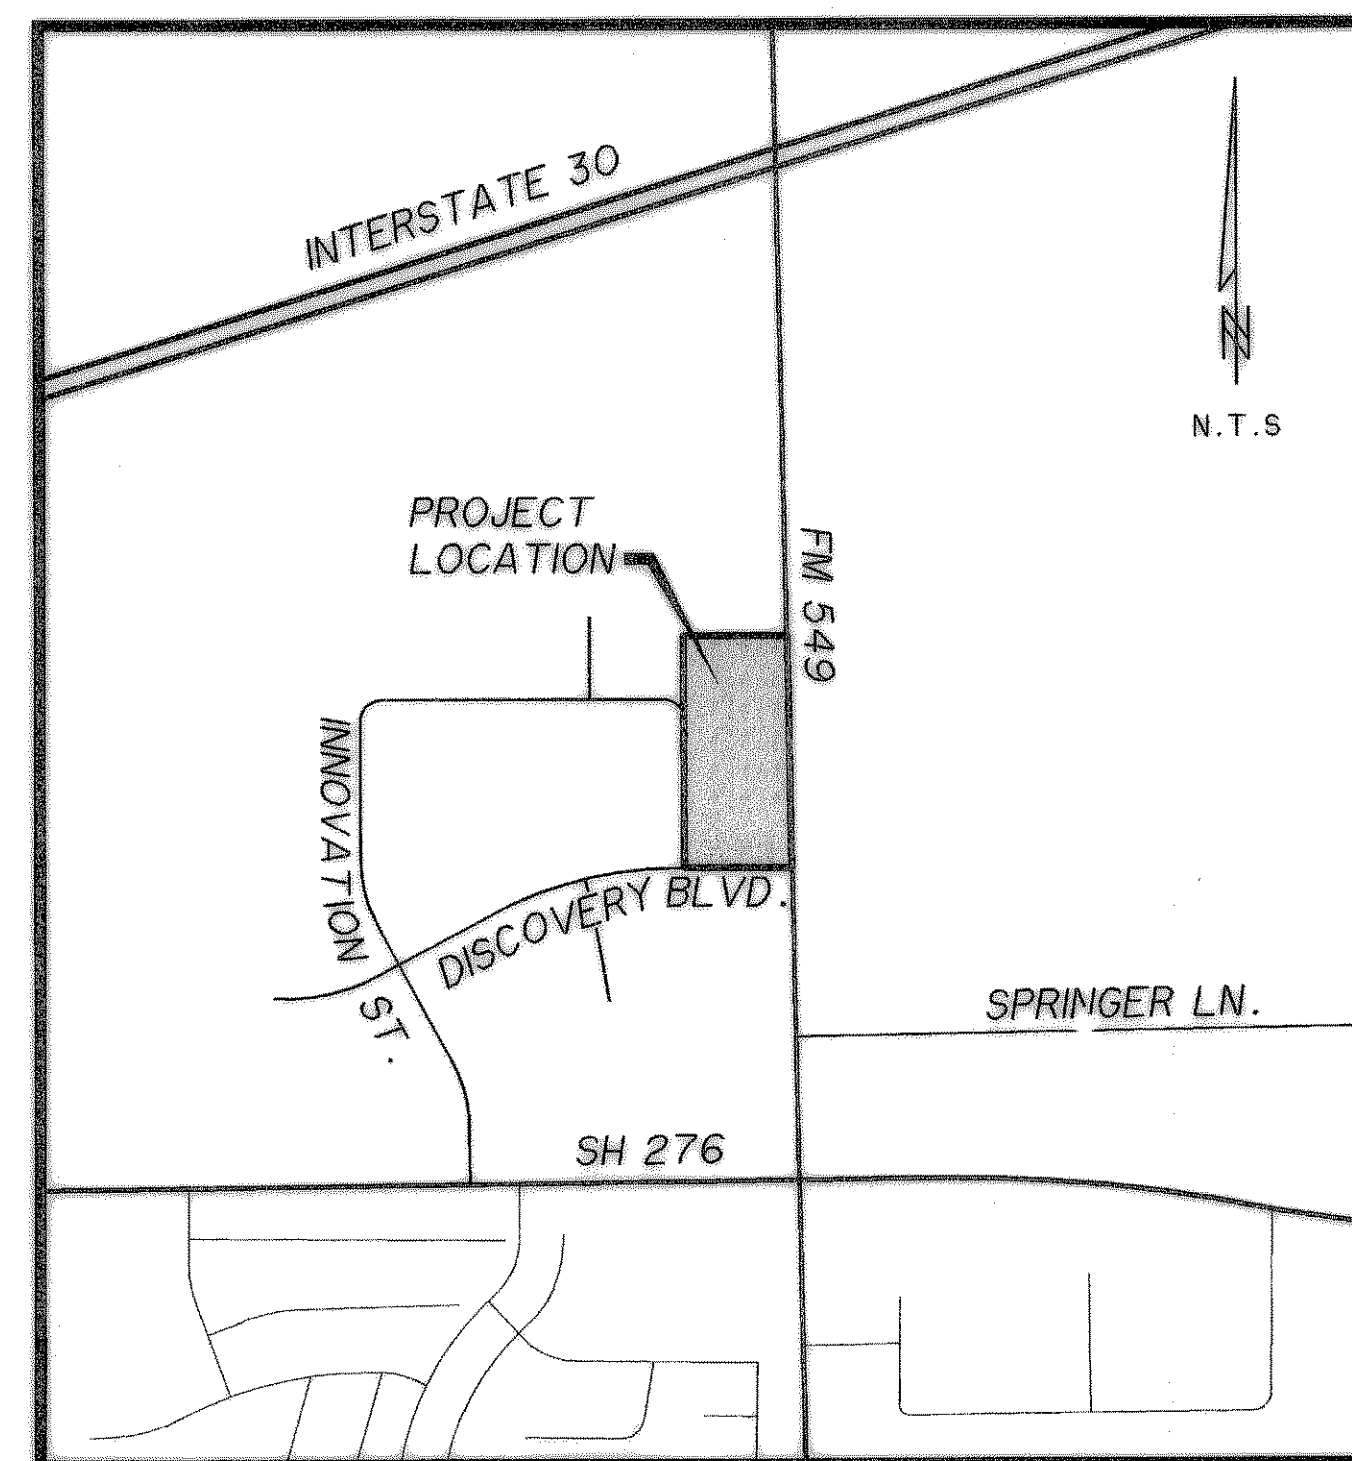

VICINITY MAP

N.T.S.

FEBRUARY 2009

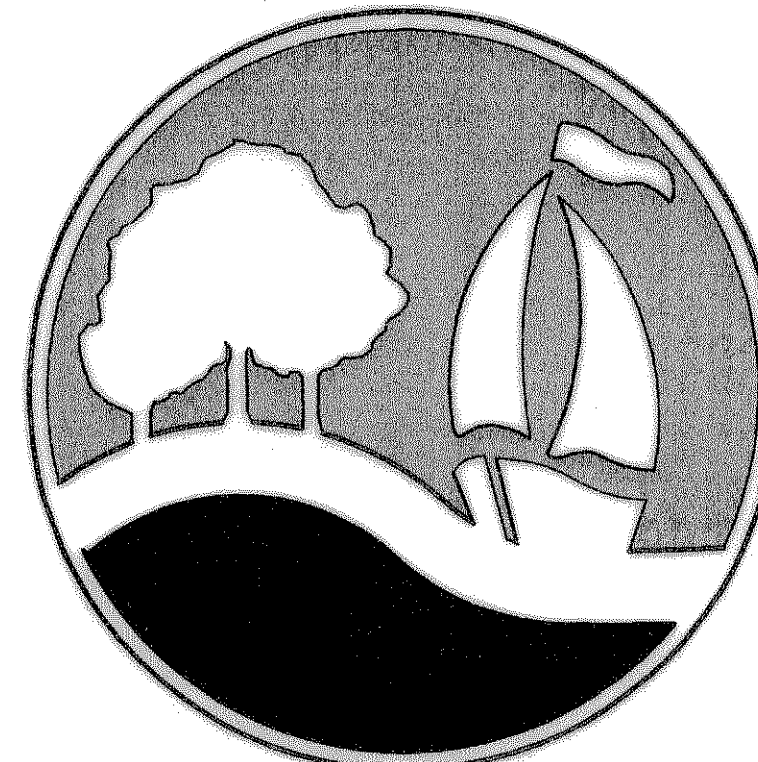

"THE NEW HORIZON"

INDEX OF DRAWINGS

	COVER SHEET
	REPLAT (SHEET 1 OF 2)
	REPLAT (SHEET 2 OF 2)
P001	PAVING GENERAL NOTES
P101	PAVING & DIMENSIONAL CONTROL PLAN
P301	PRIVATE ON-SITE PAVING DETAILS
P302	PRIVATE ON-SITE HANDICAP DETAILS
P303	PRIVATE ON-SITE SIDEWALK DETAILS
G001	GRADING GENERAL NOTES
G101	GRADING PLAN
G102	FM 549 DITCH IMPROVEMENTS
* R101	ROCKWALL TECH. PARK DRAINAGE AREA MAP
D101	DRAINAGE AREA MAP
D102	STORM DRAIN CALCULATIONS & PARKING LOT STORAGE DETAILS
D103	STORM DRAIN PLAN
D201	STORM DRAIN PROFILES
D301	DETENTION POND PLAN & CALCULATIONS
U001	UTILITY GENERAL NOTES
U101	UTILITY PLAN
U301	UTILITY DETAILS
E001-E003	STORM WATER POLLUTION PREVENTION PLAN NOTES
E101	STORM WATER POLLUTION PREVENTION PLAN
E201	STORM WATER POLLUTION PREVENTION PLAN DETAILS
E202	STORM WATER POLLUTION PREVENTION PLAN DETAILS


* ADDED FOR REFERENCE ONLY. NOT FOR CONSTRUCTION.

CITY OF ROCKWALL STANDARD DETAIL SHEETS INCORPORATED
HEREIN BY REFERENCE

1. ALL REFERENCES TO "CITY" SHALL MEAN "CITY OF ROCKWALL"
2. ALL CONSTRUCTION SHALL BE IN ACCORDANCE WITH THE CITY OF ROCKWALL AND NORTH TEXAS COUNCIL OF GOVERNMENT STANDARD SPECIFICATIONS.

RECORD DRAWING

TO THE BEST OF OUR KNOWLEDGE WIER & ASSOCIATES, INC.,
HEREBY STATES THAT THIS PLAN REPRESENTS WITHIN
ALLOWABLE CONSTRUCTION TOLERANCES THE WORK PERFORMED
ON-SITE. THIS INFORMATION PROVIDED IS BASED ON
SURVEYING AT THE SITE & INFORMATION PROVIDED BY THE
CONTRACTOR.

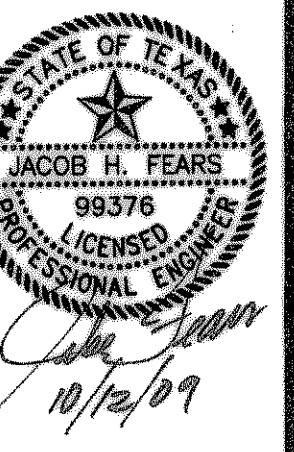

W.A. 08037
10-12-2009