
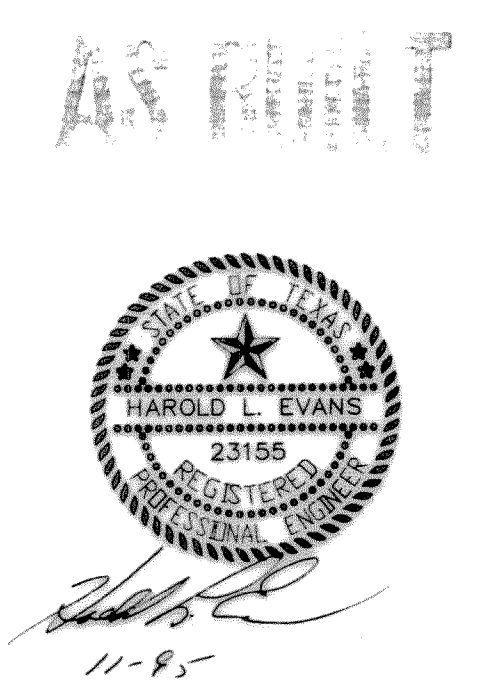
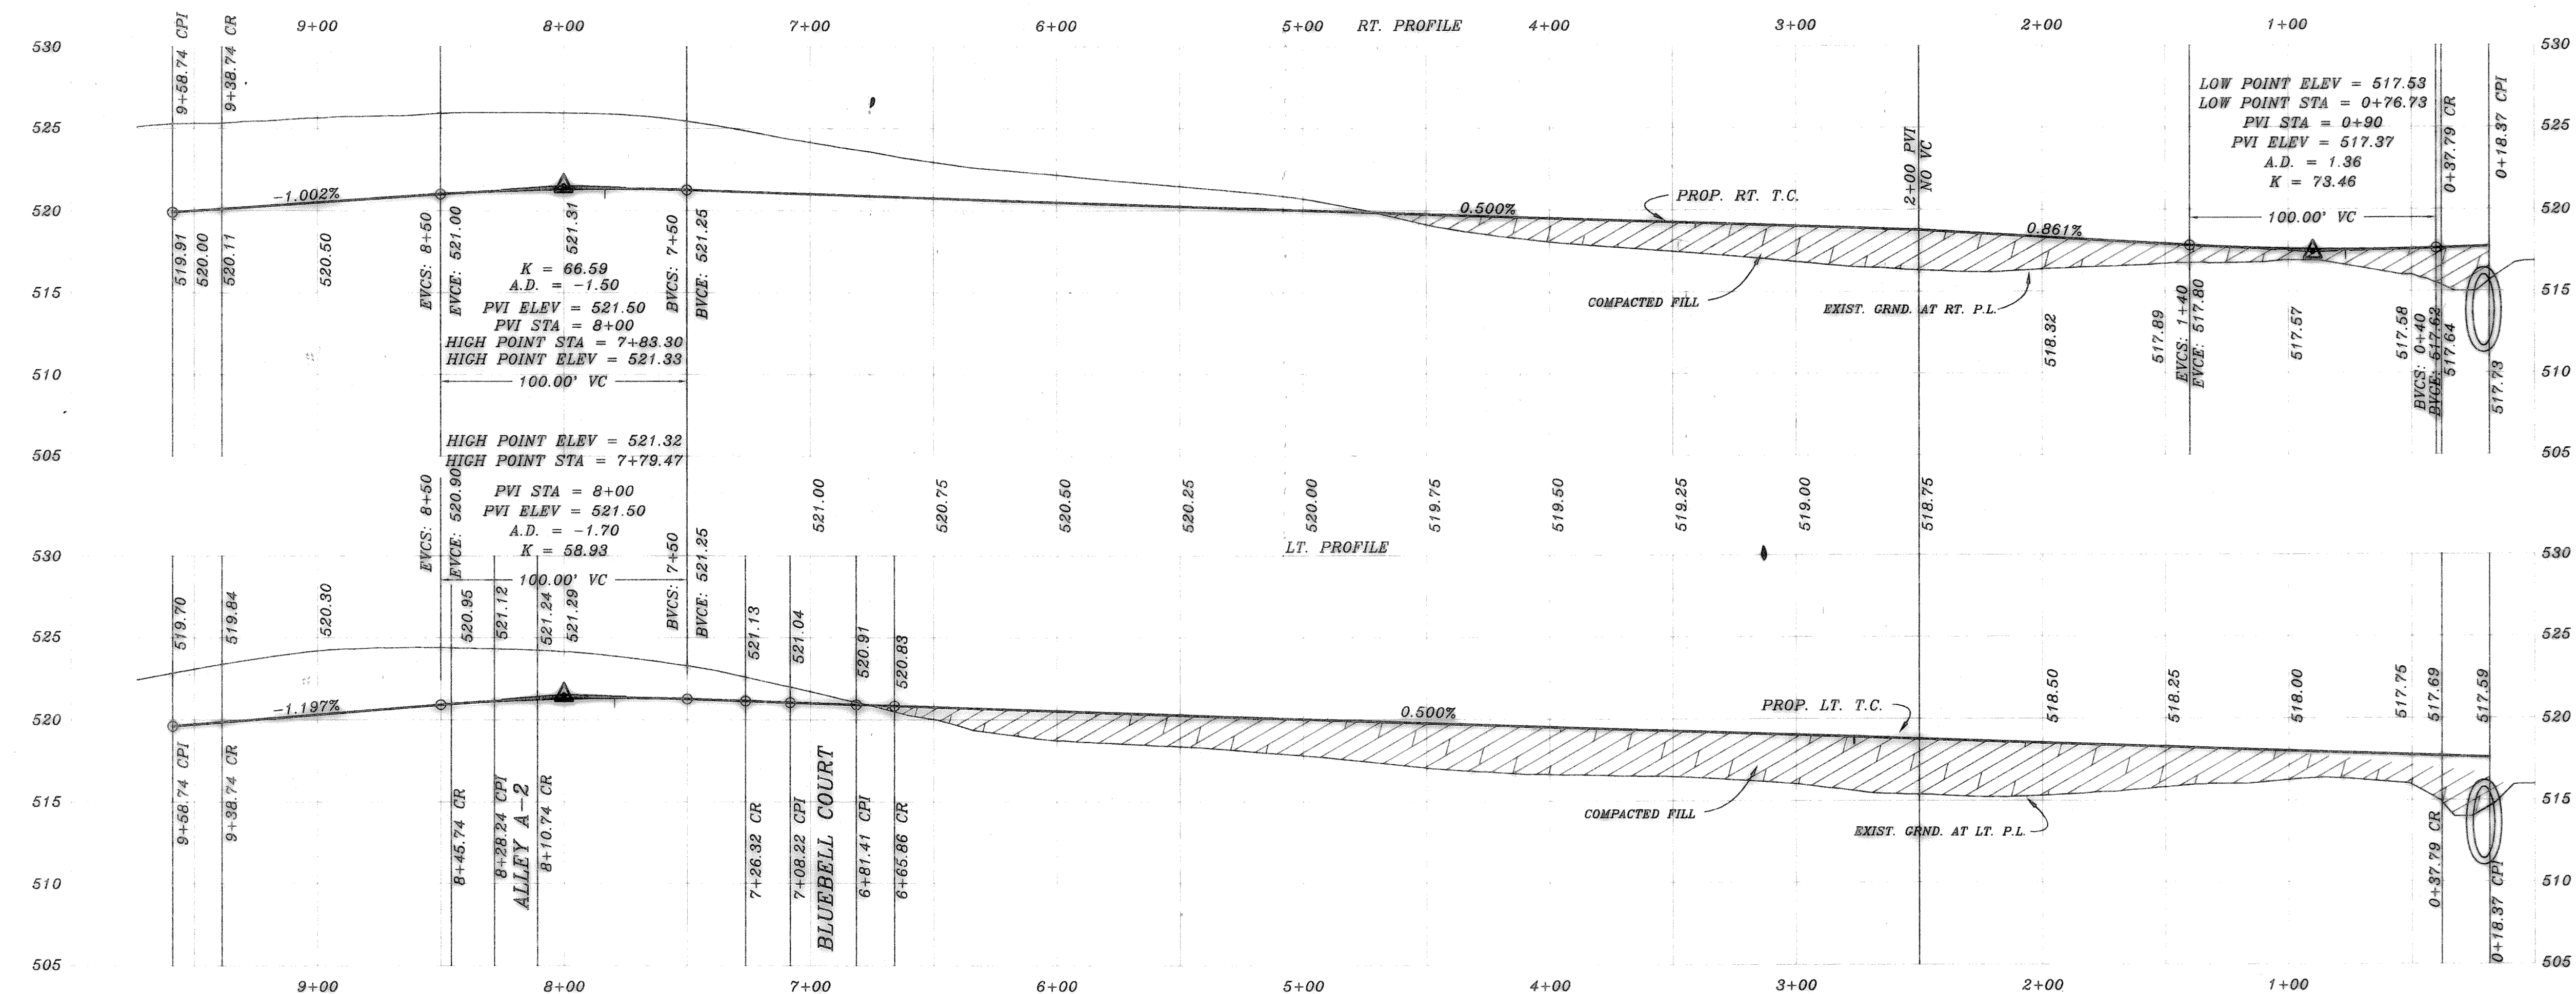


CURVE	RADIUS	LENGTH	TANGENT	CHORD	BEARING	DELTA
C1	584.21'	250.08'	126.99'	248.18'	S22°55'06"W	24°31'36"
C2	175.00'	102.56'	52.80'	101.10'	N27°26'39"E	33°34'44"

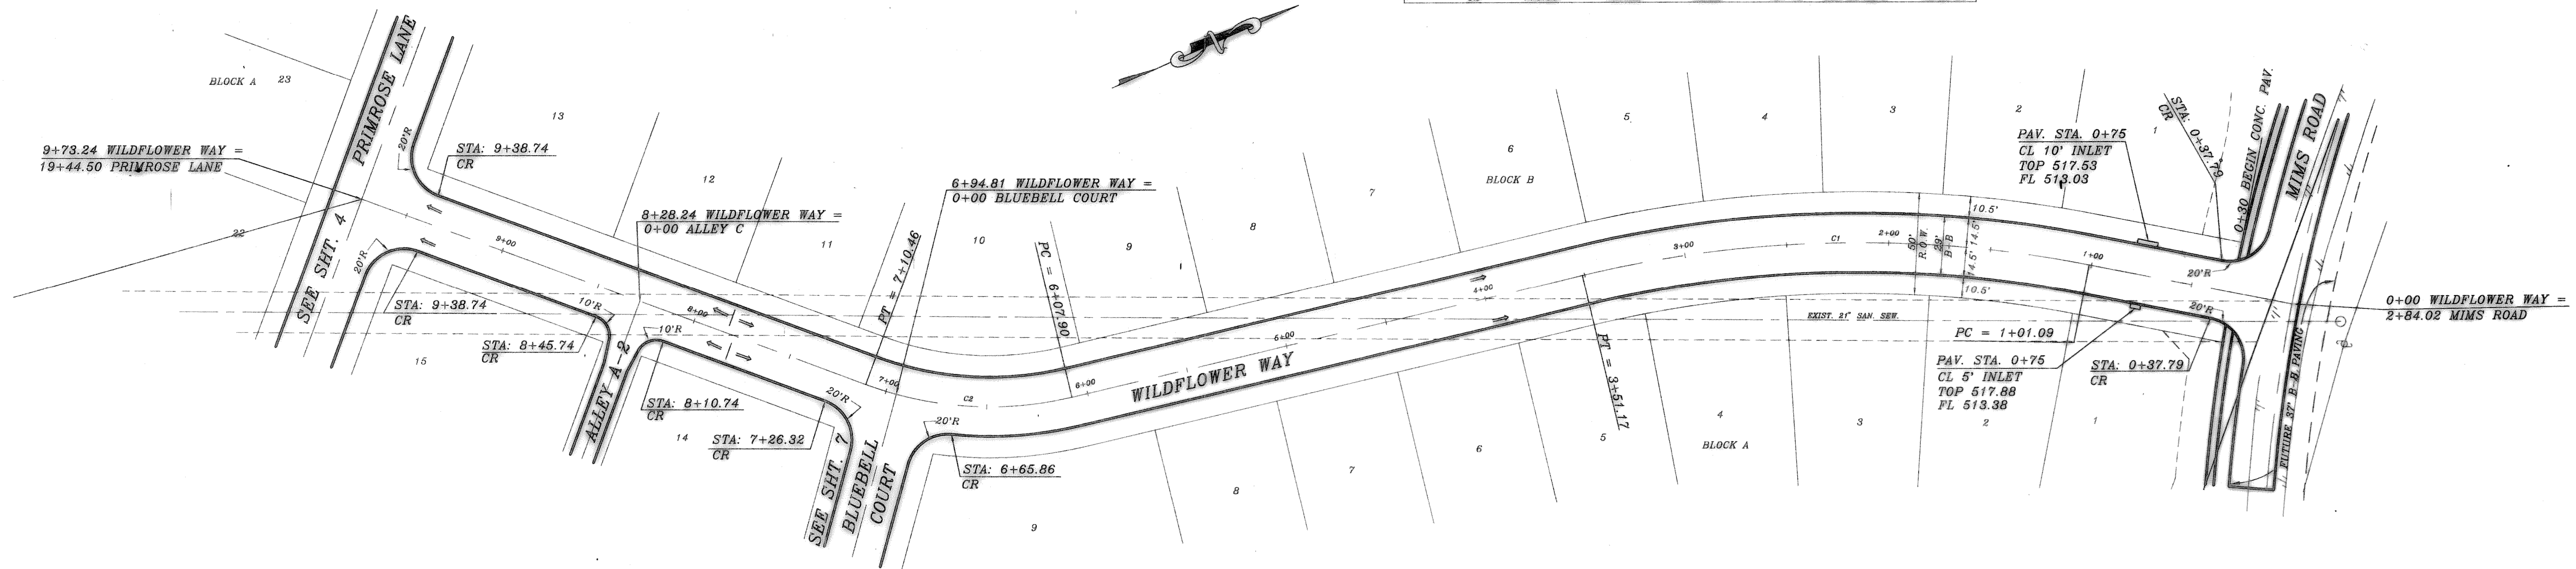

B.M.
TOP OF EXIST. SAN. SEW. M.H.
LOCATED AT PAV. STA. -(0+25), 4' LT.
WILDFLOWER WAY
ELEVATION = 515.72

B.M.
TOP OF EXIST. M.H. AT WEST
CORNER OF LOT 20, BLOCK A, OF
HIGHLAND MEADOWS
ELEVATION = 514.85

REV. PER 2nd CITY REVIEW REV. PER CITY REVIEW		DATE 7/10/95	SCALE 1" = 40' 1" = 6'	DESIGN H.L.E.	DRAWN
--	--	-----------------	------------------------------	------------------	-------

HAROLD L. EVANS CONSULTING ENGINEER P.O. BOX 28355 2331 CUS. THOMASSON ROAD, SUITE 102 DALLAS, TEXAS 75226 (214) 328-8133		PROPOSED PAVING WILDFLOWER WAY HIGHLAND MEADOWS NO.1 CITY OF ROCKWALL	SHEET NO. 3 JOB NO. 9563
---	--	--	-----------------------------------