
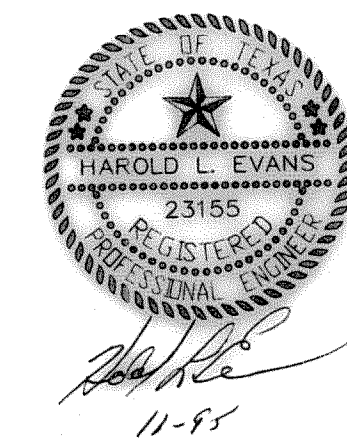
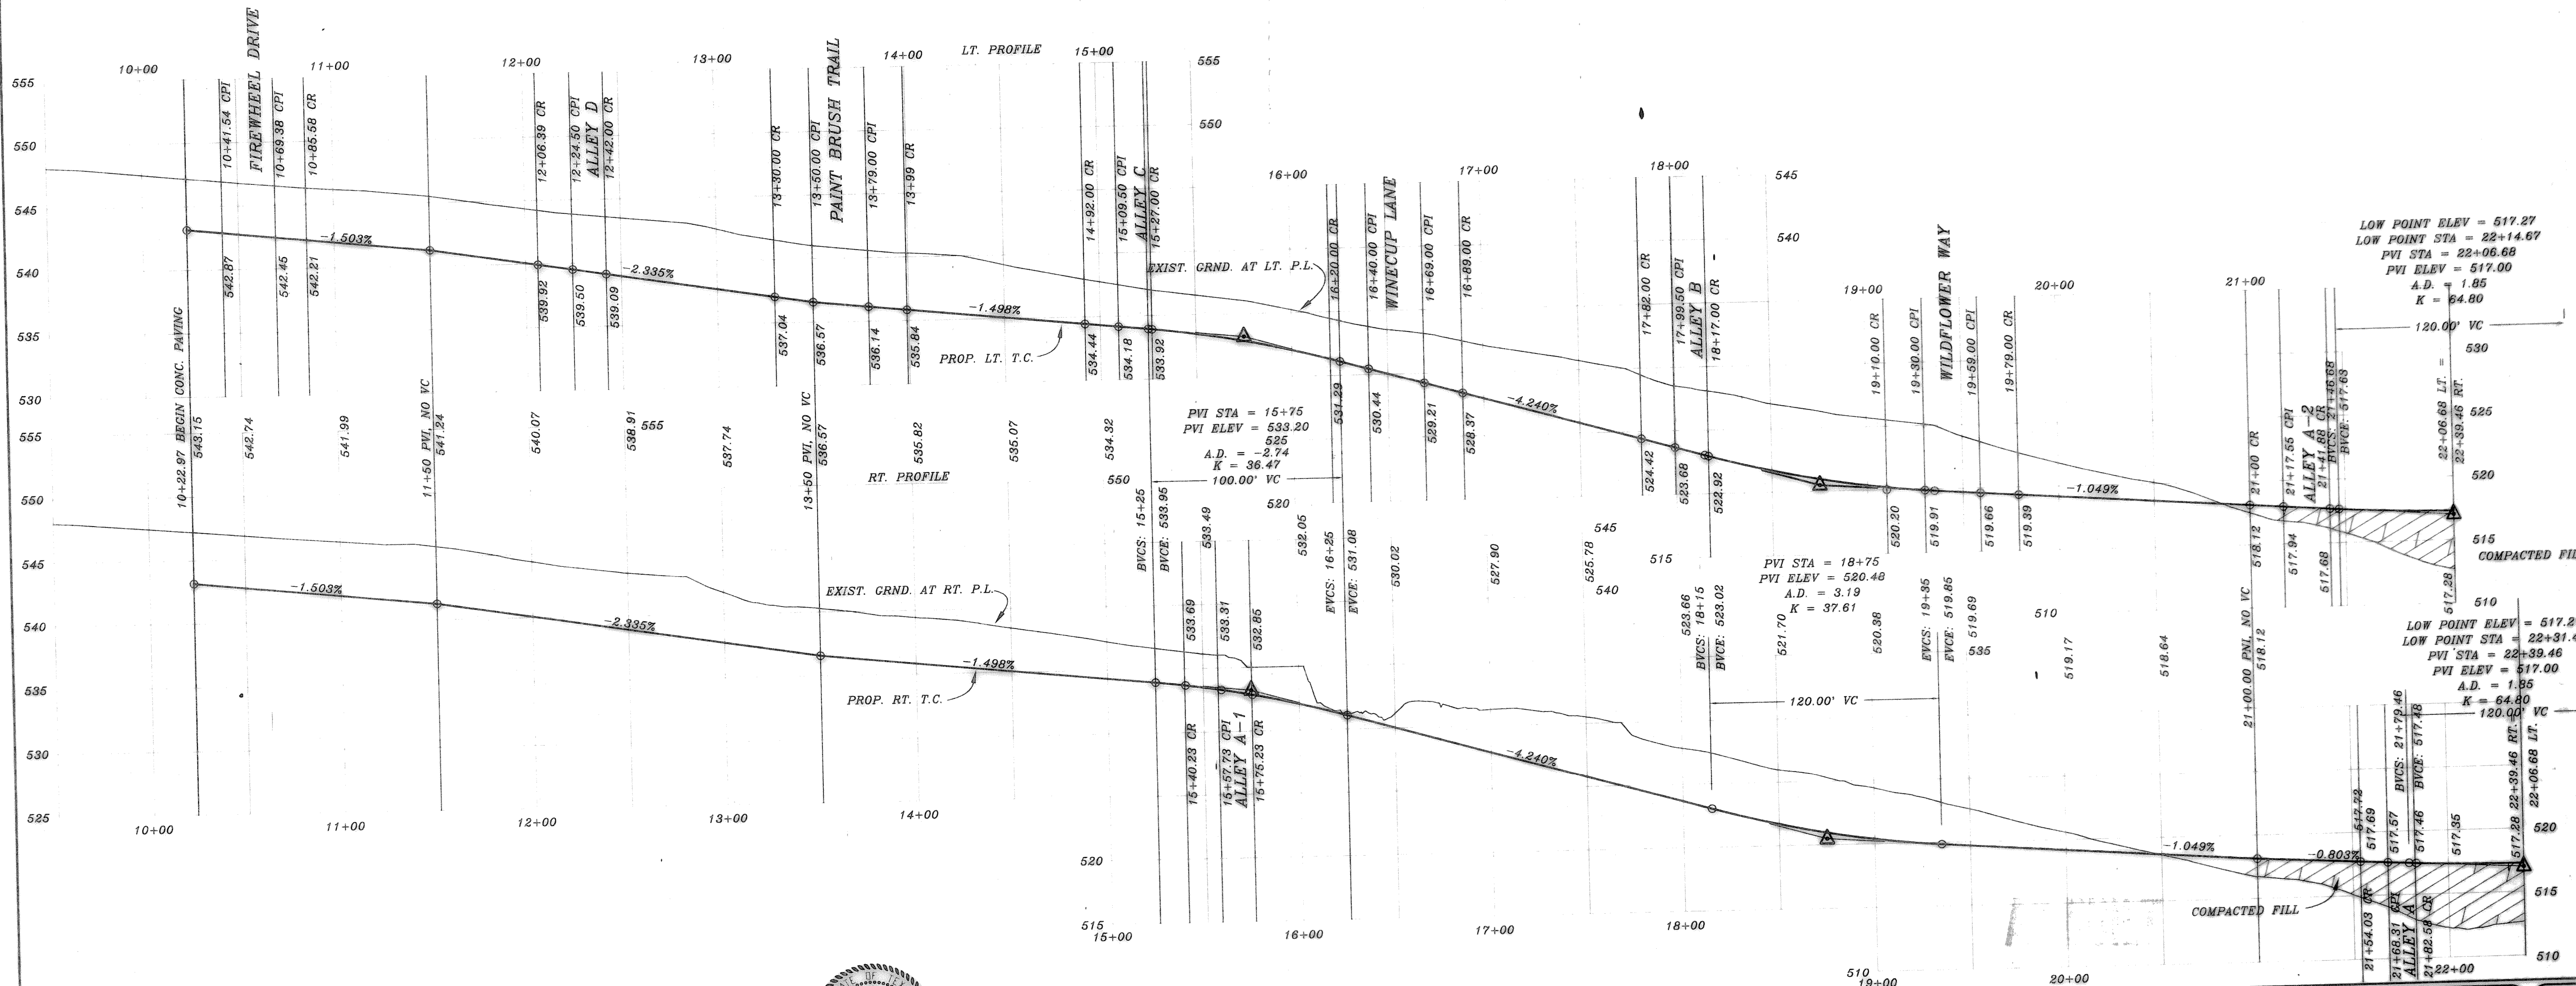


CURVE	RADIUS	LENGTH	TANGENT	CHORD	BEARING	DELTA
C1	39.50'	64.80'	42.36'	57.78'	N10°04'38" W	94°00'04"
C2	39.50'	56.88'	34.82'	52.09'	N69°10'36" E	82°30'23"
C3	39.50'	33.15'	17.62'	32.18'	S04°07'21" E	48°04'49"

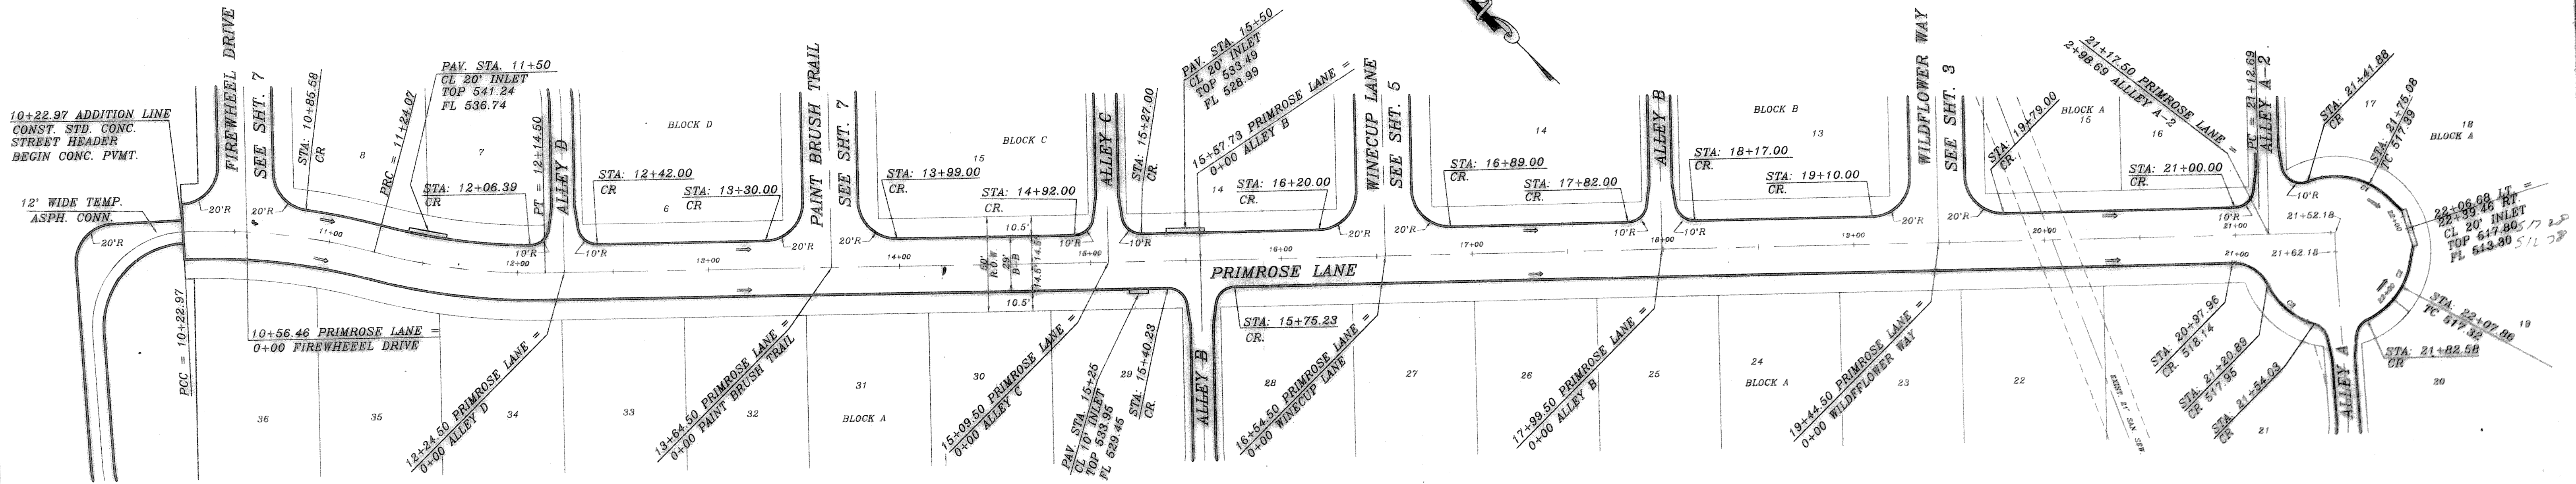

B.M.
TOP OF EXIST. SAN. SEW. M.H.
LOCATED AT PAV. STA. -(0+25), 4' LT.
WILDFLOWER WAY
ELEVATION = 515.72

B.M.
TOP OF EXIST. M.H. AT WEST
CORNER OF LOT 20, BLOCK A, OF
HIGHLAND MEADOWS
ELEVATION = 514.85

REVISION DESCRIPTION 11-15		DATE 7/10/95		SCALE 1" = 40' 1" = 6'		DESIGN H.L.E.		DRAWN	
-------------------------------	--	-----------------	--	------------------------------	--	------------------	--	-------	--

REV. PER 2nd CITY REVIEW 11/4/95		REV. PER CITY REVIEW 8/14/95		HAROLD L. EVANS CONSULTING ENGINEER P.O. BOX 28855 2331 CUS THOMASSON ROAD, SUITE 102 DALLAS, TEXAS 75228, (214) 328-8133		PROPOSED PAVING PRIMROSE LANE HIGHLAND MEADOWS NO. 1 CITY OF ROCKWALL	
-------------------------------------	--	---------------------------------	--	---	--	--	--

SHEET NO. 4	JOB NO. 9563
----------------	-----------------