
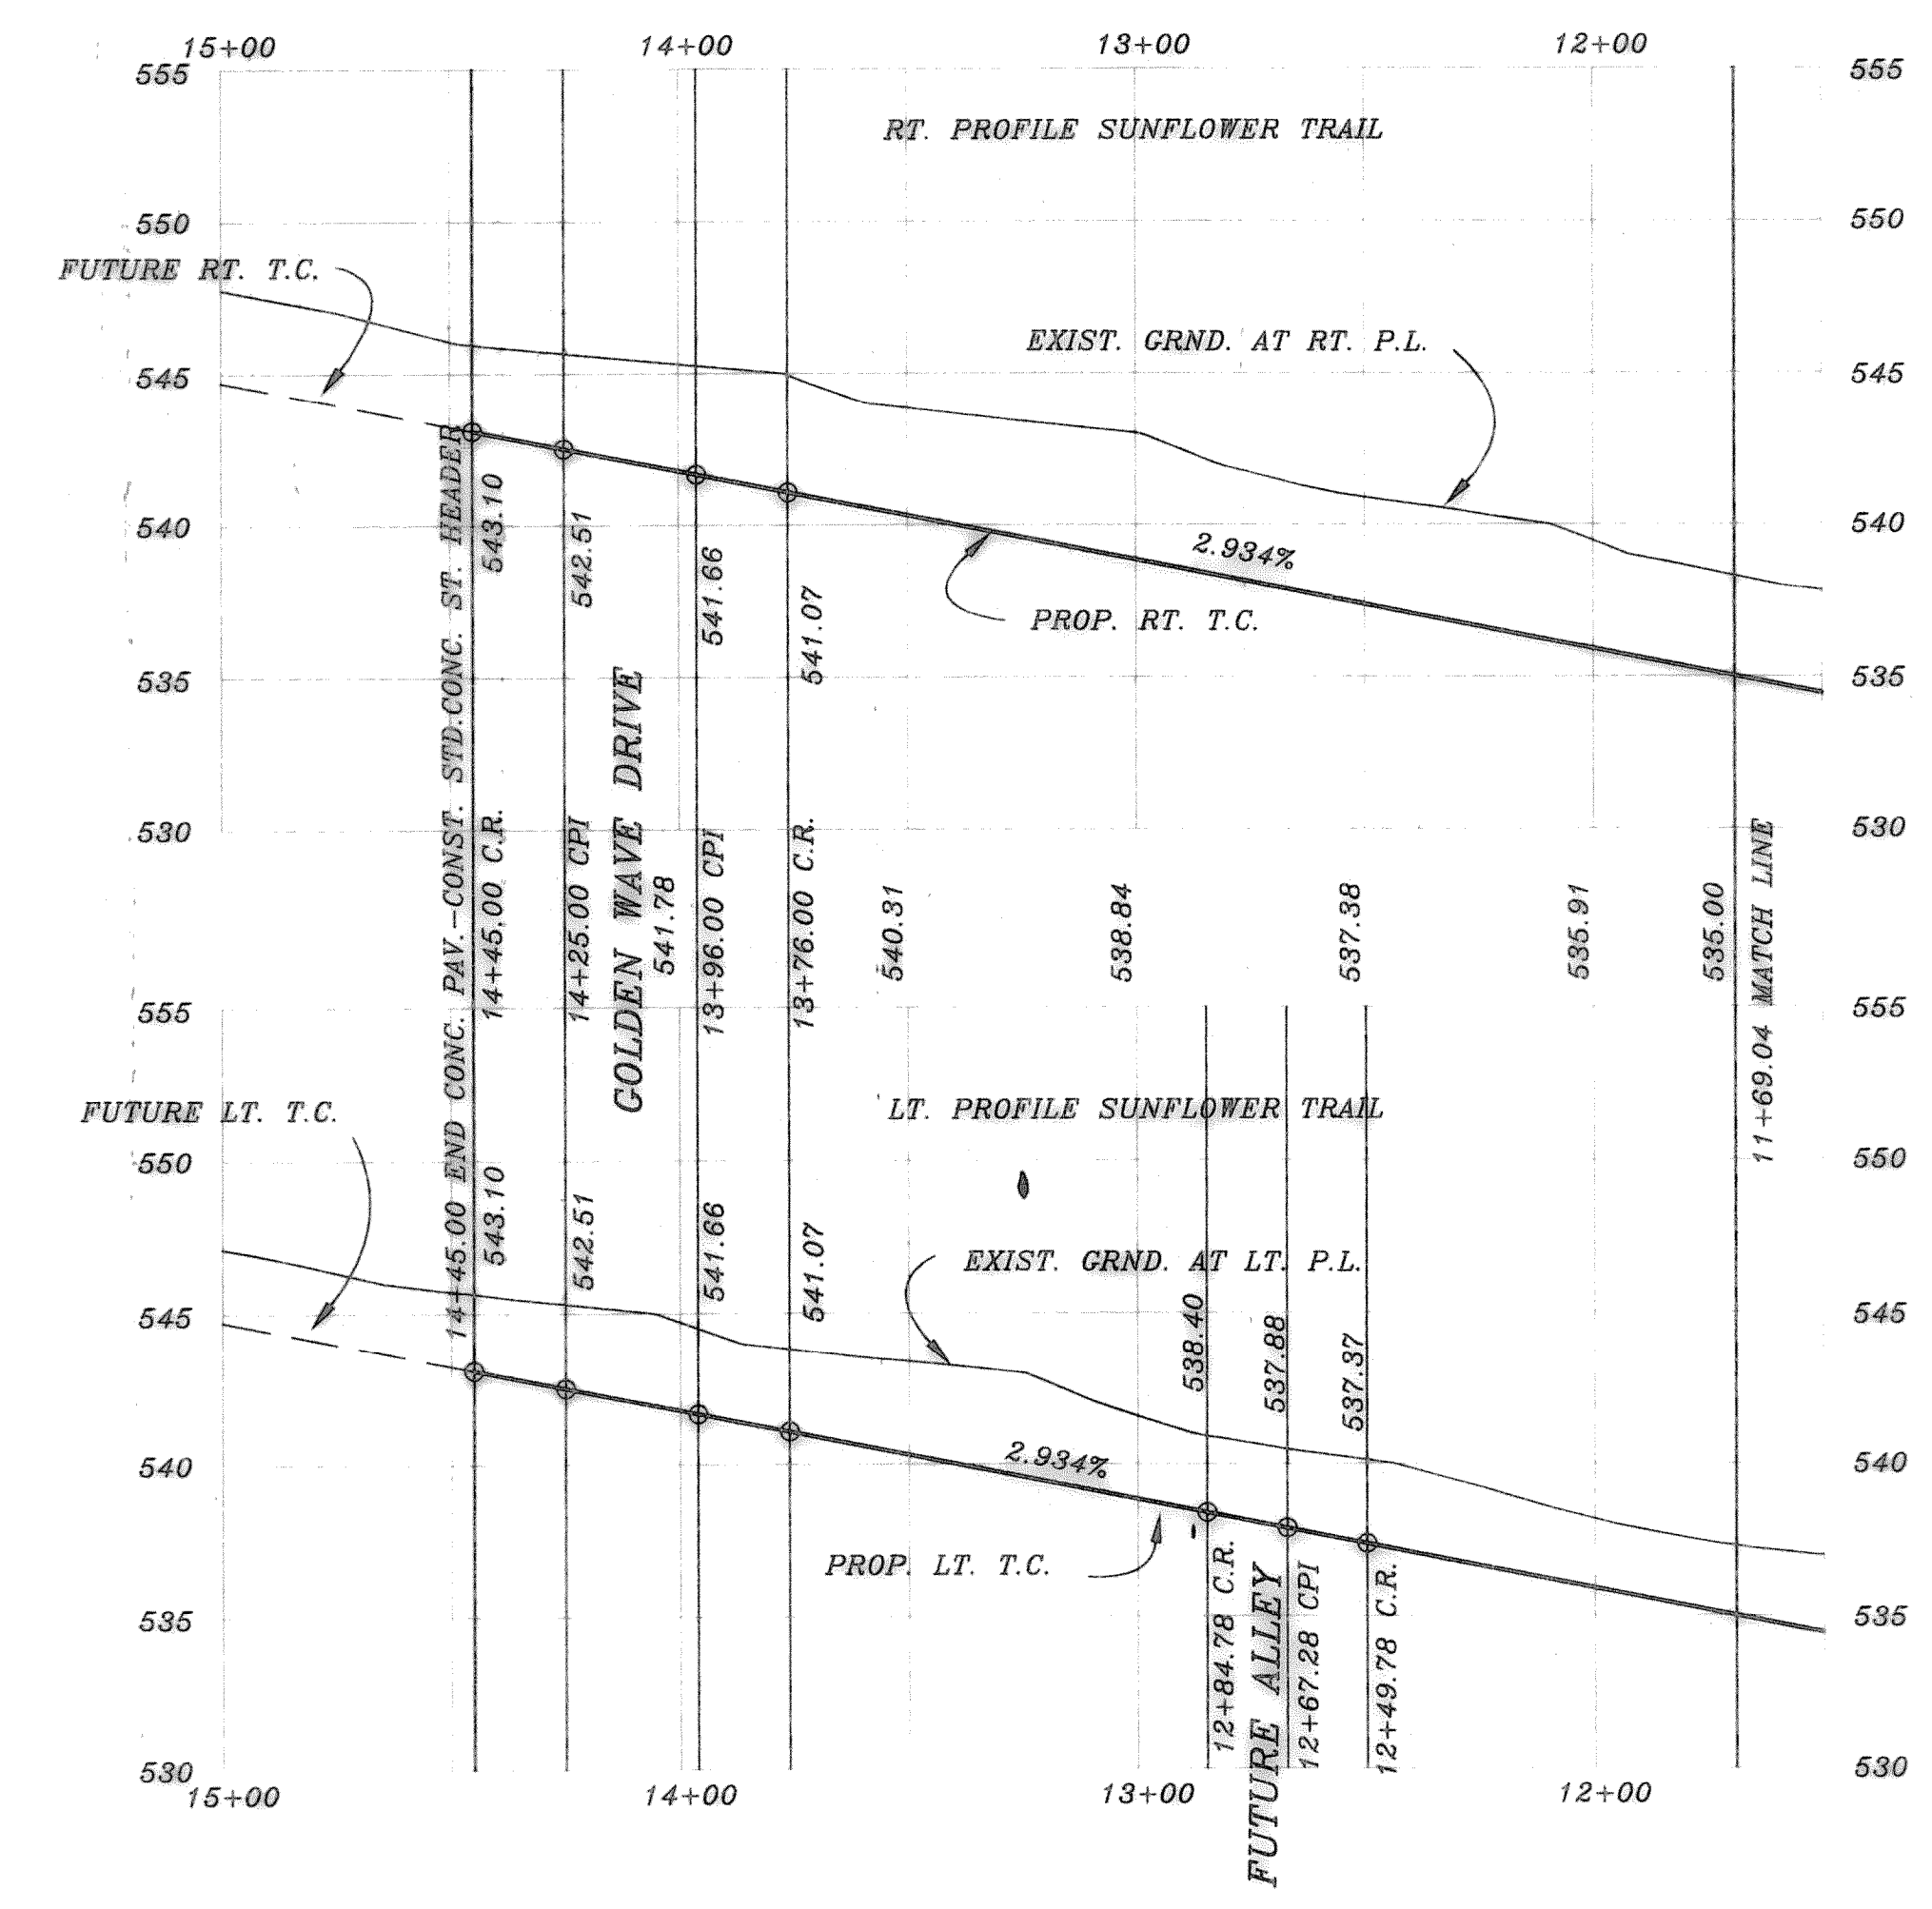
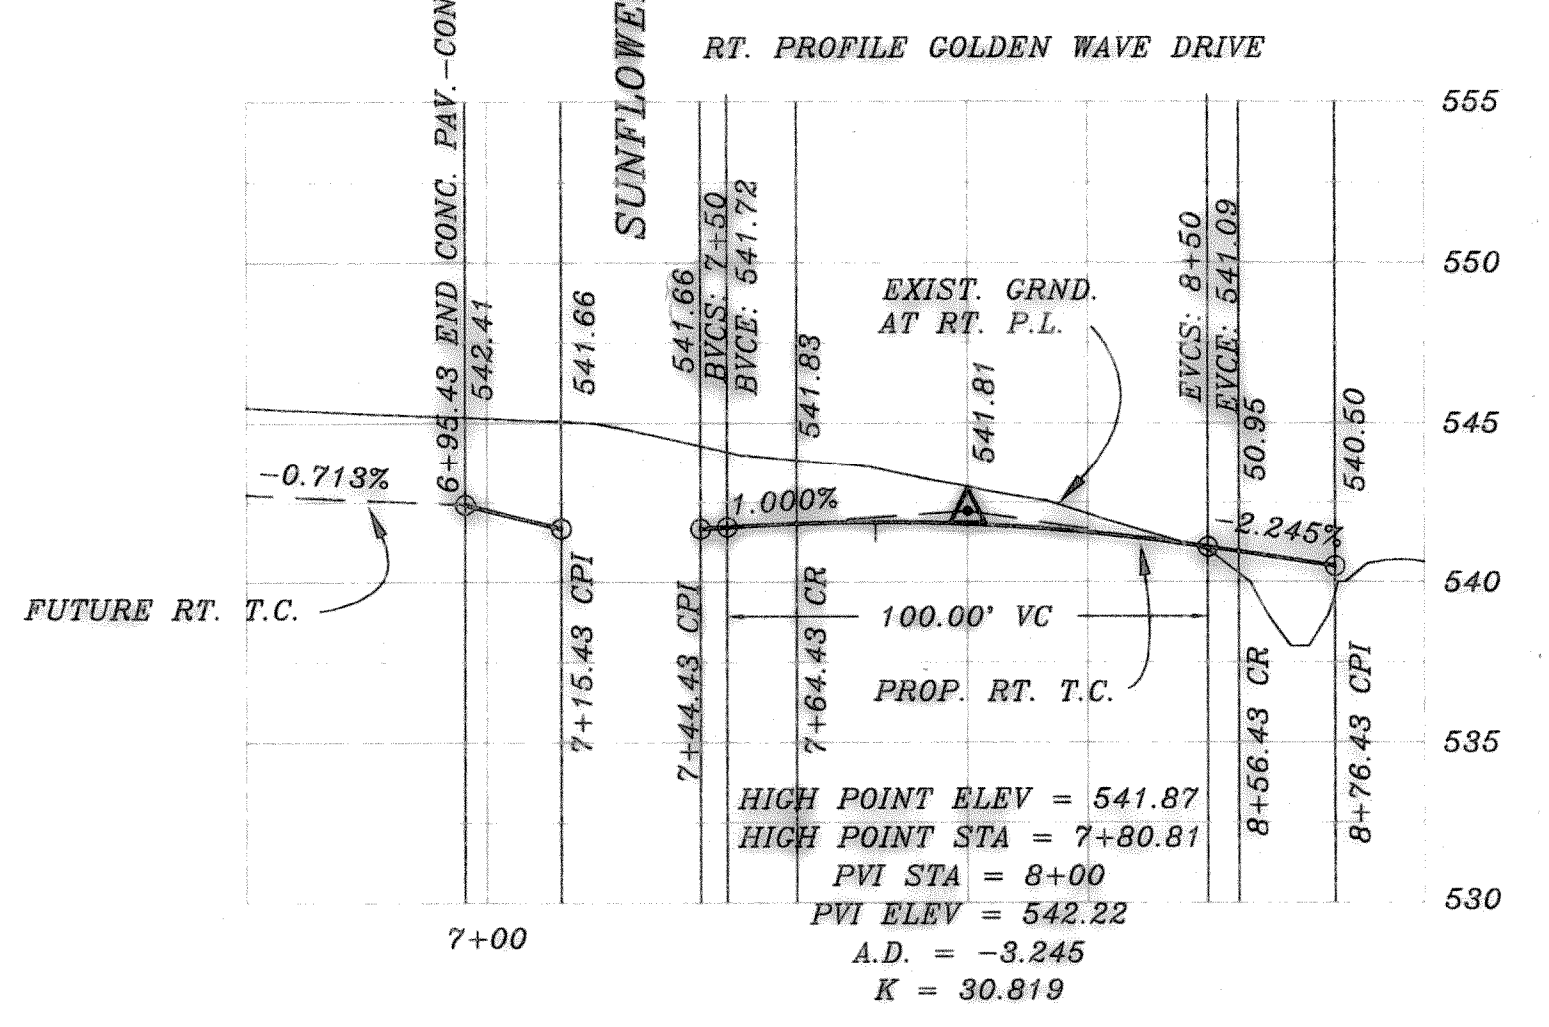
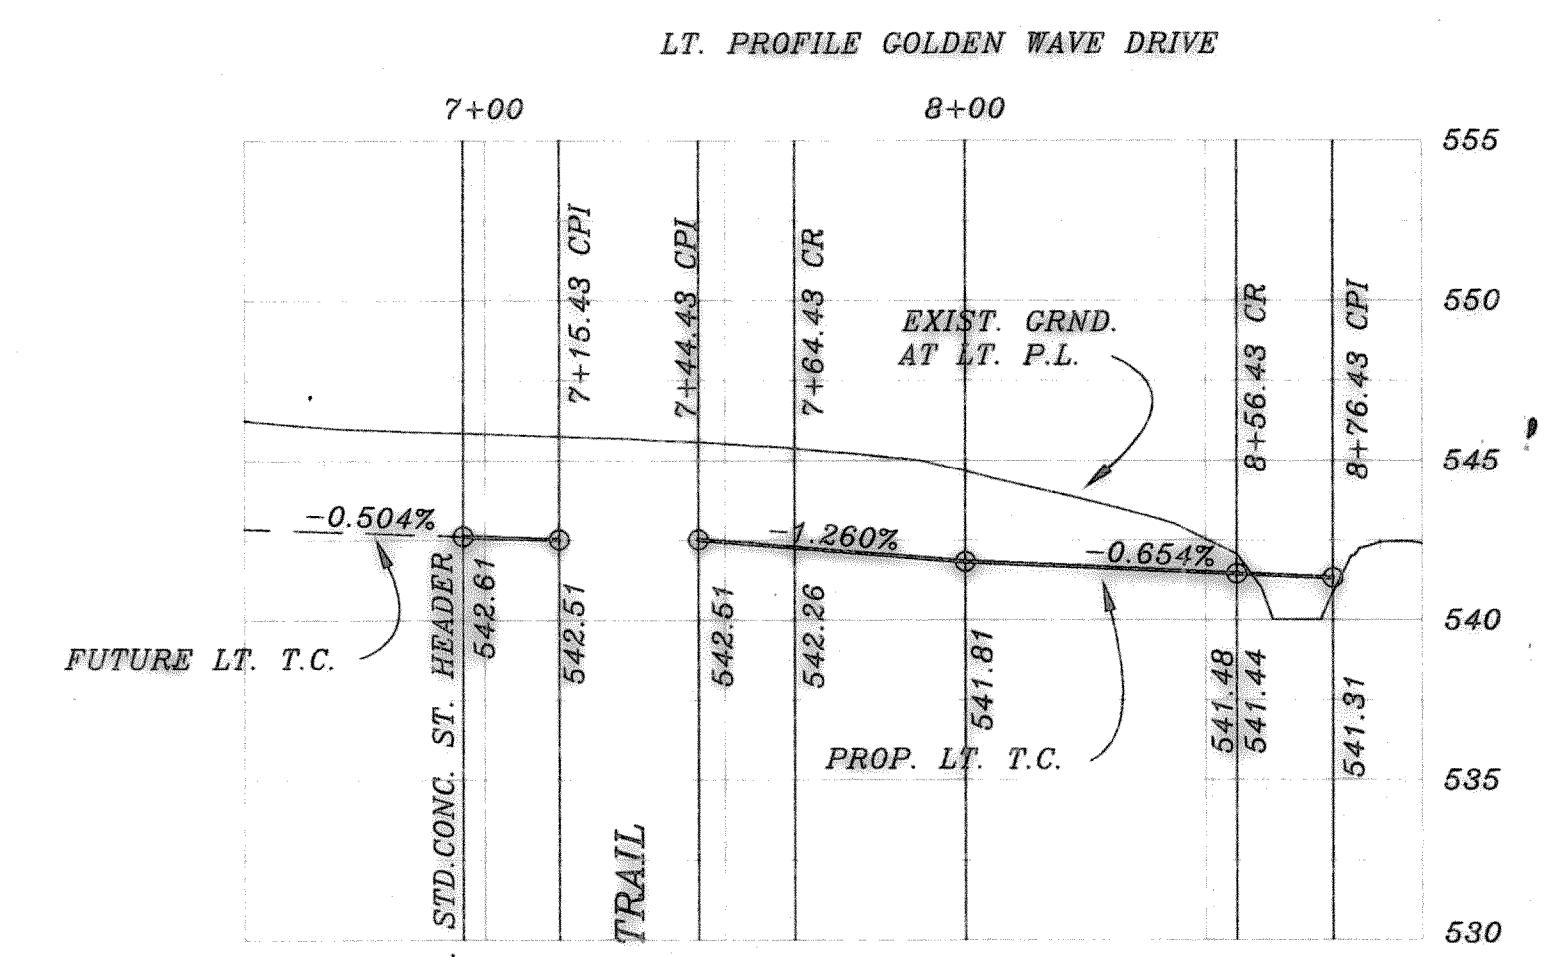


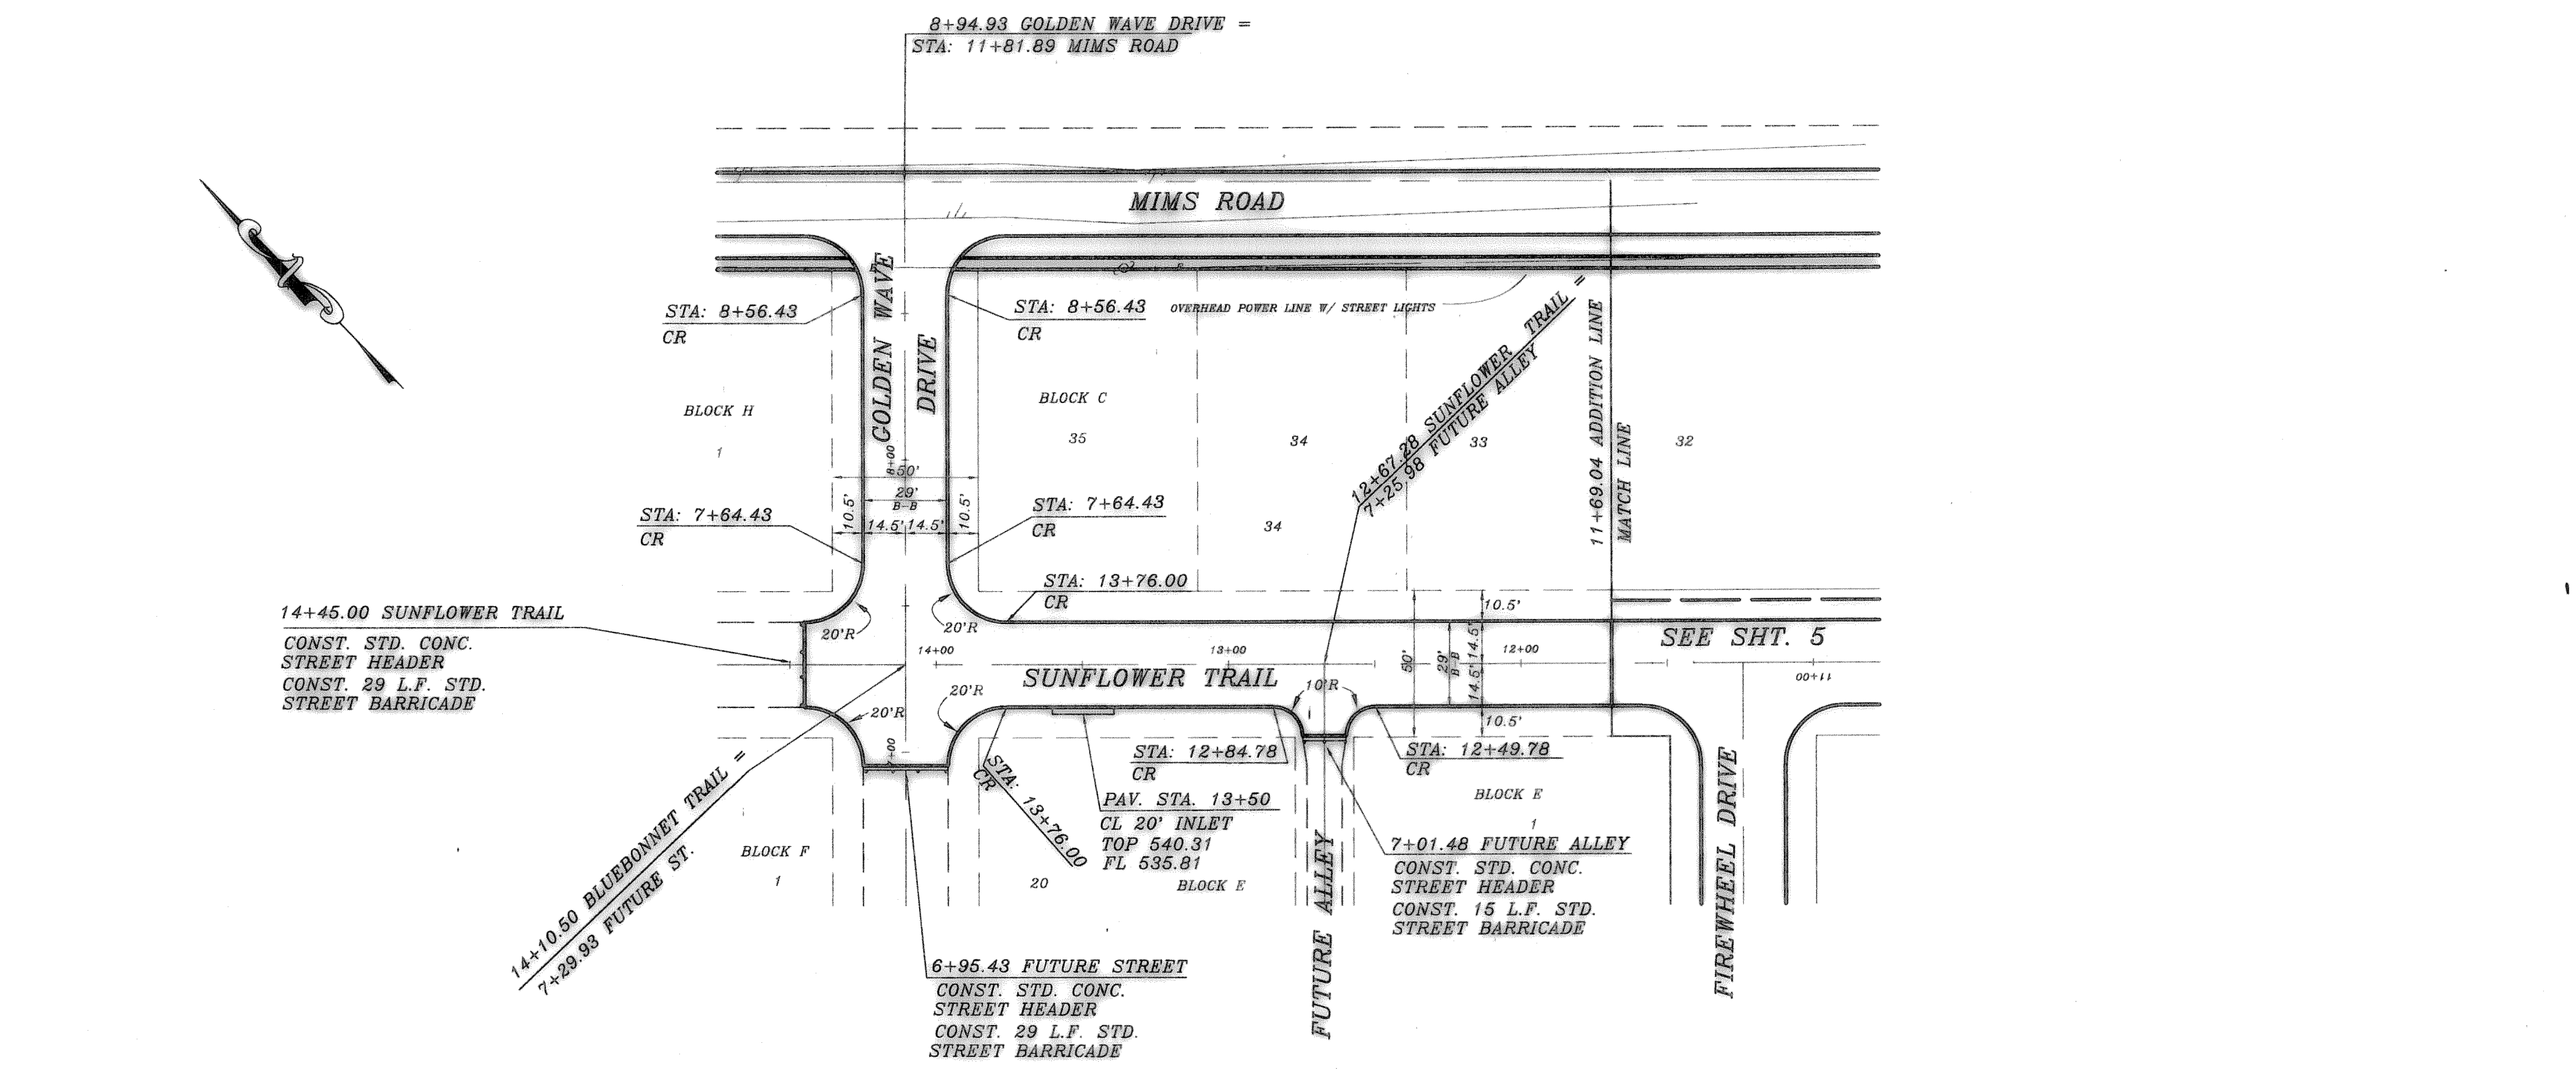


REVISION	DESCRIPTION	DATE	SCALE	DESIGN	DRAWN
1	REV. PER 2nd CITY REVIEW	11/14/95	1" = 40'	H.L.E.	
2	REV. PER CITY REVIEW	6/14/95	1" = 6'		
3		7/10/95			

H.M.
TOP OF EXIST. SAN. SEW. M.H.
LOCATED AT PAV. STA. -(0+25), 4' LT.
WILDFLOWER WAY
ELEVATION = 516.72

H.M.
TOP OF EXIST. M.H. AT WEST
CORNER OF LOT 20, BLOCK A. OF
HIGHLAND MEADOWS
ELEVATION = 514.85

PROPOSED PAVING

SUNFLOWER TRAIL &
GOLDEN WAVE DRIVE
HIGHLAND MEADOWS NO. 1
CITY OF ROCKWALL

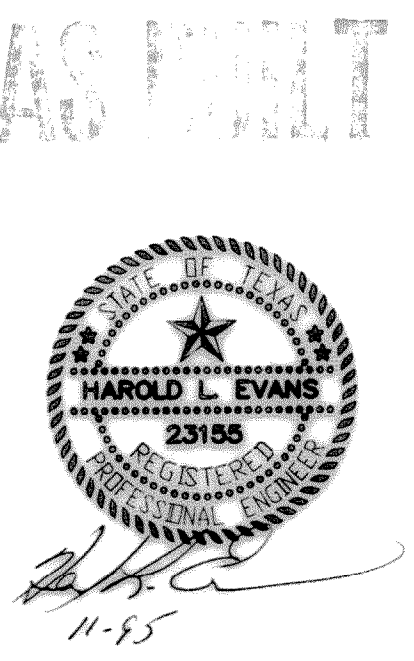

SHEET NO.
6
23
JOB NO.
9563