
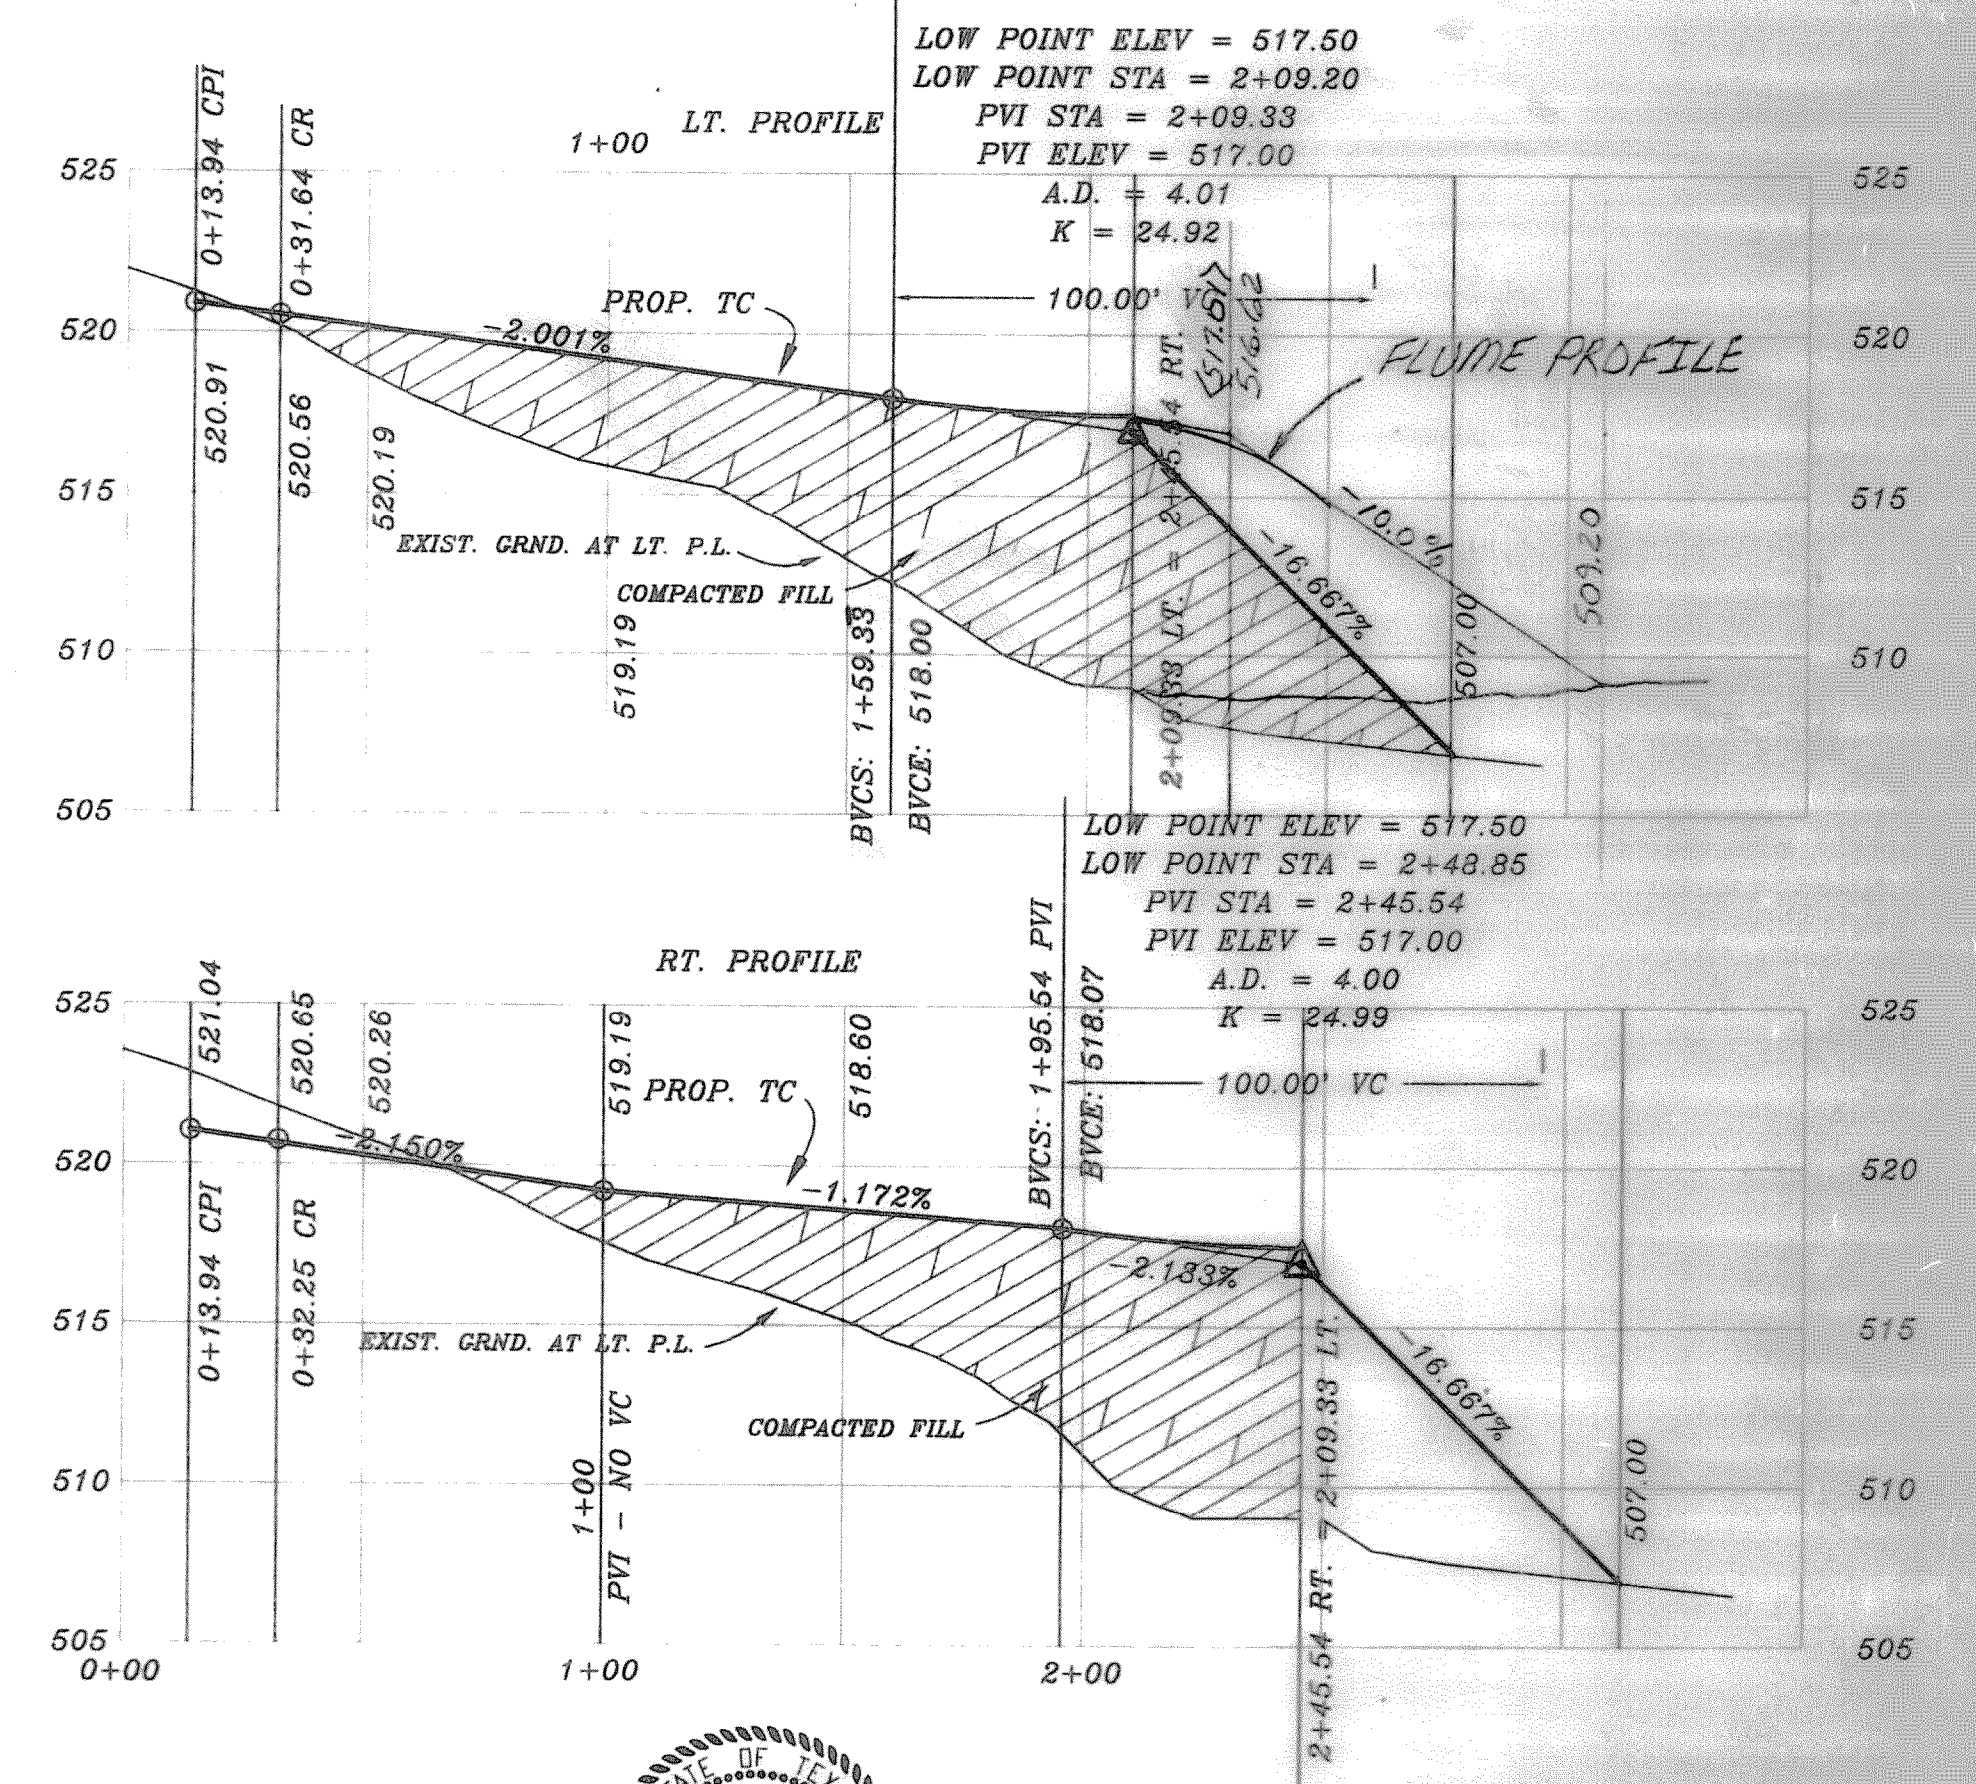
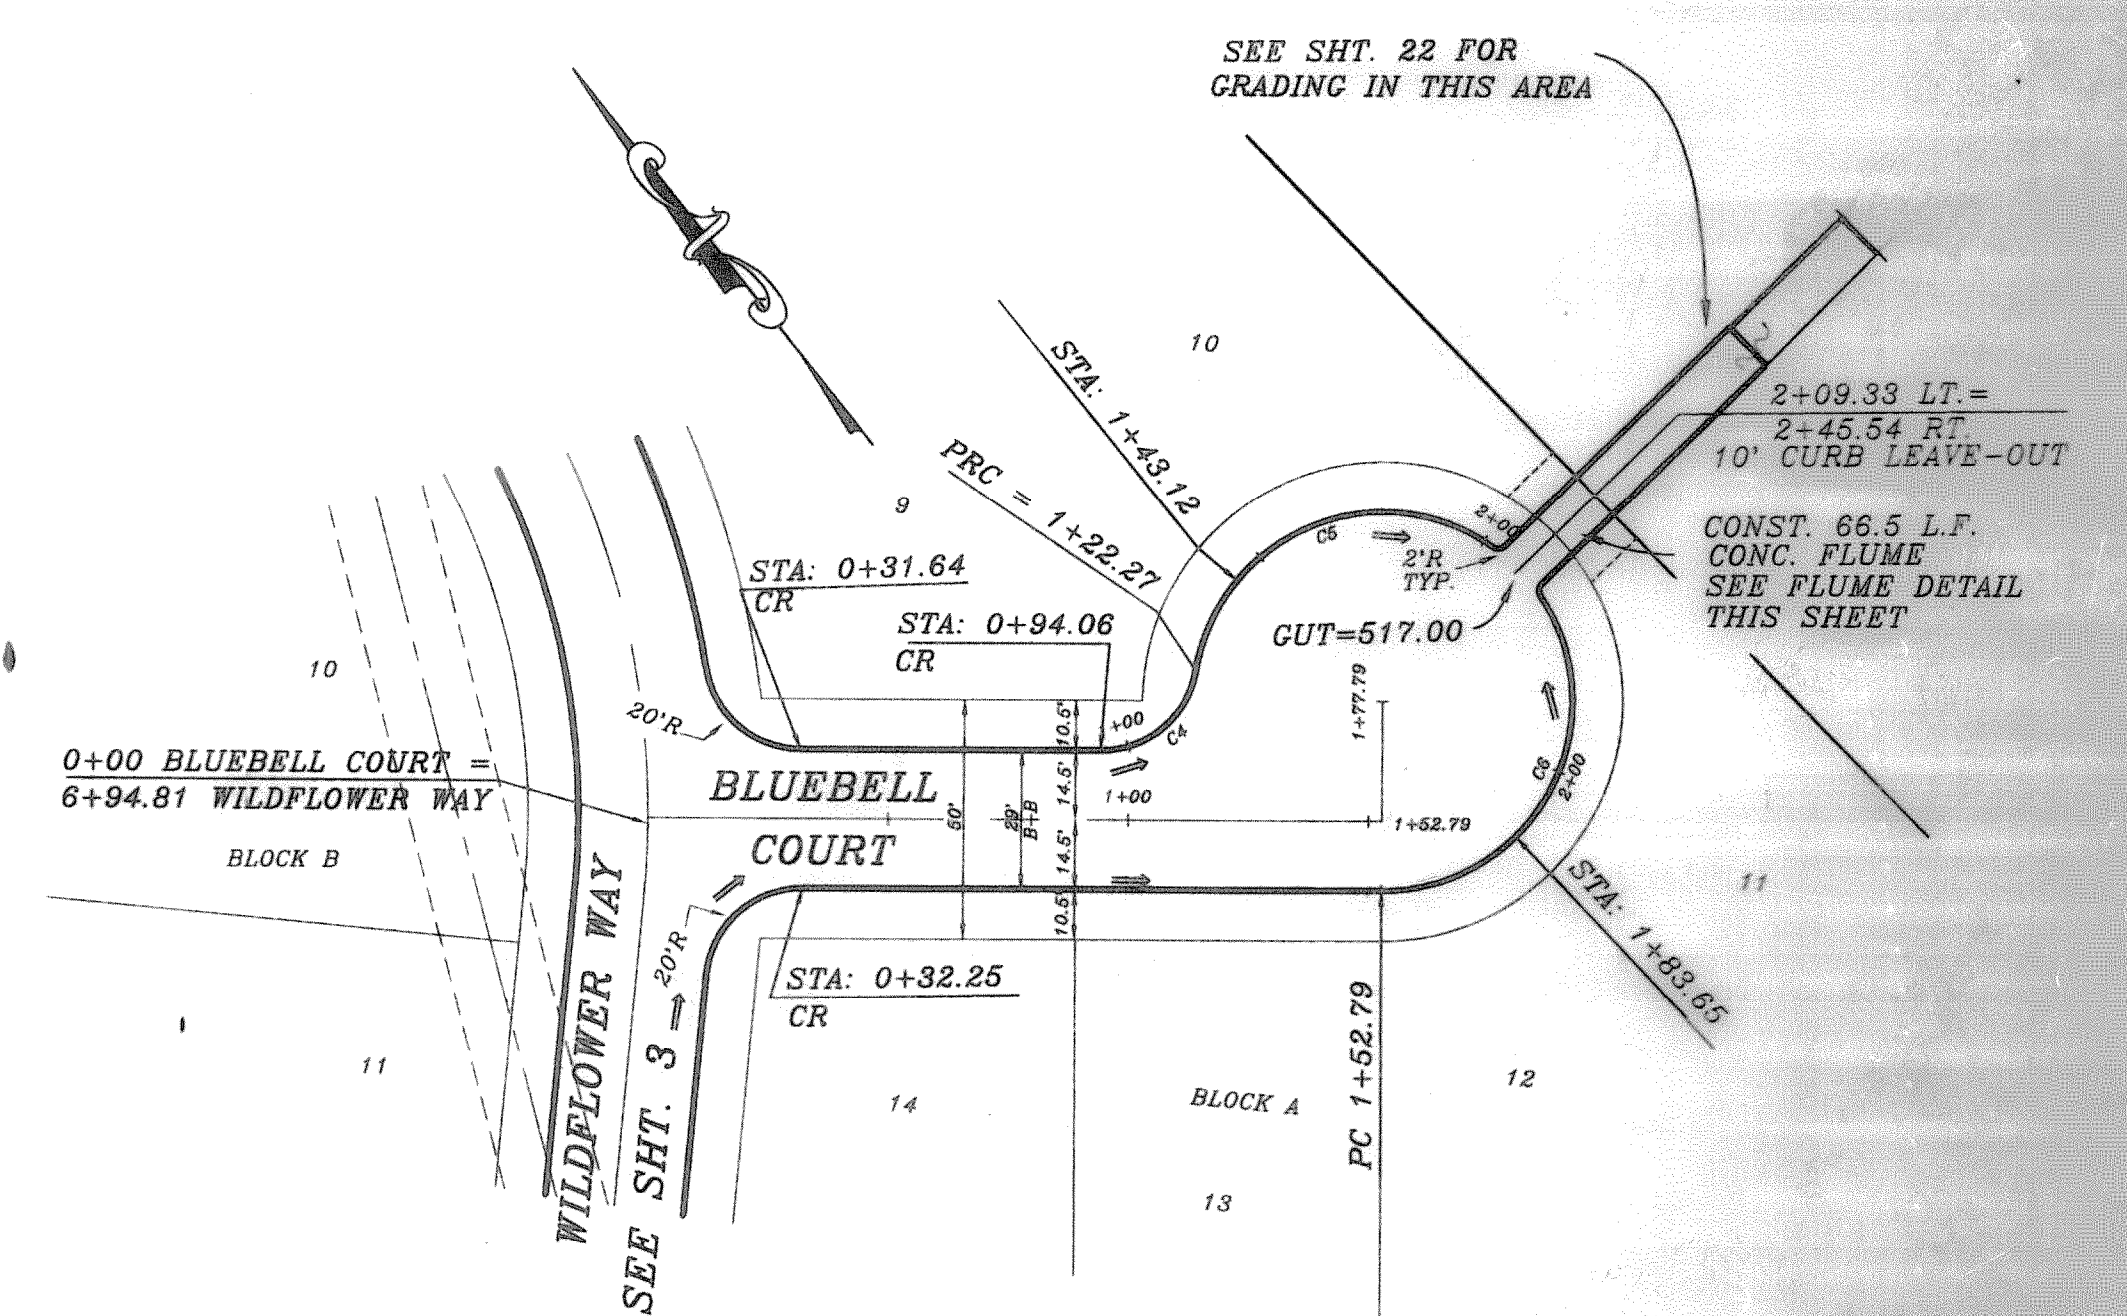


[illegible]

|                           | 9668PWS  |
|---------------------------|----------|
|                           |          |
|                           |          |
| REV. PER 2nd. CITY REVIEW | 11/4/95  |
| REV. PER CITY REVIEW      | 10/16/95 |
|                           |          |
| REVISION DESCRIPTION      | DATE     |
|                           | 7/10/95  |

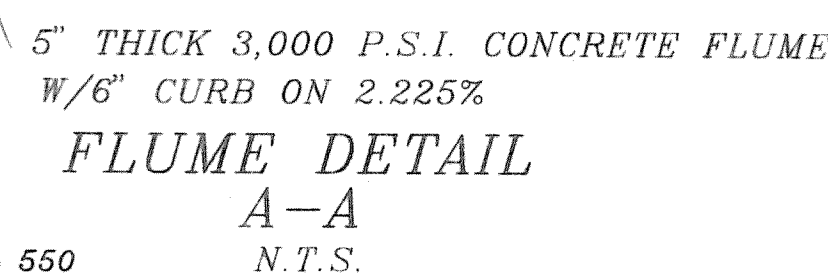

|                                  |
|----------------------------------|
| PROPOSED PAVING                  |
| PAINT BRUSH TRAIL-BLUEBELL COURT |
| HIGHLAND MEADOWS NO. 1           |
| CITY OF ROCKWALL                 |

SHEET NO.  
8  
23  
JOB NO.  
9563