
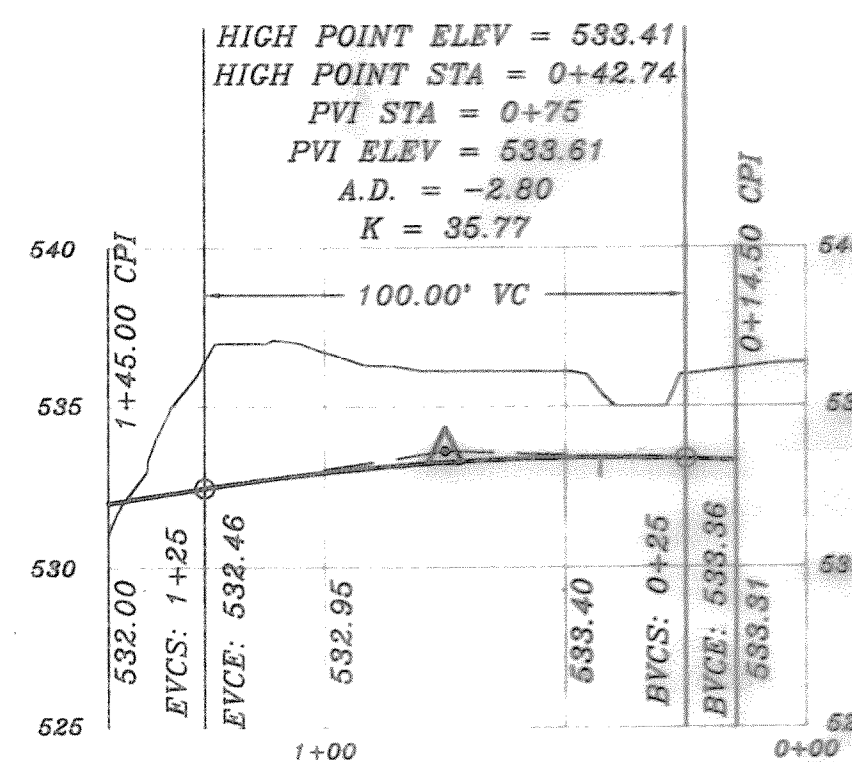
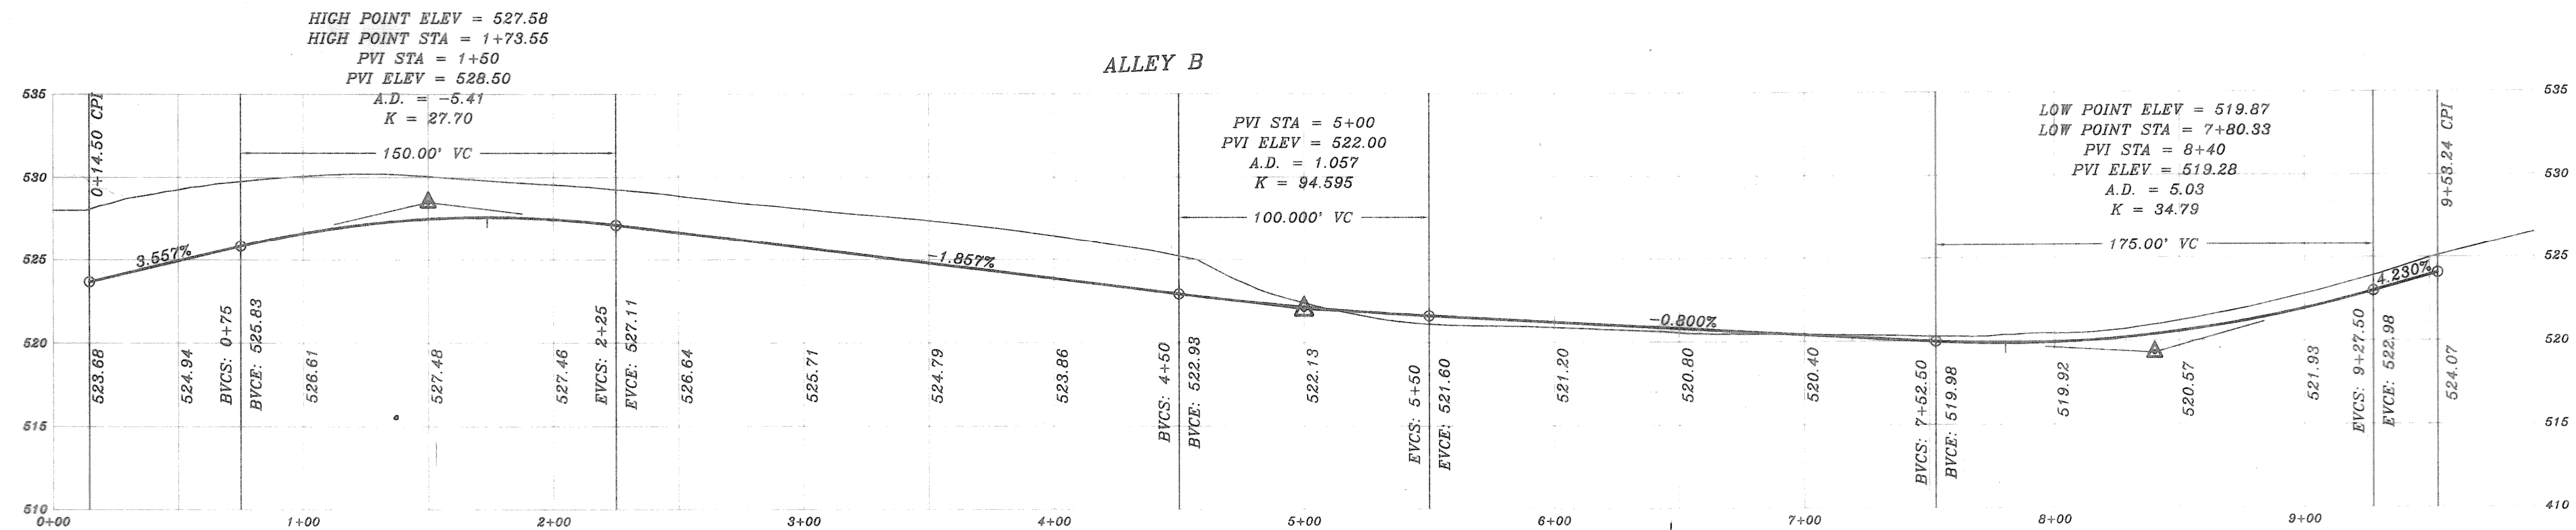
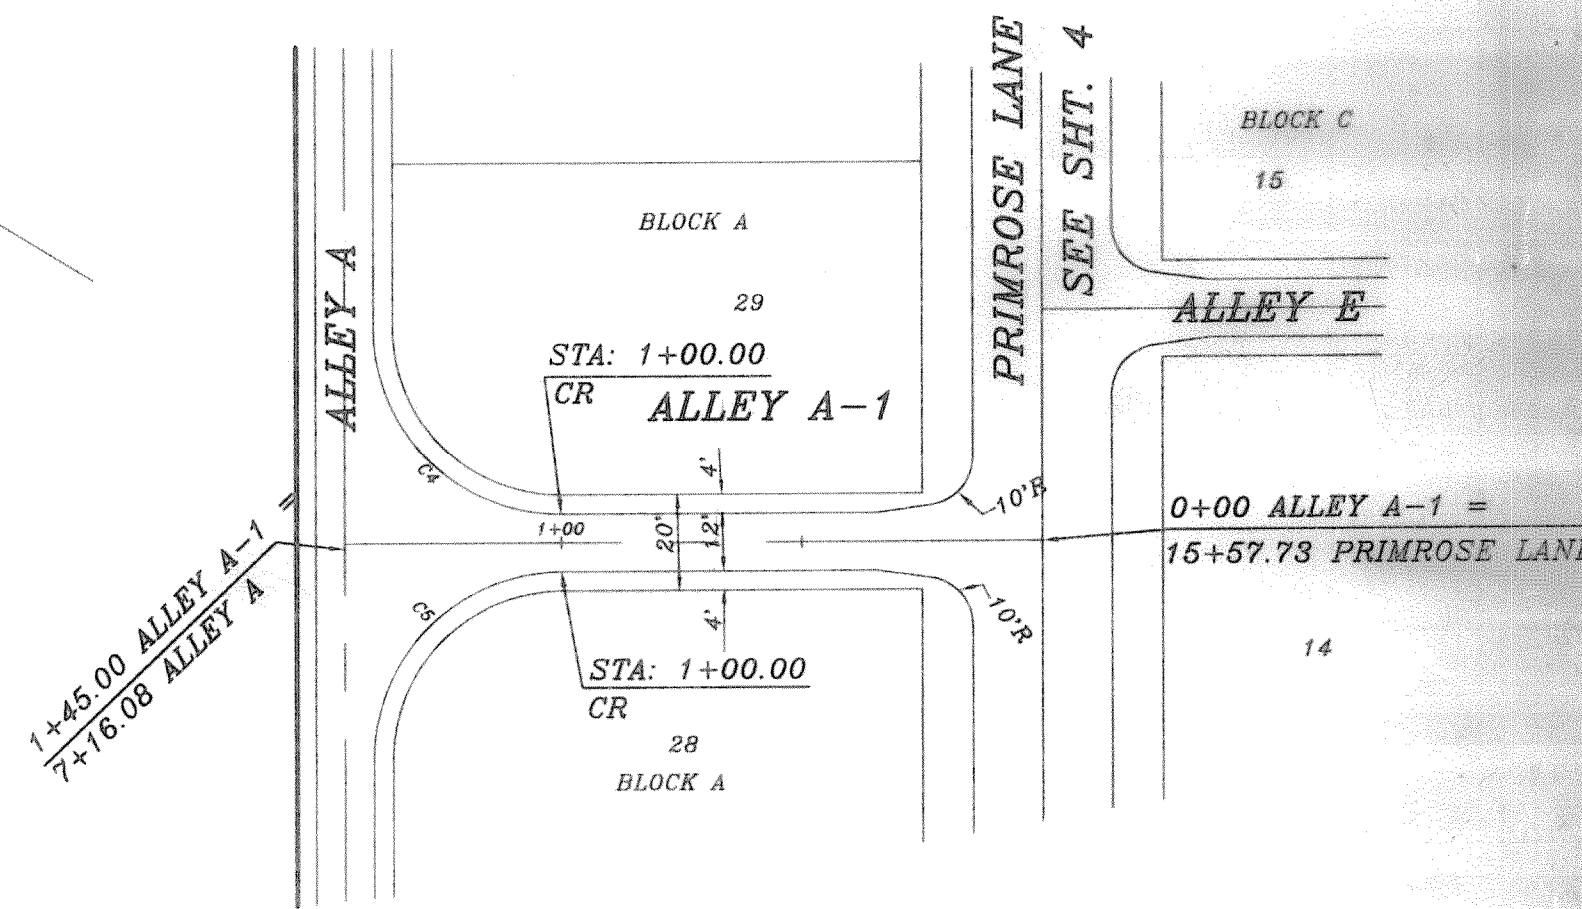


CURVE	RADIUS	LENGTH	TANGENT	CHORD	BEARING	DELTA
C1	140.00'	82.05'	42.24'	80.88'	N27°26'39" E	33°34'42"
C2	723.21'	288.44'	134.72'	284.96'	S27°02'21" W	30°56'06"
C3	45.00'	79.68'	55.03'	69.67'	N19°08'06" W	101°26'59"
C4	39.00'	61.26'	39.00'	55.15'	N89°14'00" E	90°00'00"
C5	39.00'	61.26'	39.00'	55.16'	S00°46'00" E	90°00'06"

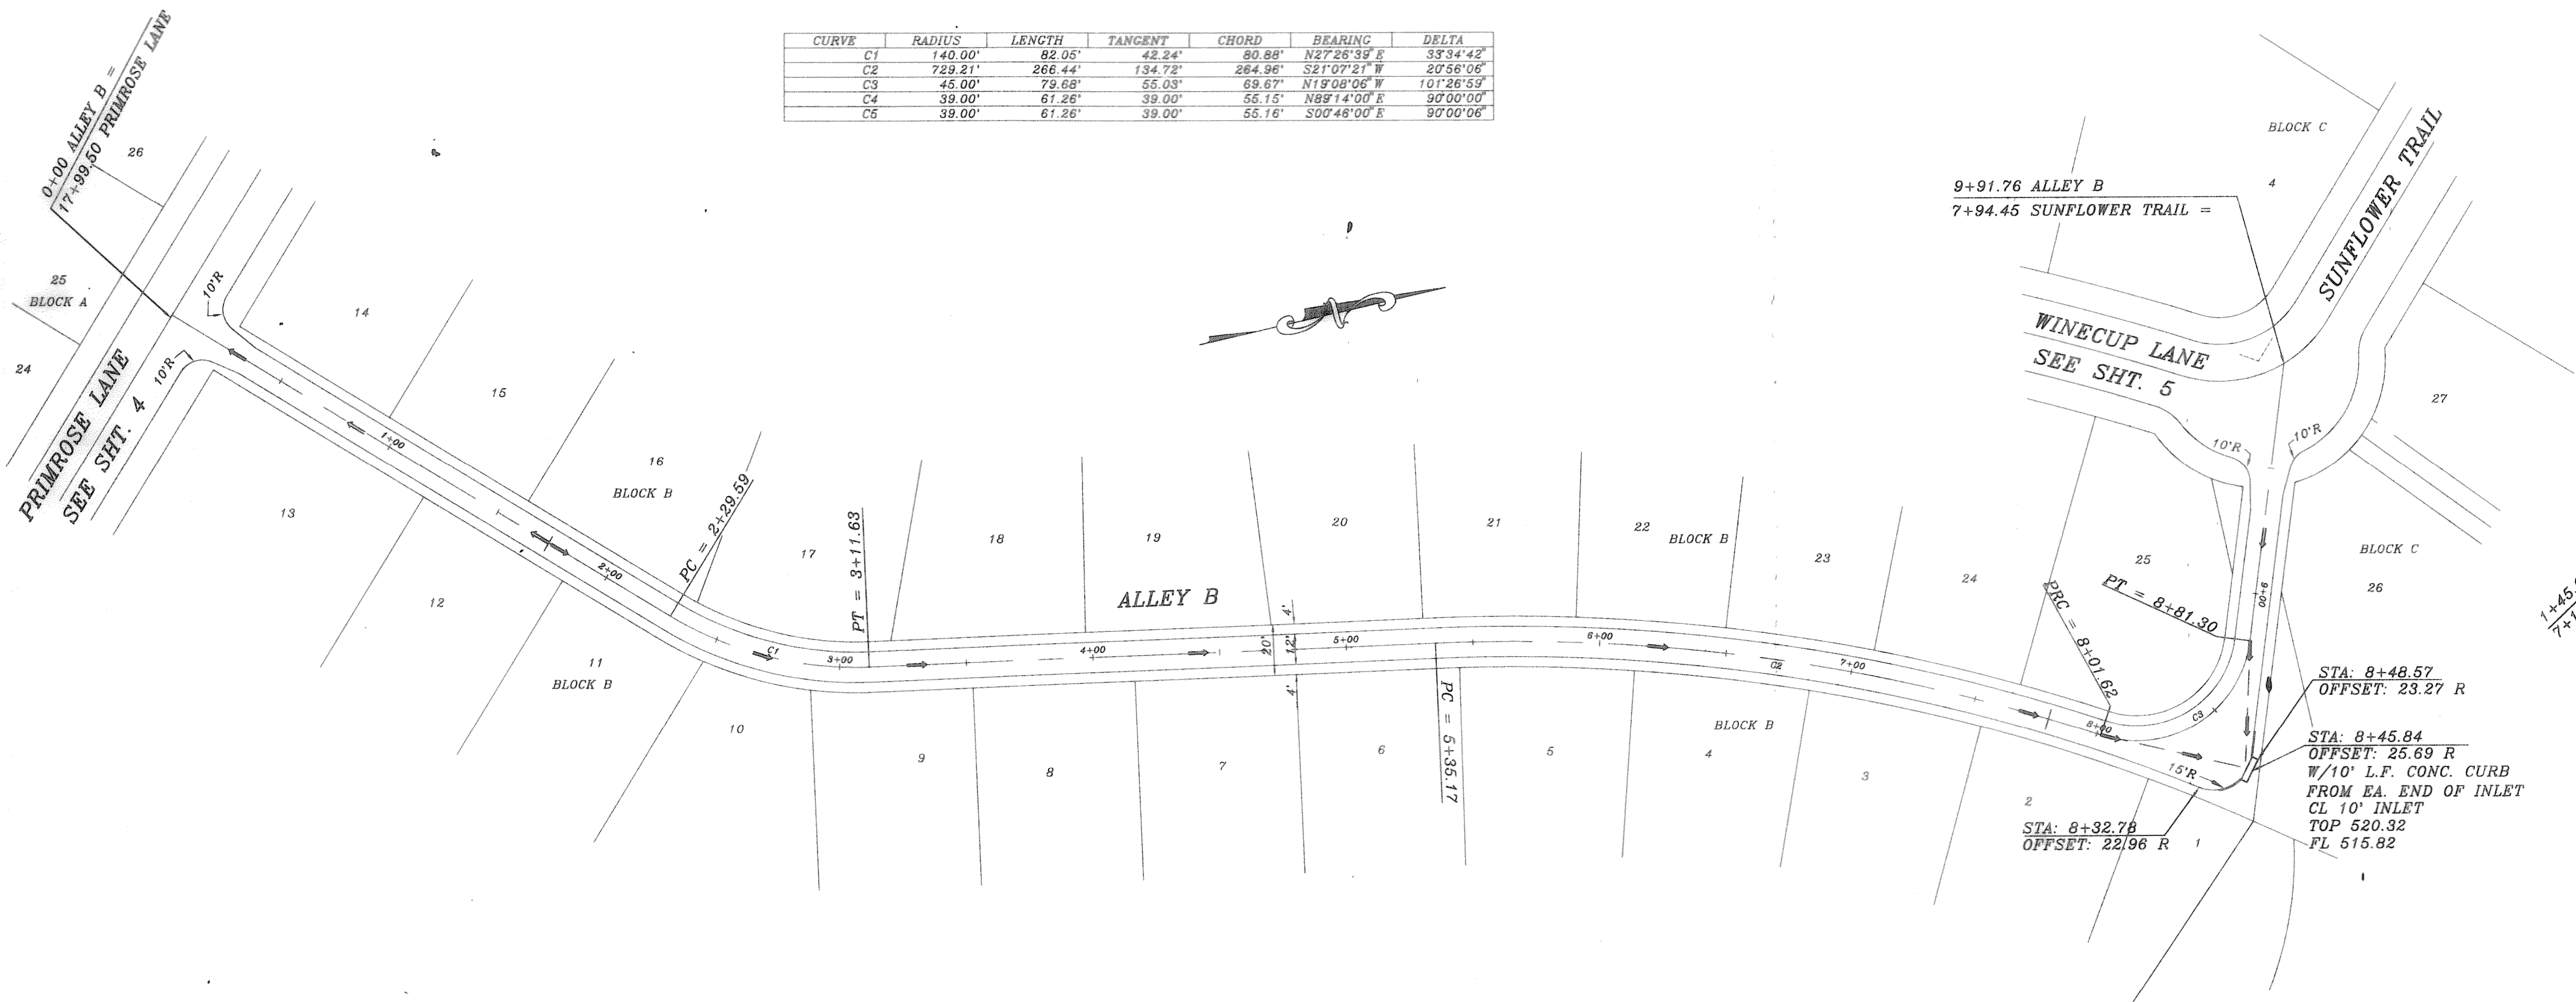

B.M.
TOP OF EXIST. SAN. SEW. M.H.
LOCATED AT PAY. STA. (0+25), 4' LT.
WILDFLOWER WAY
ELEVATION = 515.72

B.M.
TOP OF EXIST. M.H. AT WEST
CORNER OF LOT 20, BLOCK A, OF
HIGHLAND MEADOWS
ELEVATION = 514.85

REVISION	DESCRIPTION	DATE
REV. ALLEY A-1		1/2/96
REV. PER 2ND CITY REVIEW		11/9/95
REV. PER CITY REVIEW		8/14/95

HAROLD L. EVANS
CONSULTING ENGINEER
P.O. BOX 28355
2331 GUS THOMASSON ROAD, SUITE 102
DALLAS, TEXAS 75228 (214) 328-8133

PROPOSED PAVING
ALLEY B & A-1
HIGHLAND MEADOWS NO. 1
CITY OF ROCKWALL



AS BUILT

1-96

SHEET NO.	11
JOB NO.	9563