



CIVIL ENGINEERING CONSTRUCTION PLANS ROCKWALL OFFICE PARK LOTS 10R1, 10R2 & 10R3, BLOCK A HORIZON RIDGE ADDITION AN ADDITION TO THE CITY OF ROCKWALL ROCKWALL COUNTY, TEXAS

AUGUST 2005

INDEX OF DRAWINGS

C1	Drainage Area Map
C2	Grading & Drainage Plan
C2A	Phase 1 Grading & Drainage Plan
C3	Water & Sanitary Sewer Plan
C4	Utility Profiles
C5	Paving Plan
C6	Erosion Control Plan
C7	Miscellaneous Details
Cover Sheet	
Re-Plat	

NOTE: ALL WORK ON CIVIL PLANS INCLUDING GRASSING SHALL BE INSTALLED PRIOR TO P-5 (BUILDING) APPROVAL.

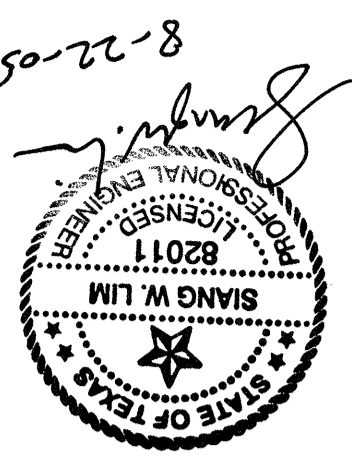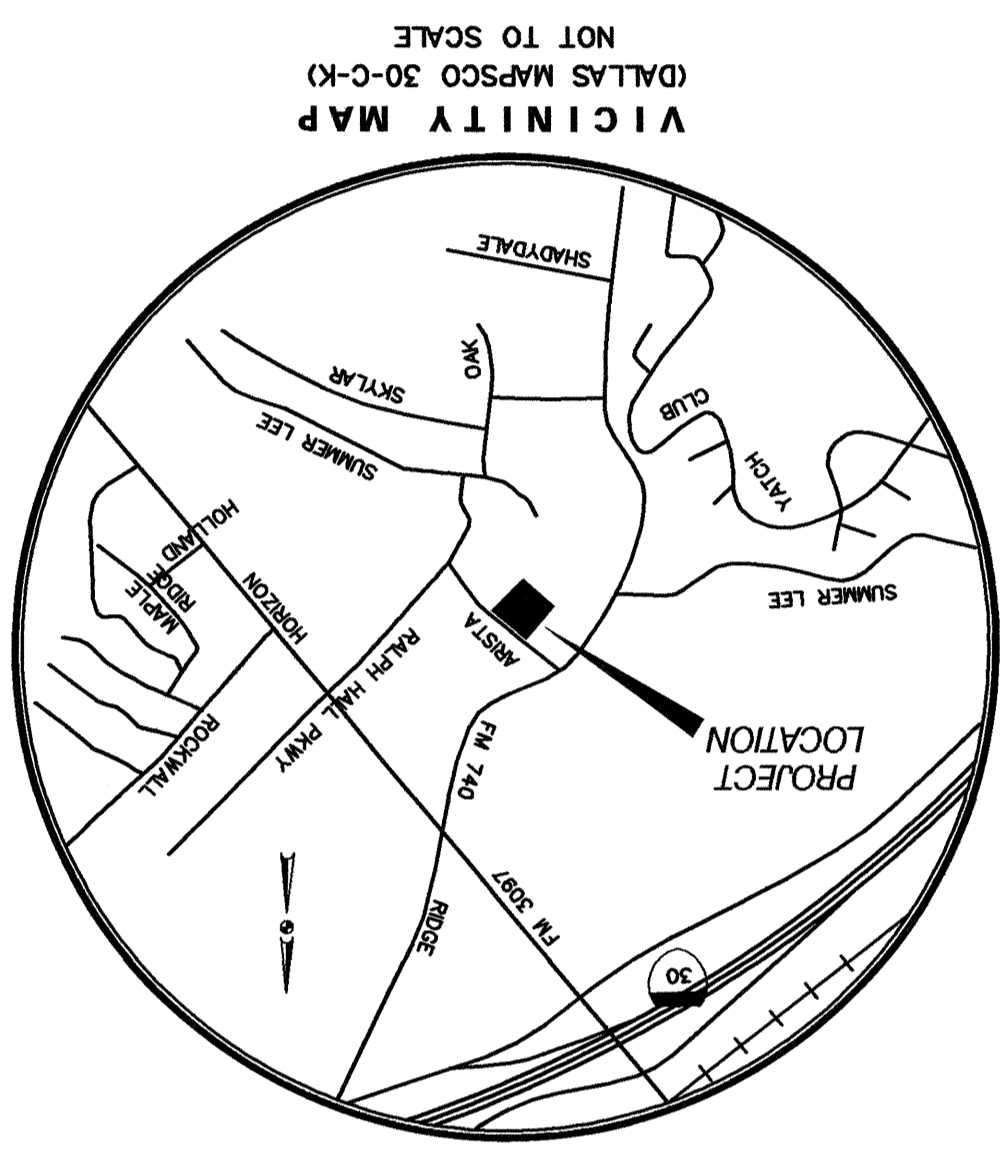

NOTE: THESE PLANS HAVE BEEN REVISED TO CONFORM WITH CONSTRUCTION RECORDS PROVIDED BY THE CONTRACTOR. ENGINEER DID NOT CERTIFY TO FIELD VERIFYING ANY CHANGES MADE DURING CONSTRUCTION.

AS-BUILT

Lim
& ASSOCIATES, Inc.
engineering & surveying consultants
 1701 N. Market Street, Suite 405 / LB20
 Dallas, Texas 75202
 Tel. (214) 698-1888 • Fax (214) 698-9881

CIVIL ENGINEER/SURVEYOR

TEL. (817) 640-0100
 FAX. (817) 633-3309
 GRAND PRAIRIE, TEXAS 75050
 2045 N. HIGHWAY 360, SUITE 160

CNK ASSOCIATES, INC.
ARCHITECT

MR. RORY MAGUIRE, VICE PRESIDENT
 REALTY CAPITAL ROCKWALL, LTD.
 99 MAIN STREET, SUITE 200
 COLLETVILLE, TEXAS 76034
 TEL. (817) 488-4200 X 127
 OWNER/DEVELOPER

ROCKWALL OFFICE PARK - LOTS 10R1, 10R2, & 10R3, BLOCK A, HORIZON RIDGE ADDITION