


Revised: 10/31/05 MO  
 H:\Rockwall\2000172\Plans\Sheets\AS-BUILD\12-01-03\2000172-503.dwg Master 171, Master 171 Profile

MATCH LINE STA. 10+00  
 N 9926.0294, E 11899.5847

MATCH LINE STA. 15+00  
 N 9431.6889, E 11974.6008

**FIELD CHANGE NO. 1**  
**REVISED FORCE MAIN**  
**ALIGNMENT**



These plans and related specifications were prepared for construction of this specific project only. Reuse of these documents is not permitted without written authorization of Birkhoff, Hendricks, & Conway, L.L.P.

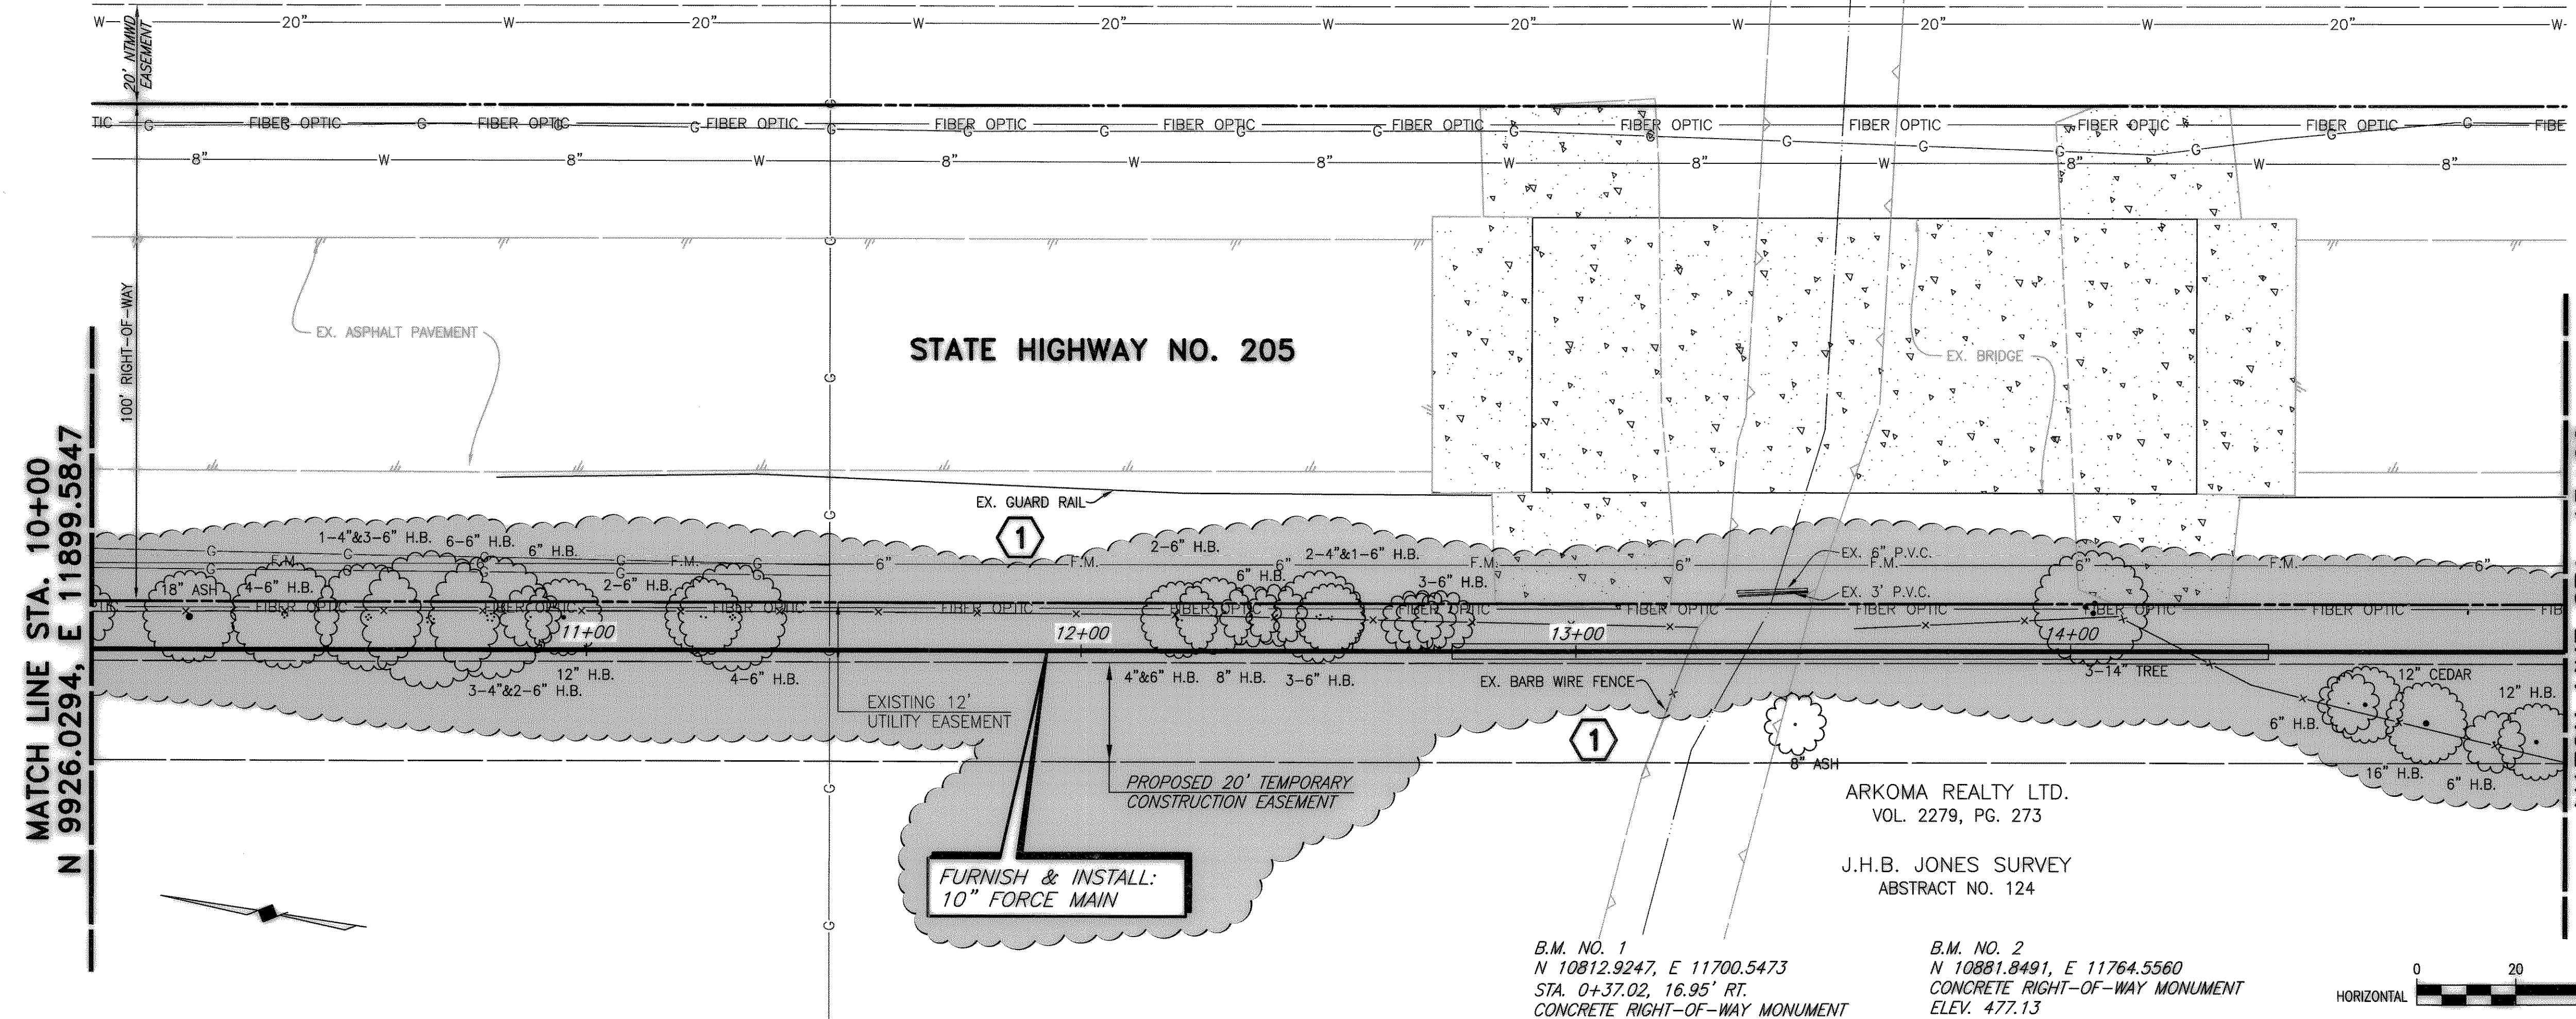

FURNISH & INSTALL:  
 10" FORCE MAIN

B.M. NO. 1  
 N 10812.9247, E 11700.5473  
 STA. 0+37.02, 16.95' RT.  
 CONCRETE RIGHT-OF-WAY MONUMENT  
 ELEV. 478.39

B.M. NO. 2  
 N 10881.8491, E 11764.5560  
 CONCRETE RIGHT-OF-WAY MONUMENT  
 ELEV. 477.13

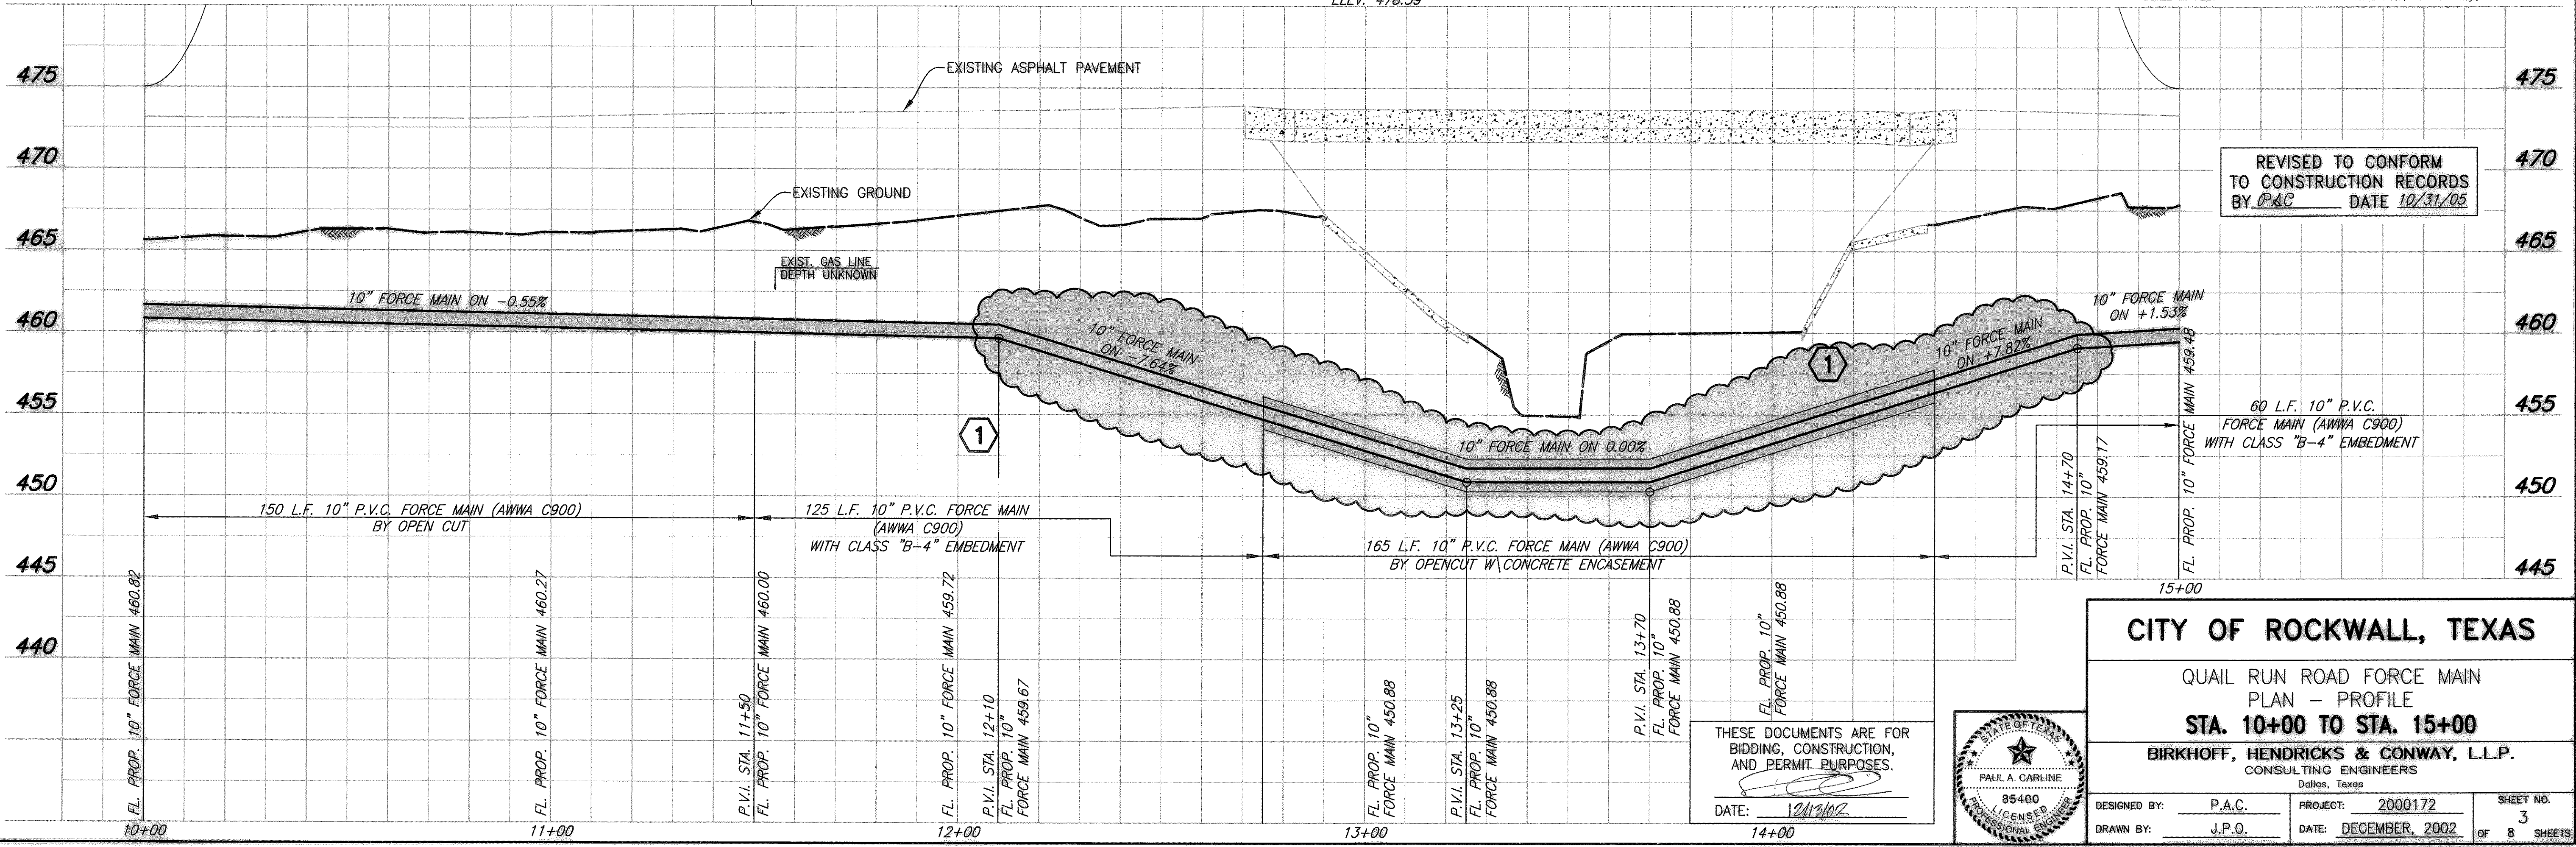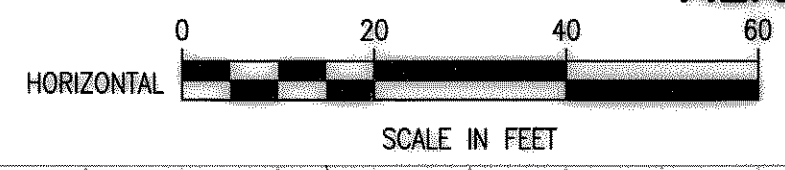

REVISED TO CONFORM  
 TO CONSTRUCTION RECORDS  
 BY P.A.C. DATE 10/31/05

THESE DOCUMENTS ARE FOR  
 BIDDING, CONSTRUCTION,  
 AND PERMIT PURPOSES.  
 DATE: 10/31/05



**CITY OF ROCKWALL, TEXAS**  
 QUAIL RUN ROAD FORCE MAIN  
 PLAN - PROFILE  
 STA. 10+00 TO STA. 15+00  
 BIRKHOFF, HENDRICKS & CONWAY, L.L.P.  
 CONSULTING ENGINEERS  
 Dallas, Texas

DESIGNED BY: P.A.C.	PROJECT: 2000172	SHEET NO. 3
DRAWN BY: J.P.O.	DATE: DECEMBER, 2002	OF 8 SHEETS