
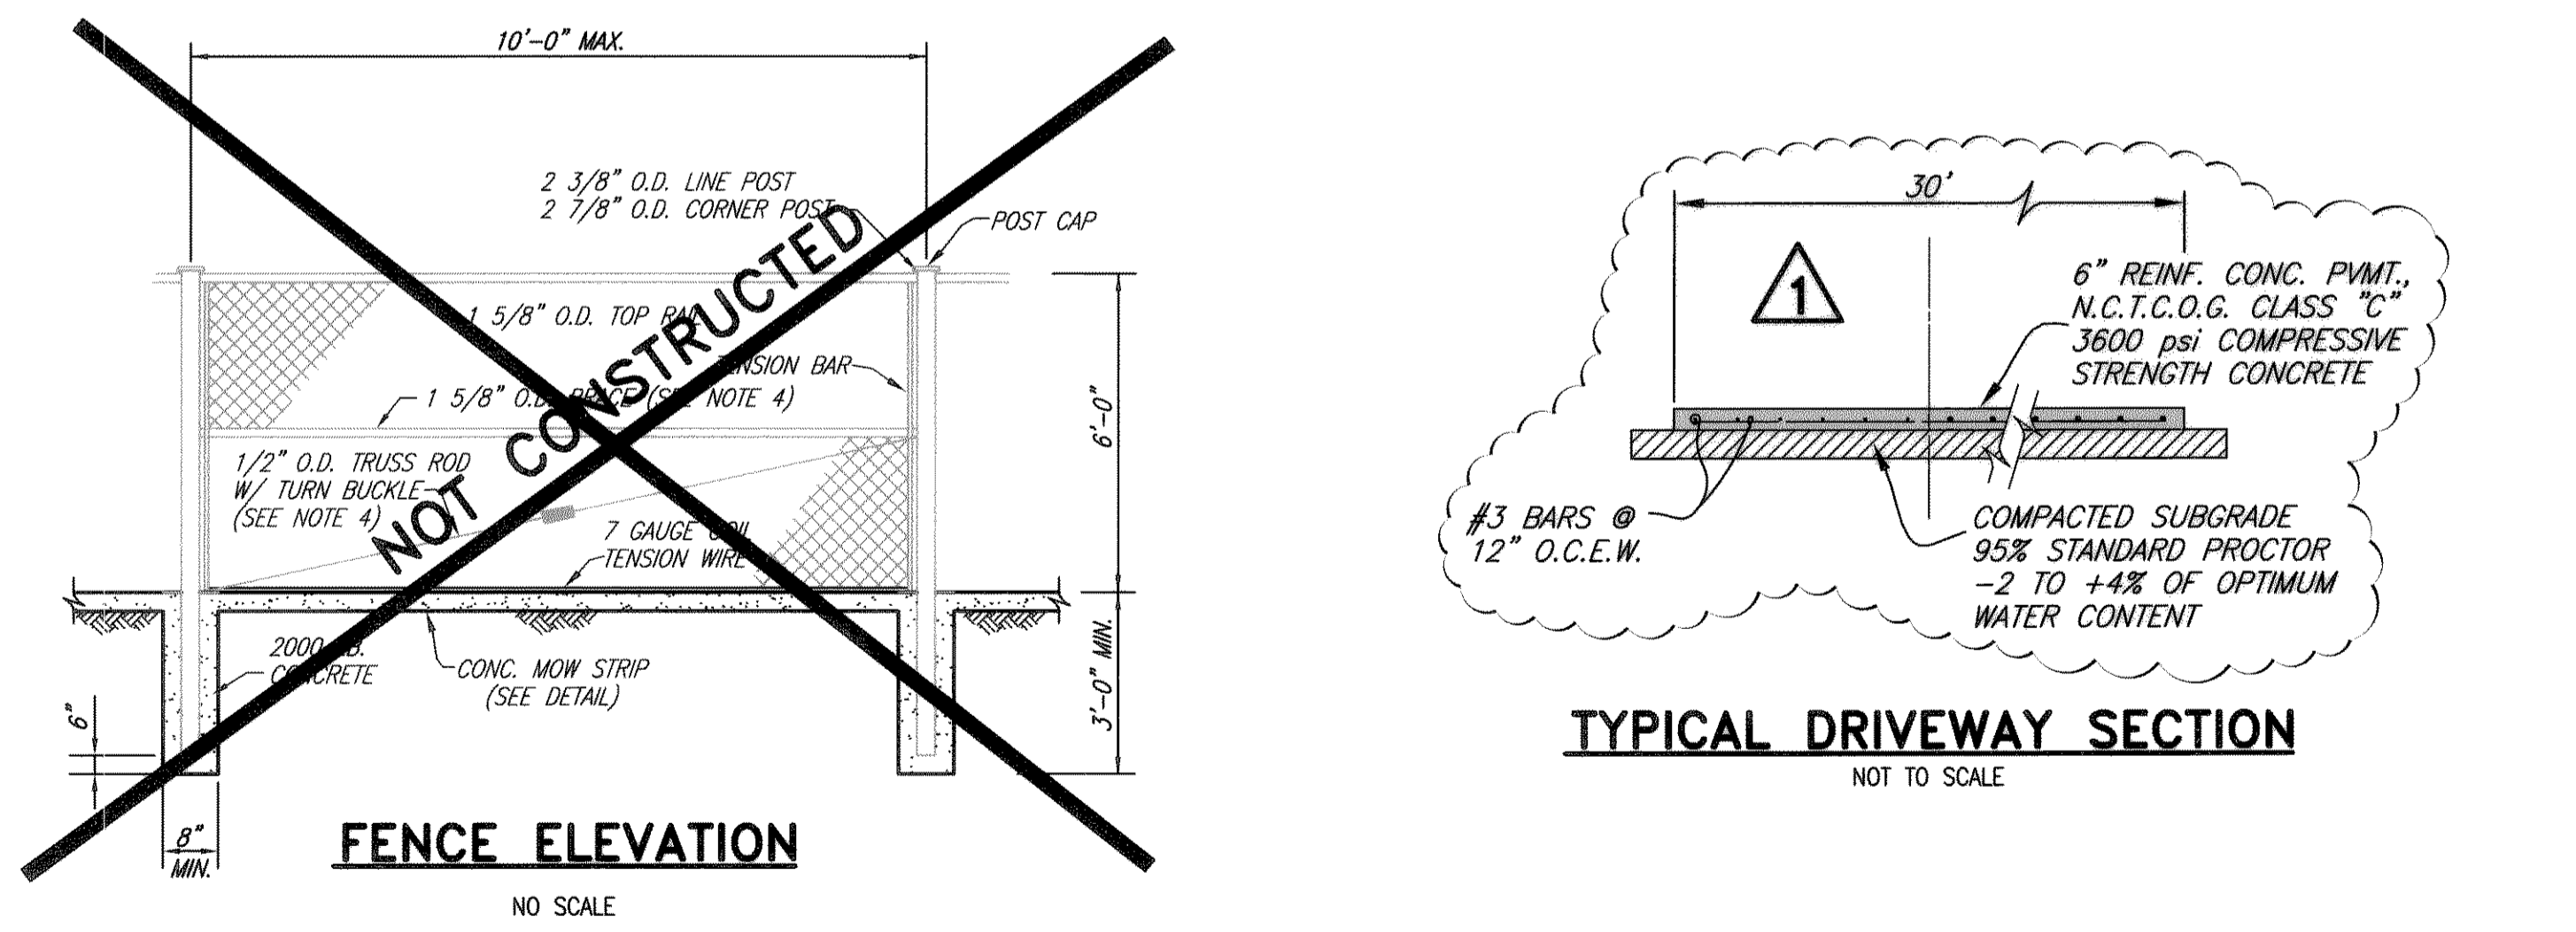
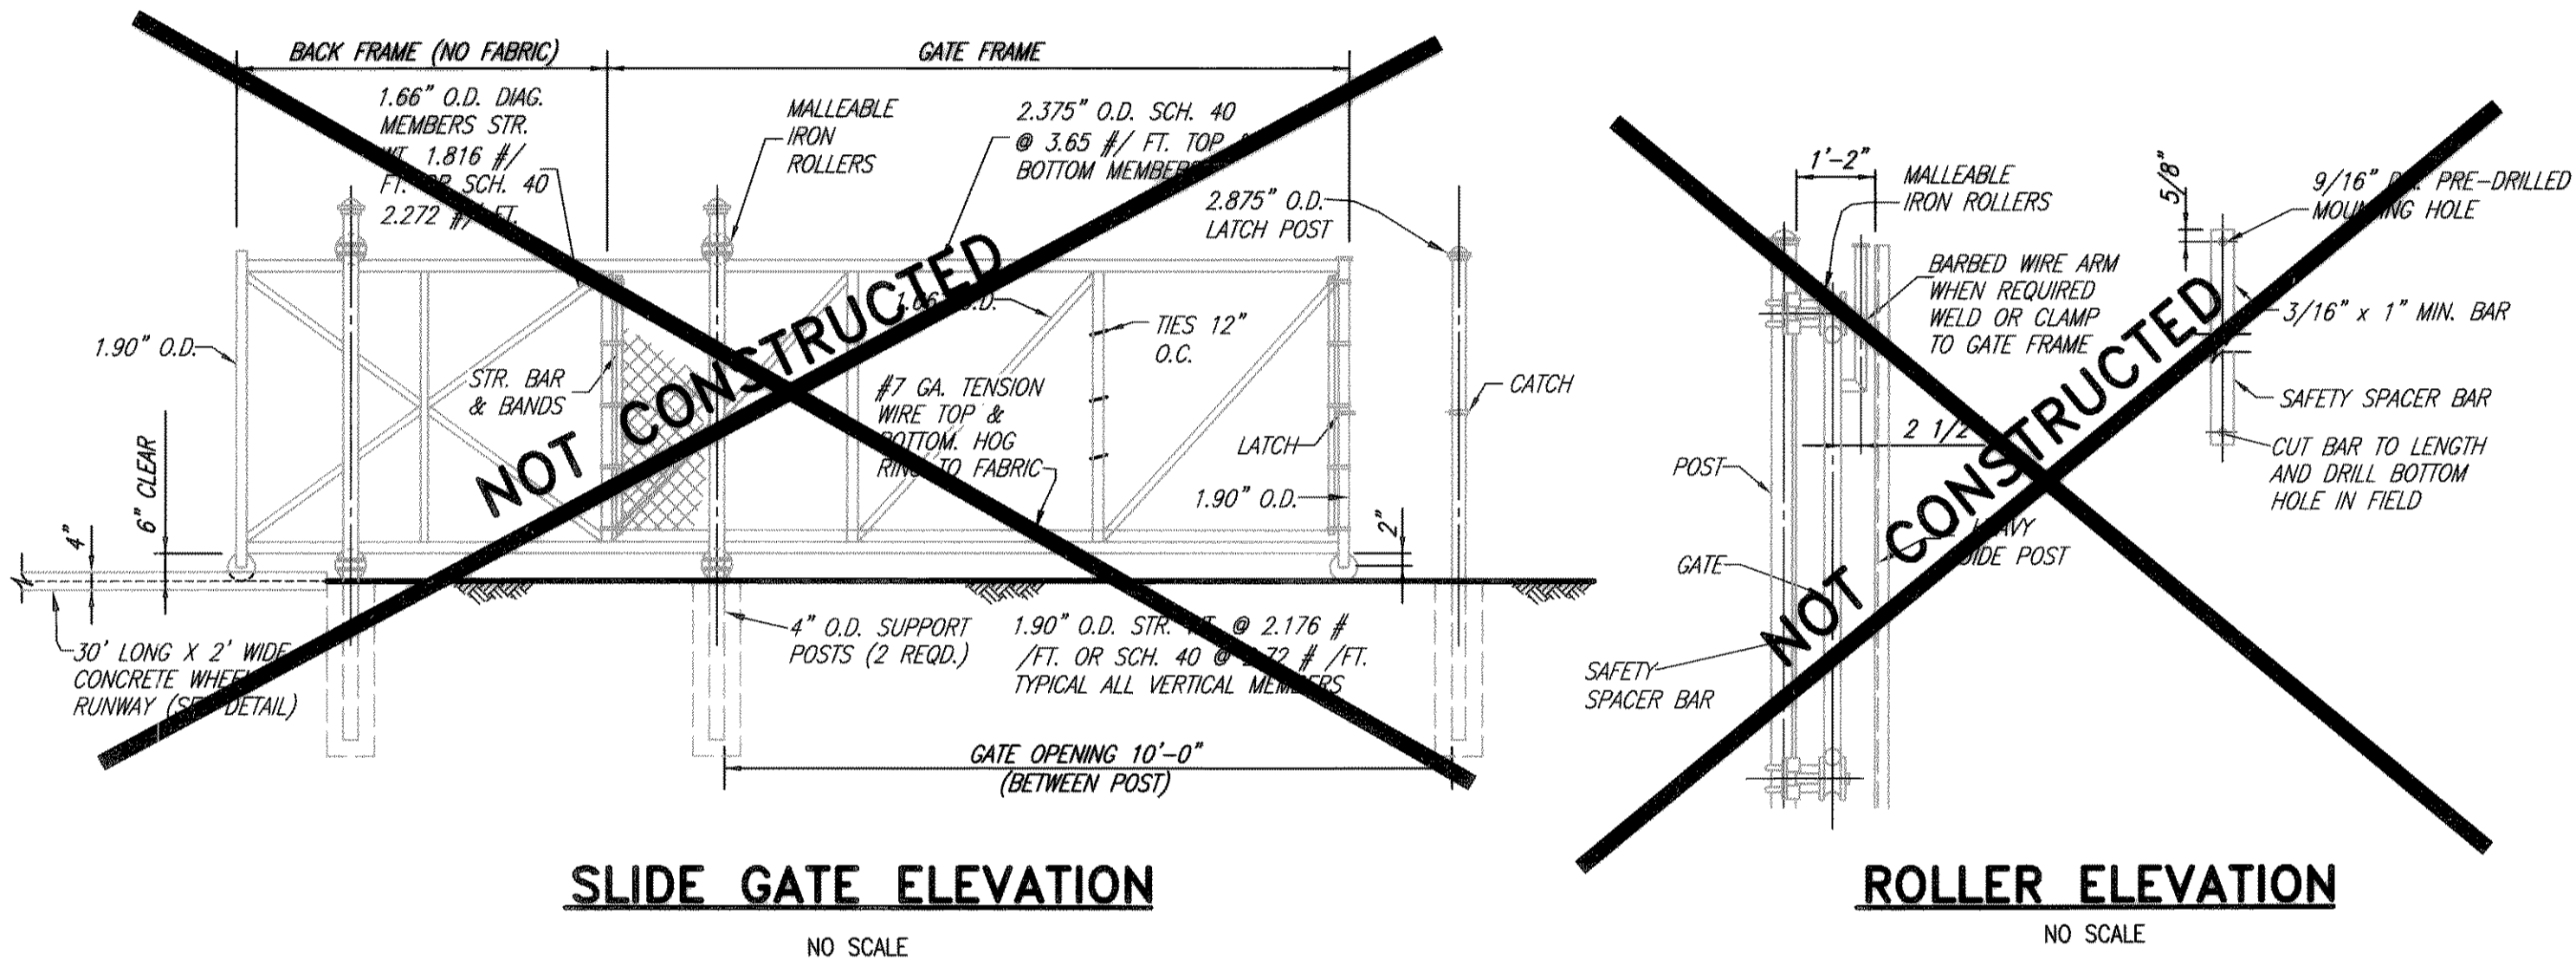
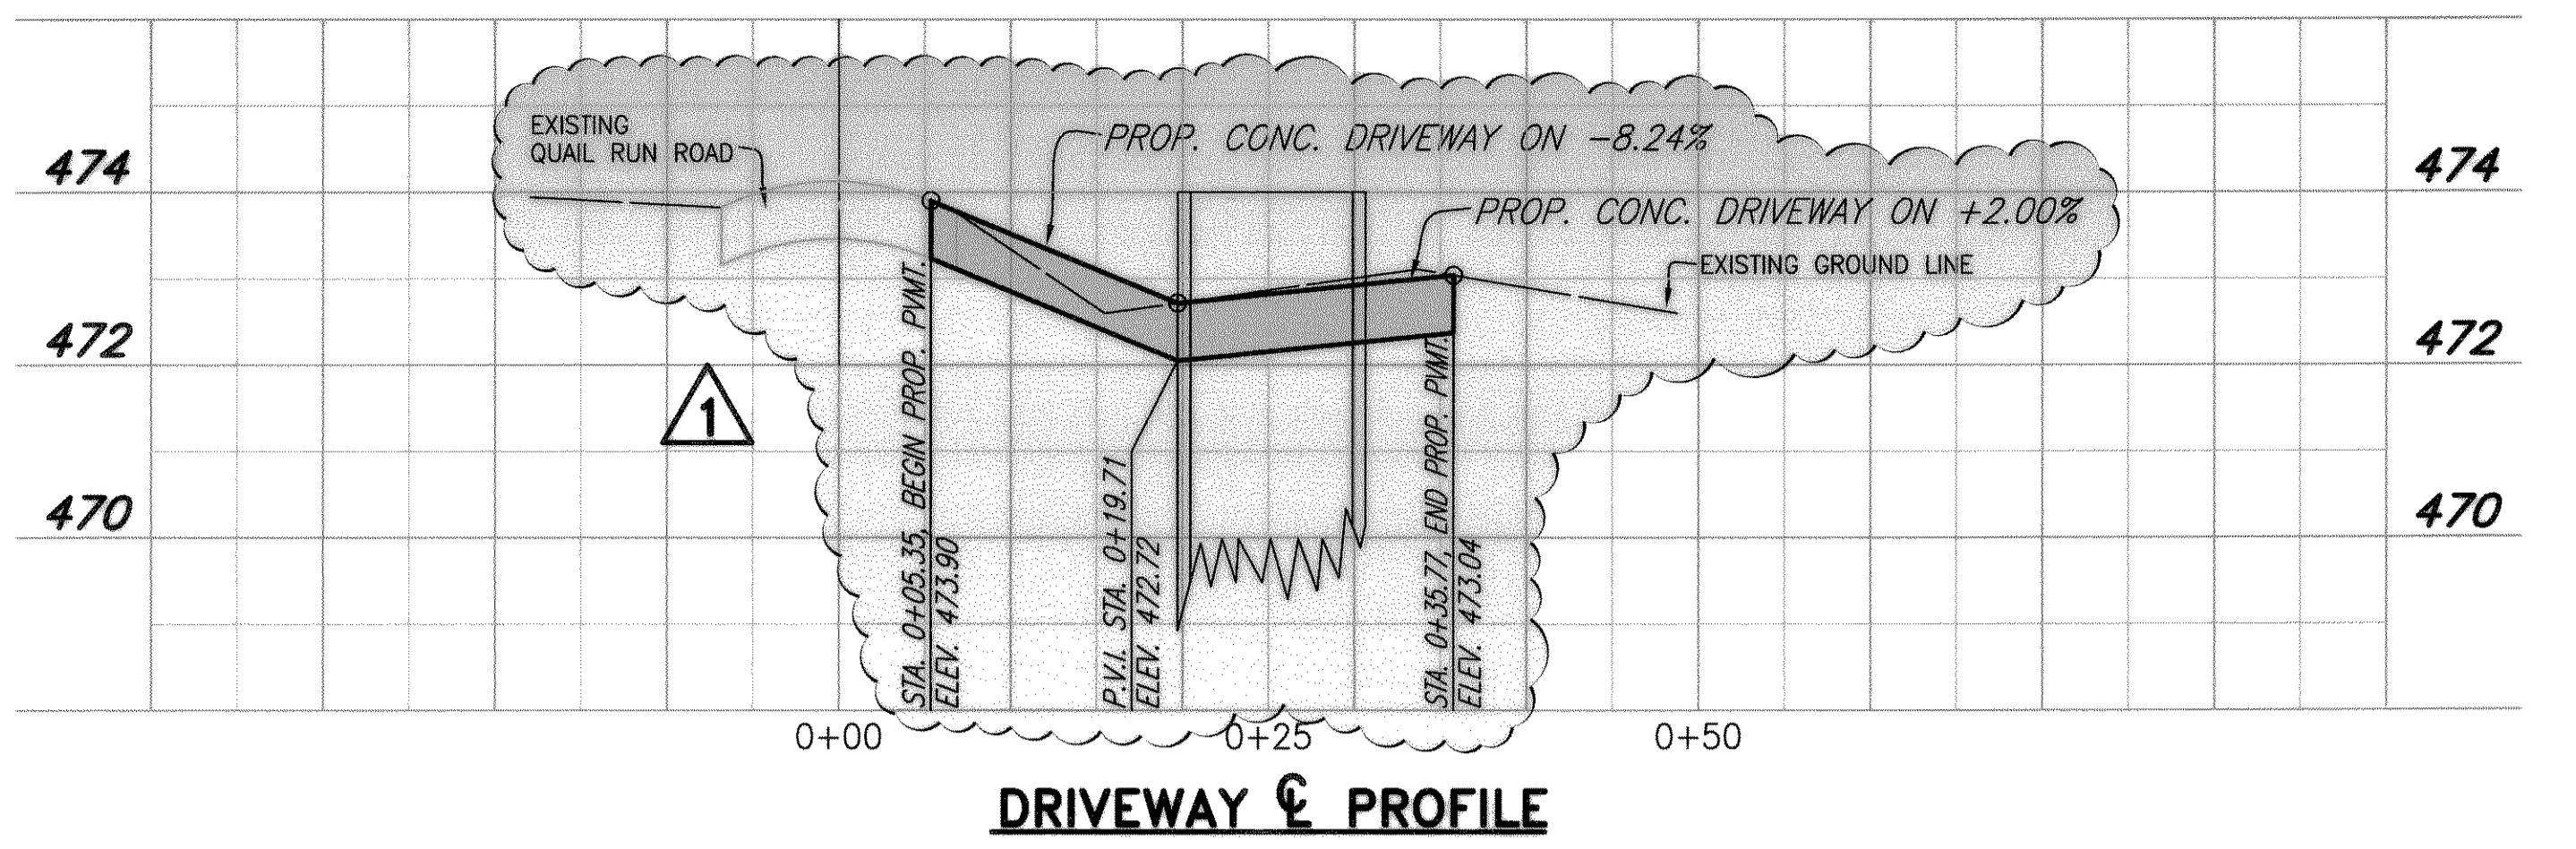


Revised: 10/31/2005 MO H:\Projects\Rockwall\2000172\Plans\Sheets\2000172_S06.dwg Xrefs: Master 172

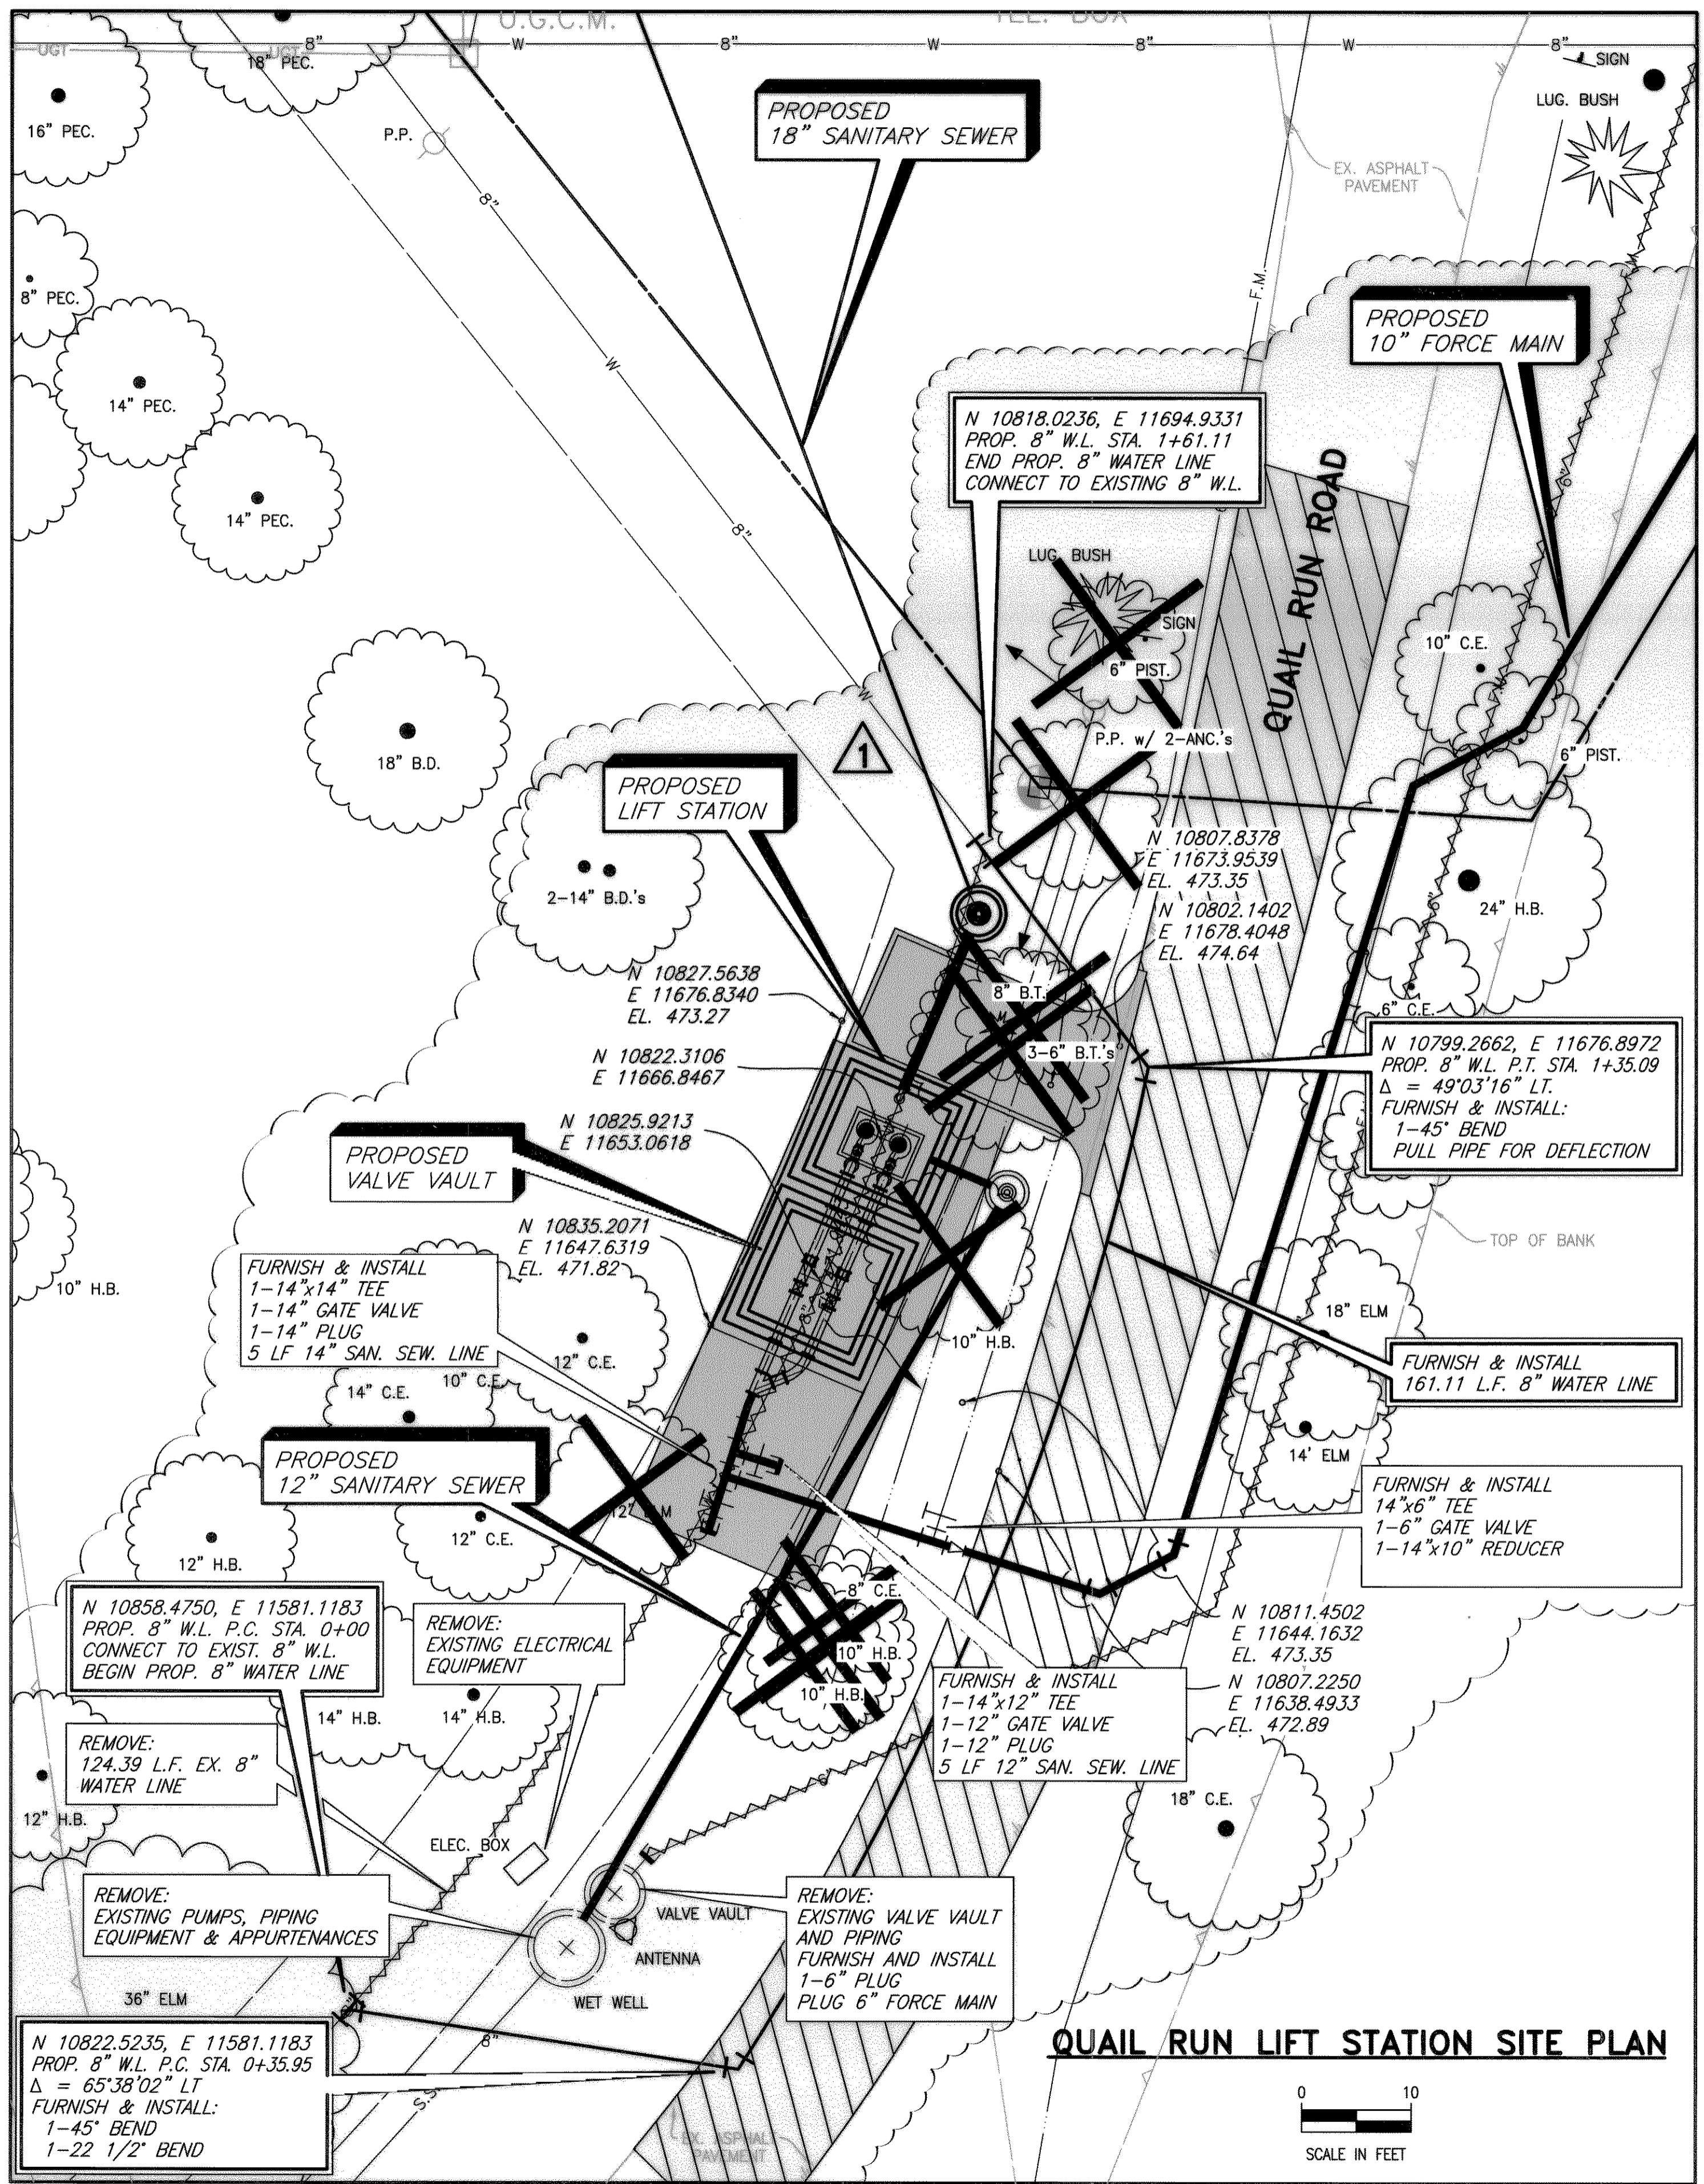

REVISED TO CONFORM TO CONSTRUCTION RECORDS BY PAC DATE 10/31/05

CHANGE ORDER NO. 1
12/13/2002 REVISED LIFT STATION LOCATION

THESE DOCUMENTS ARE FOR BIDDING, CONSTRUCTION, AND PERMIT PURPOSES.
DATE: 12/13/02



CITY OF ROCKWALL, TEXAS

QUAIL RUN LIFT STATION
SITE PLAN AND ABANDONMENT PLAN

BIRKHOFF, HENDRICKS & CONWAY, L.L.P.
CONSULTING ENGINEERS

DESIGNED BY: P.A.C.	PROJECT: 2000172	SHEET NO. 6
DRAWN BY: J.P.O.	DATE: DECEMBER, 2002	OF 8 SHEETS