


LEGEND  
TREES TO BE SAVED [XXXX]

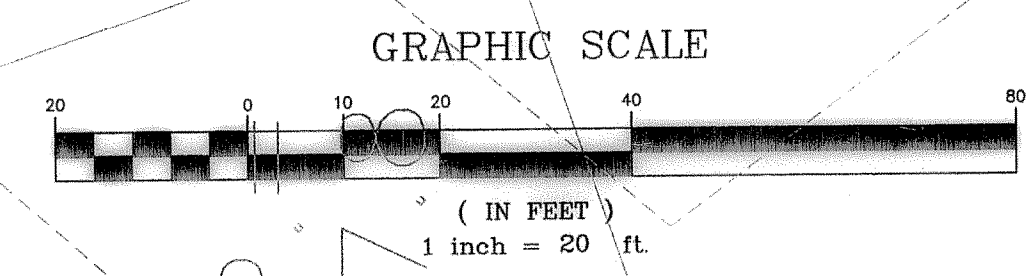


TREE LEGEND

- BOIS D'ARC
- CEDAR
- CHINABERRY
- COTTONWOOD
- ELM
- HACKBERRY
- LOCUST
- MESQUITE
- WILLOW

REVISED TO CONFORM TO CONSTRUCTION RECORDS.  
*[Signature]* DATE: 5/23/03

OWNER/DEVELOPER  
TAYLOR DUNCAN INTERESTS, INC.  
5000 QUORUM DRIVE, SUITE 395  
DALLAS, TEXAS 75240  
(972) 404-8500

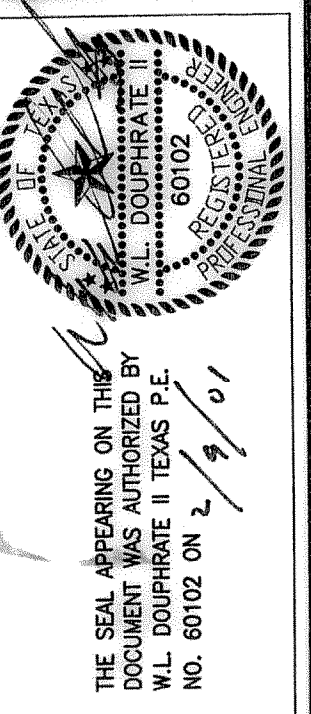

DOUPHRATE & ASSOCIATES, INC.  
ENGINEERING • PROJECT MANAGEMENT • SURVEYING  
2235 RIDGE RD., # 200 ROCKWALL, TEXAS 75087  
PHONE: (972)771-0004 FAX: (972)771-0005

TREE PRESERVATION PLAN  
SHEET 10  
TIMBER CREEK ESTATES  
CITY OF ROCKWALL, ROCKWALL COUNTY, TEXAS

|                |
|----------------|
| 3:1 SLOPE 1/01 |
| REVISION       |
| W.L.D.         |
| CHECKED        |
| KEB.           |
| DRAWN          |
| 7/25/00        |
| DATE           |
| 9913TR-10      |
| PROJECT        |
| 19             |
| OF             |