


THE SEAL APPEARING ON THIS DOCUMENT WAS AUTHORIZED BY W.L. DOUPHRATE II TEXAS P.E. NO. 80102 ON 2/9/01

**DOUPHRATE & ASSOCIATES, INC.**  
ENGINEERING • PROJECT MANAGEMENT • SURVEYING  
22235 RIDGE RD., # 200 ROCKWALL, TEXAS 75087  
PHONE: (972)771-9004 FAX: (972)771-9005


**TREE PRESERVATION PLAN**  
SHEET 10  
TIMBER CREEK ESTATES  
CITY OF ROCKWALL, ROCKWALL COUNTY, TEXAS

3:1 SLOPE 01/01  
REVISION  
W.L.D.  
CHECKED  
K.E.B.  
DRAWN  
1/24/01  
DATE  
9913TR-11  
PROJECT

20  
OF

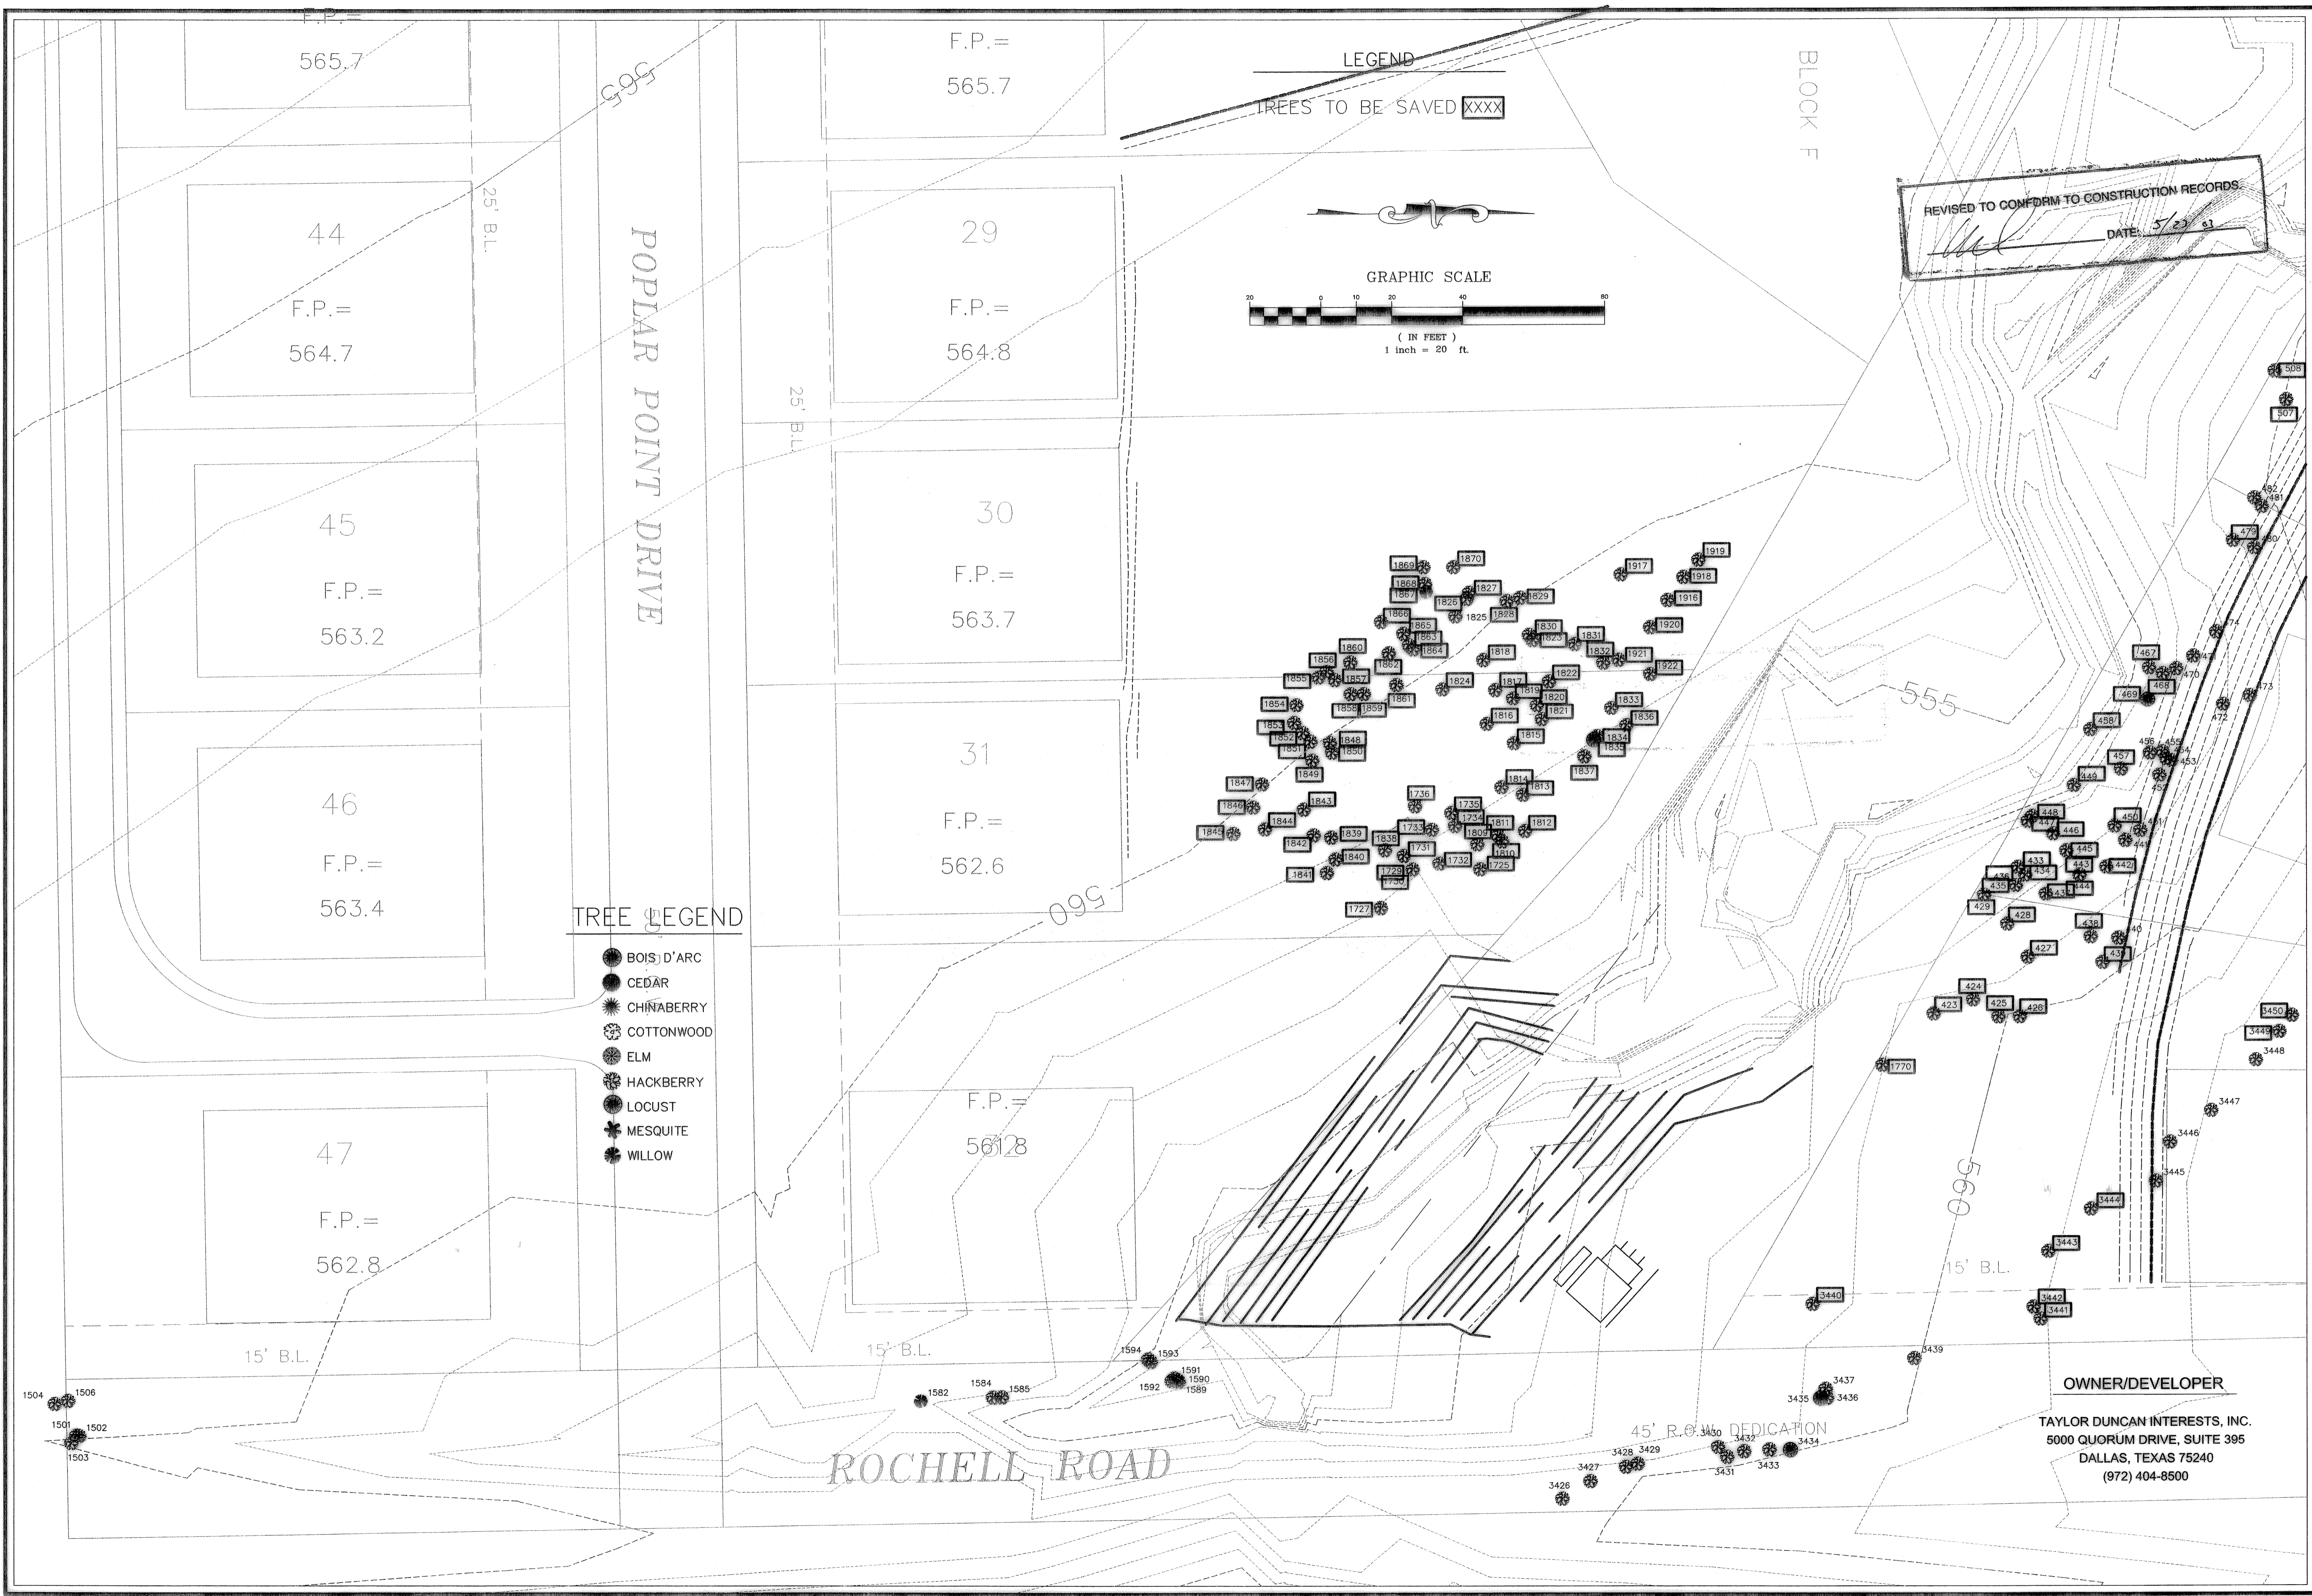

LEGEND  
TREES TO BE SAVED XXXX

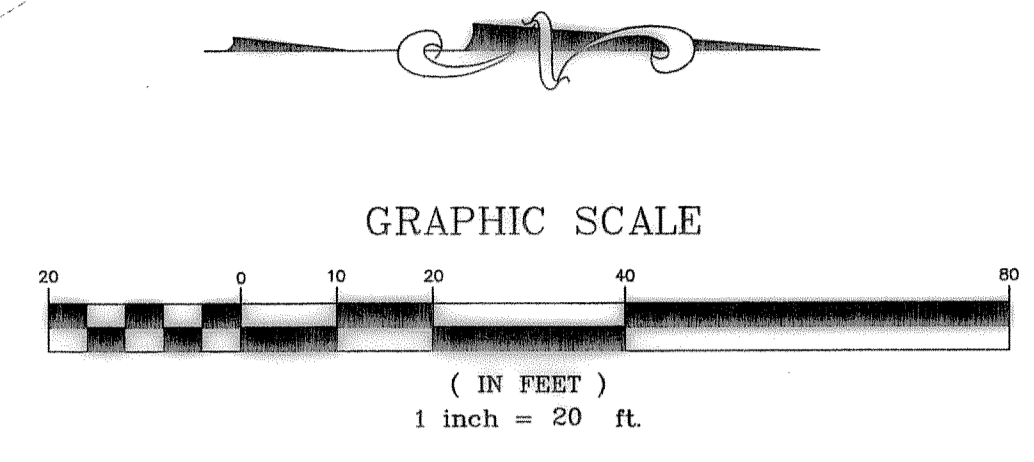

REVISED TO CONFORM TO CONSTRUCTION RECORDS  
DATE: 5/23/01

- TREE LEGEND
- BOIS D'ARC
  - CEDAR
  - CHINABERRY
  - COTTONWOOD
  - ELM
  - HACKBERRY
  - LOCUST
  - MESQUITE
  - WILLOW

OWNER/DEVELOPER  
TAYLOR DUNCAN INTERESTS, INC.  
5000 QUORUM DRIVE, SUITE 395  
DALLAS, TEXAS 75240  
(972) 404-8500

ROCHELL ROAD

POPULAR POINT DRIVE

BLOCK F

F.P. = 565.7

F.P. = 565.7

44

F.P. = 564.7

29

F.P. = 564.8

45

F.P. = 563.2

30

F.P. = 563.7

46

F.P. = 563.4

31

F.P. = 562.6

47

F.P. = 562.8

F.P. = 561.8

15' B.L.

15' B.L.

15' B.L.

45' R.O. DEDICATION

1504  
1506  
1501  
1502  
1503

1582  
1584  
1585  
1594  
1593  
1591  
1590  
1589

3426  
3427  
3428  
3429  
3430  
3431  
3432  
3433  
3434  
3435  
3436  
3437

423  
424  
425  
510