




TREE LEGEND

- BOIS D'ARC
- CEDAR
- CHINABERRY
- COTTONWOOD
- ELM
- HACKBERRY
- LOCUST
- MESQUITE
- WILLOW

LEGEND
TREES TO BE SAVED [XXXX]

REVISED TO CONFORM TO CONSTRUCTION RECORDS.
WLD
 DATE: 5/23/03

OWNER/DEVELOPER
 TAYLOR DUNCAN INTERESTS, INC.
 5000 QUORUM DRIVE, SUITE 895
 DALLAS, TEXAS 75240
 (972) 404-8500

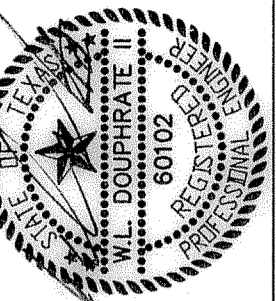

THE SEAL APPEARING ON THIS DOCUMENT WAS AUTHORIZED BY W.L. DOUPHRATE II TEXAS P.E. NO. 60102 ON 2/9/11

DOUPHRATE & ASSOCIATES, INC.
 ENGINEERING • PROJECT MANAGEMENT • SURVEYING
 22255 RIDGE RD., # 200 ROCKWALL, TEXAS 76087
 PHONE: (972)771-9004 FAX: (972)771-9006

TREE PRESERVATION PLAN
 SHEET 3
 TIMBER CREEK ESTATES
 CITY OF ROCKWALL, ROCKWALL COUNTY, TEXAS

3:1 SLOPE 01/01
REVISION
W.L.D.
CHECKED
K.E.B.
DRAWN
7/25/00
DATE
9913TR-3
PROJECT