
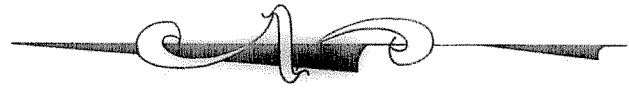


TREE LEGEND

- BOIS D'ARC
- CEDAR
- CHINABERRY
- COTTONWOOD
- ELM
- HACKBERRY
- LOCUST
- MESQUITE
- WILLOW

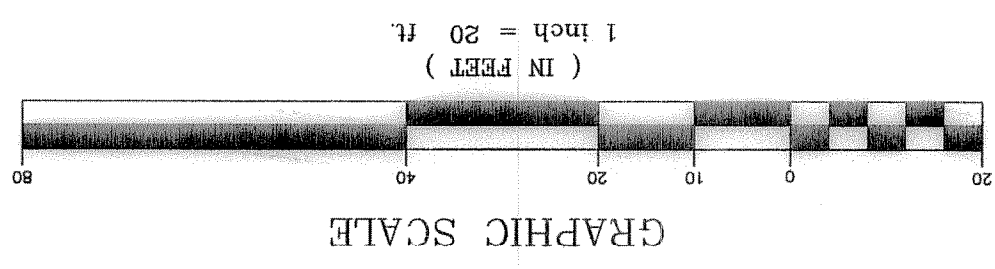

OWNER/DEVELOPER
 TAYLOR DUNCAN INTERESTS, INC.
 5000 QUORUM DRIVE, SUITE 395
 DALLAS, TEXAS 75240
 (972) 404-8500

LEGEND
 XXXX TREES TO BE SAVED



REVISED TO CONFORM TO CONSTRUCTION RECORDS
 DATE: 5/23/01

TREE PRESERVATION PLAN
 SHEET 4
 TIMBER CREEK ESTATES
 CITY OF ROCKWALL, ROCKWALL COUNTY, TEXAS

REVISION	W/LD	CHECKED	K.E.B.	DRAWN	DATE	PROJECT	13 OF 13
					7/25/00	9913TR-4	

DOUPHATE & ASSOCIATES, INC.
 ENGINEERING • PROJECT MANAGEMENT • SURVEYING
 22315 RIDGE RD., # 200 ROCKWALL, TEXAS 75087
 PHONE: (972)771-9004 FAX: (972)771-9005

THE SEAL APPEARING ON THIS DOCUMENT WAS AUTHORIZED BY THE BOARD OF SURVEYING ENGINEERS, STATE OF TEXAS, ON 11/2/01.