


THE SEAL APPEARING ON THIS DOCUMENT WAS AUTHORIZED BY THE BOARD OF PROFESSIONAL ENGINEERS AND SURVEYORS OF THE STATE OF TEXAS, NO. 60102 ON 2/9/01

DOUPHRATE & ASSOCIATES, INC.
ENGINEERING - PROJECT MANAGEMENT - SURVEYING
2286 RIDGE RD., # 200 ROCKWALL, TEXAS 75087
PHONE: (972)771-9004 FAX: (972)771-9005

5 TREE PRESERVATION PLAN
SHEET 7
TIMBER CREEK ESTATES
CITY OF ROCKWALL, ROCKWALL COUNTY, TEXAS


3:1 SLOPE 01/01
REVISION
W.L.D. CHECKED
K.E.B. DRAWN
7/25/00 DATE
9913TR-7 PROJECT

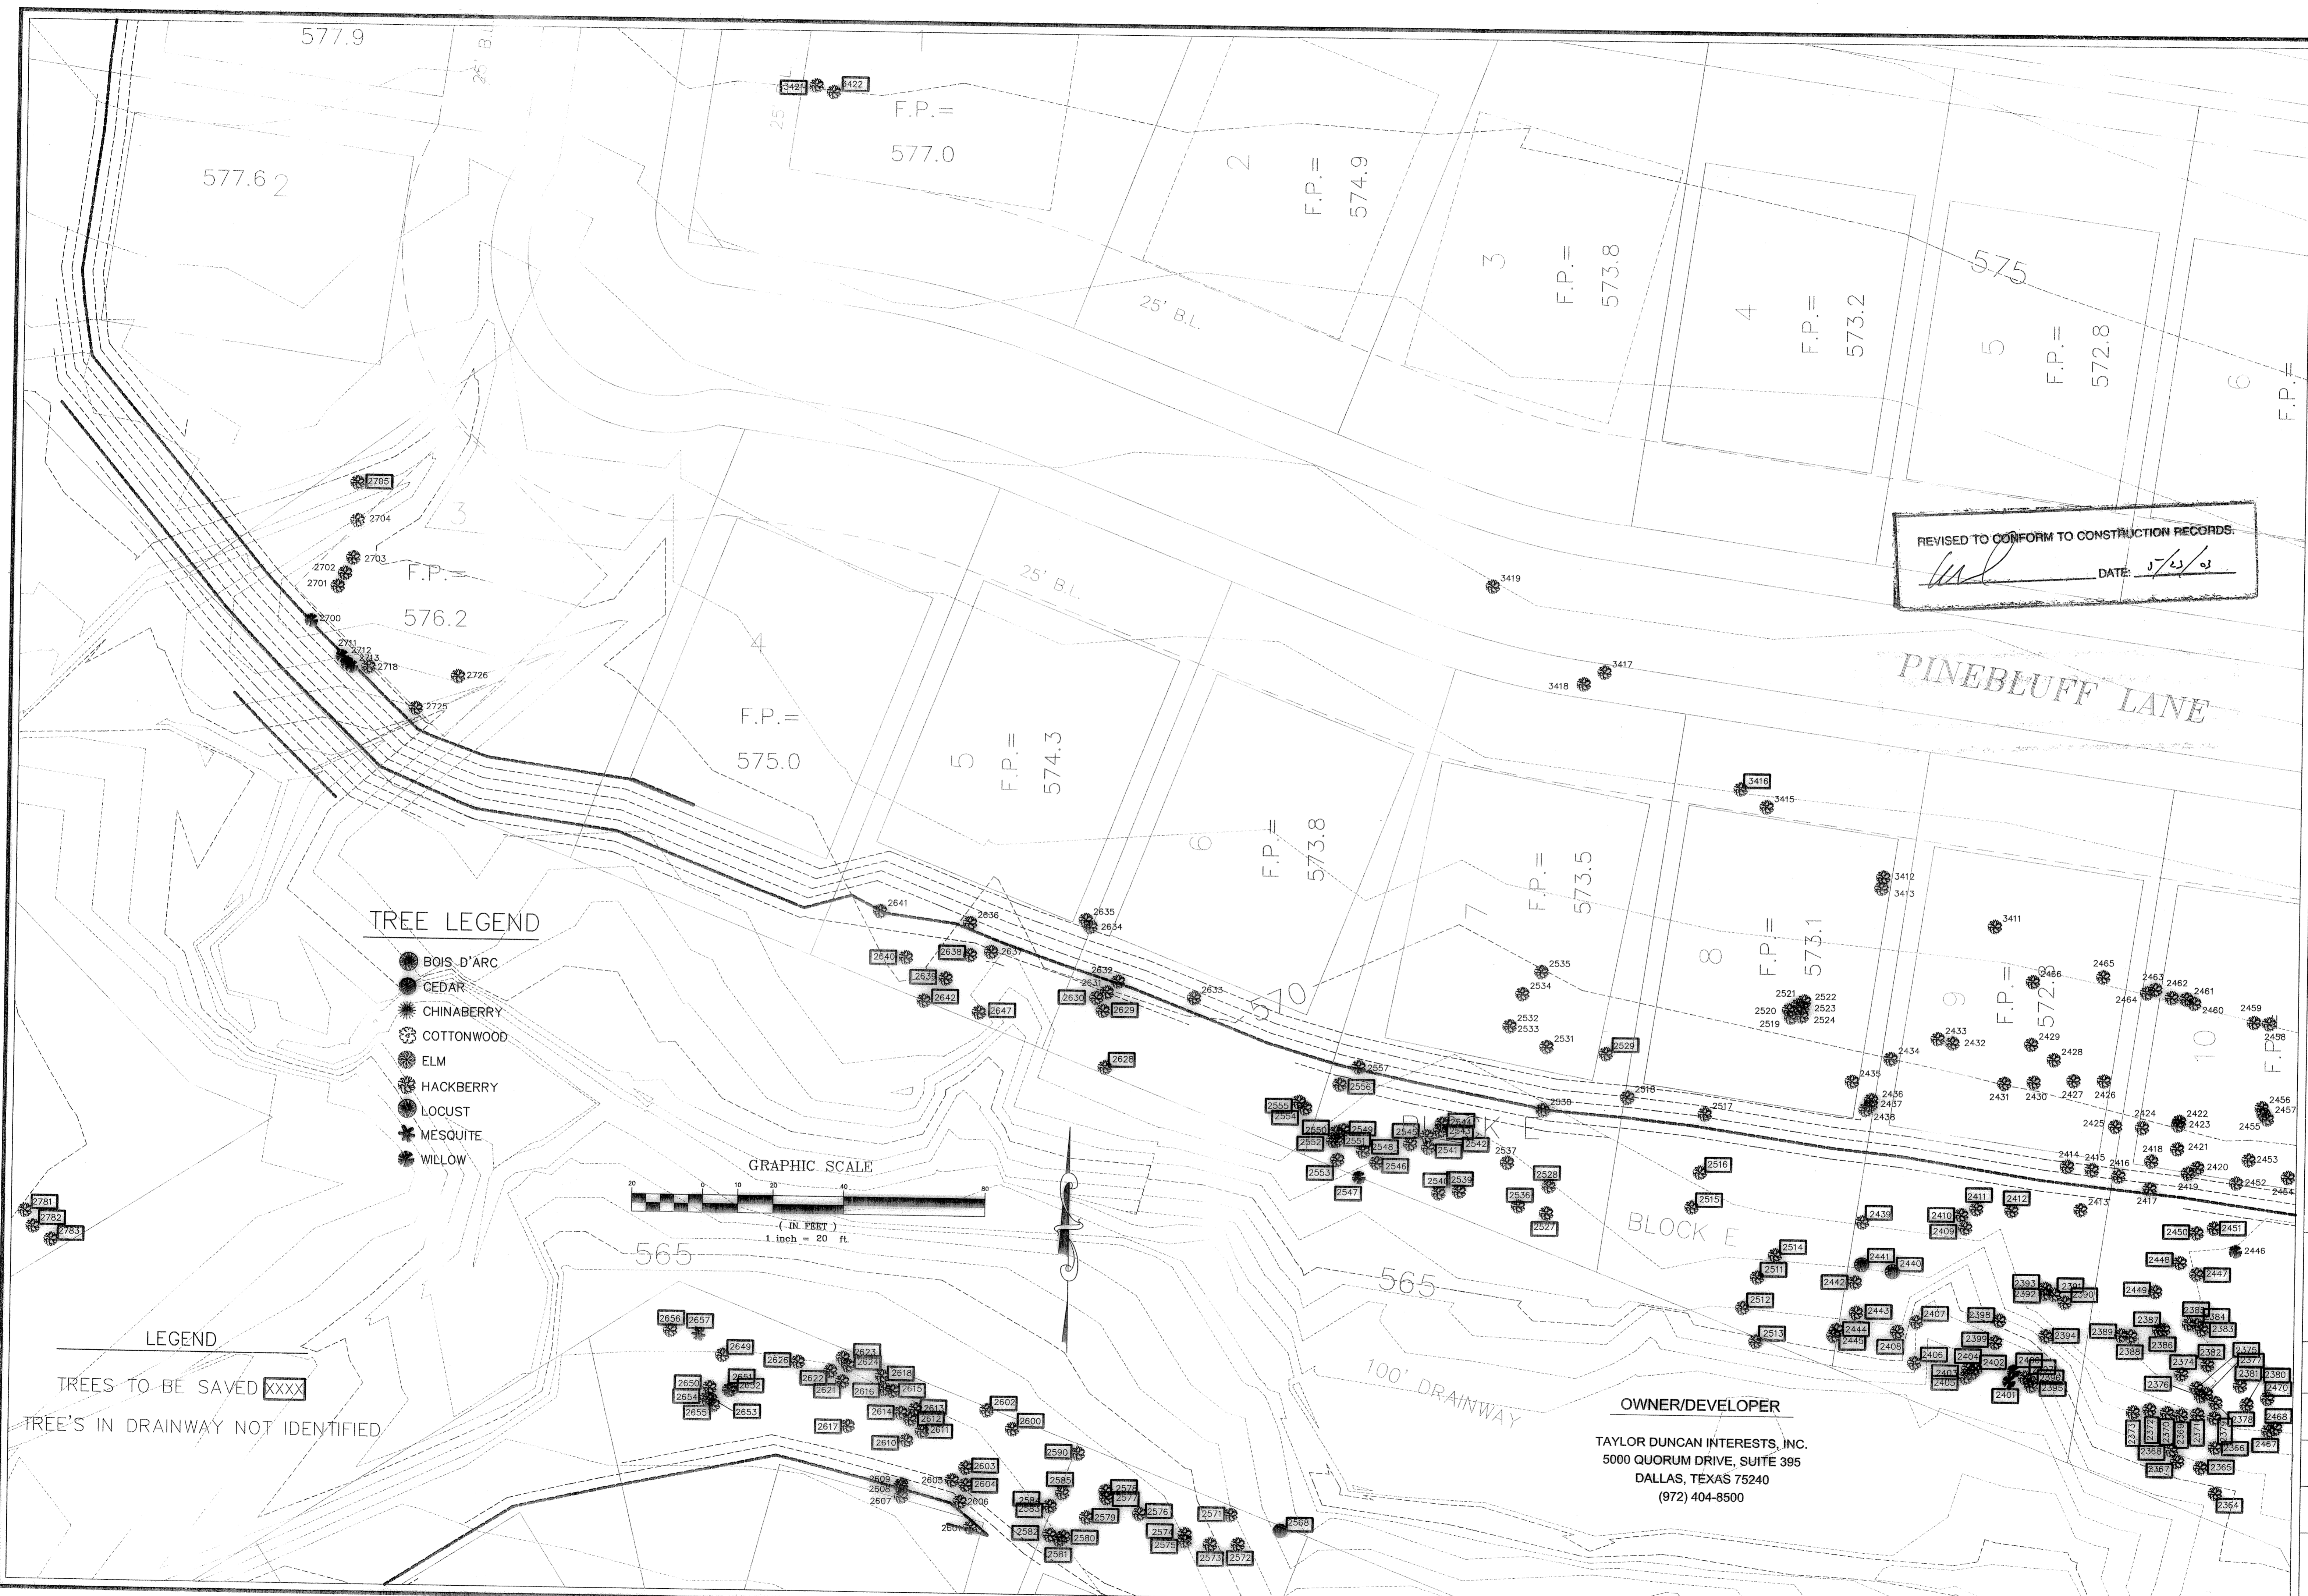

REVISED TO CONFORM TO CONSTRUCTION RECORDS.
WLD DATE: 7/23/00

TREE LEGEND

- BOIS-D'ARC
- CEDAR
- CHINABERRY
- COTTONWOOD
- ELM
- HACKBERRY
- LOCUST
- MESQUITE
- WILLOW

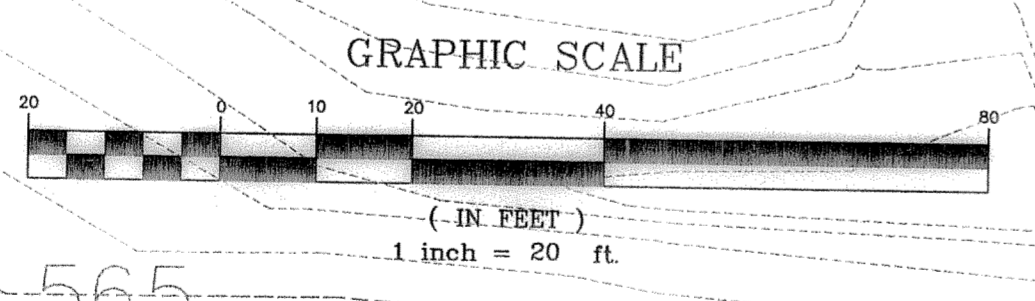

LEGEND

TREES TO BE SAVED [XXXX]
TREE'S IN DRAINWAY NOT IDENTIFIED

OWNER/DEVELOPER
TAYLOR DUNCAN INTERESTS, INC.
5000 QUORUM DRIVE, SUITE 395
DALLAS, TEXAS 75240
(972) 404-8500