

F.P.=
570.9

14

F.P.=
568.3

15

F.P.=
568.5

16

F.P.=
568.0

12

F.P.=
565.3

11

F.P.=
565.7

10

F.P.=
566.9

9

F.P.=
568.3

21

F.P.=
571.0

22

F.P.=
573.0

F.P.=
572.1

F.P.=
571.3

LEGEND
TREES TO BE SAVED XXXX



OWNER/DEVELOPER

TAYLOR DUNCAN INTERESTS, INC.
5000 QUORUM DRIVE, SUITE 395
DALLAS, TEXAS 75240
(972) 404-8500

TREE LEGEND

- BOIS D'ARC
- CEDAR
- CHINABERRY
- COTTONWOOD
- ELM
- HACKBERRY
- LOCUST
- MESQUITE
- WILLOW

REVISED TO CONFORM TO CONSTRUCTION RECORDS.
[Signature]
DATE: 5/23/03

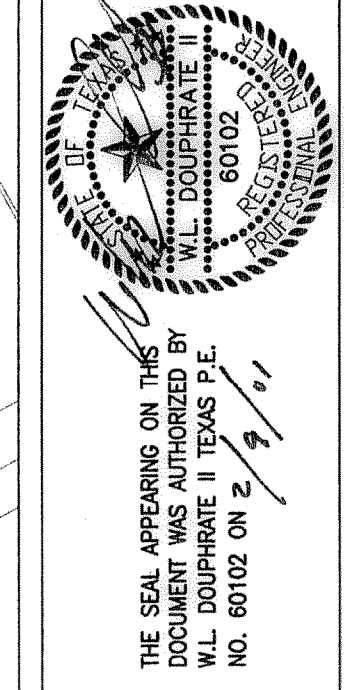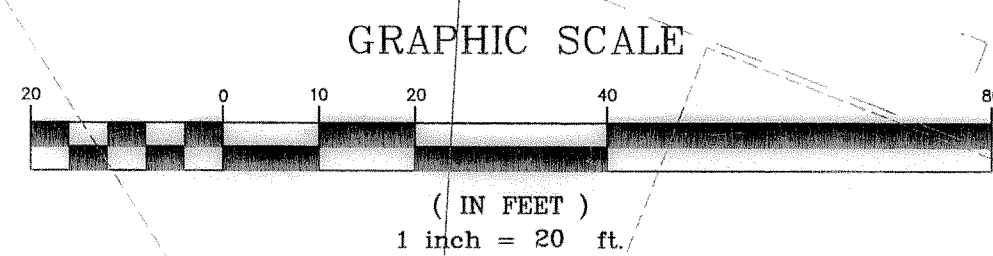

DOUPHRATE & ASSOCIATES, INC.
ENGINEERING • PROJECT MANAGEMENT • SURVEYING
2235 RIDGE RD., # 200 ROCKWALL, TEXAS 75087
PHONE: (972) 771-9004 FAX: (972) 771-9005

TREE PRESERVATION PLAN
SHEET 8
TIMBER CREEK ESTATES
CITY OF ROCKWALL, ROCKWALL COUNTY, TEXAS

3:1 SLOPE 01/01
REVISION
W.L.D.
CHECKED
K.E.B.
DRAWN
7/25/00
DATE
9913TR-8
PROJECT
17
OF