




OWNER/DEVELOPER  
 TAYLOR DUNCAN INTERESTS, INC.  
 5000 QUORUM DRIVE, SUITE 395  
 DALLAS, TEXAS 75240  
 (972) 404-8500

REVISED TO CONFORM TO CONSTRUCTION RECORDS.  
 DATE: 5/22/03

- TREE LEGEND
- BOIS D'ARC
  - CEDAR
  - CHINA BERRY
  - COTTONWOOD
  - ELM
  - HACKBERRY
  - LOCUST
  - MESQUITE
  - WILLOW

LEGEND

XXXX TREES TO BE SAVED

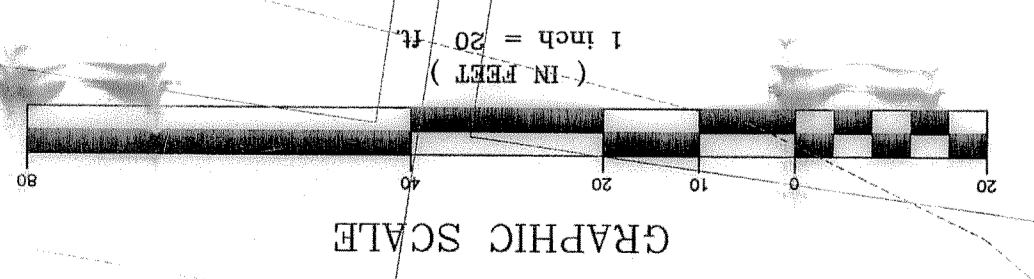

18 OF 18

PROJECT: 991317T-9  
 DATE: 7/25/00  
 DRAWN: K.E.B.  
 CHECKED: W.L.D.  
 REVISION:

**TREE PRESERVATION PLAN**  
**SHEET 9**  
**TIMBER CREEK ESTATES**  
 CITY OF ROCKWALL, ROCKWALL COUNTY, TEXAS

**DOUPHRAVE & ASSOCIATES, INC.**  
 ENGINEERING • PROJECT MANAGEMENT • SURVEYING  
 2235 RIDGE RD., # 200 ROCKWALL, TEXAS 75087  
 PHONE: (972)771-9004 FAX: (972)771-9005

THE SEAL APPEARING ON THIS DOCUMENT WAS AUTHORIZED BY W.L. DOUPHRAVE II TEXAS P.E. NO. 60102 ON 1/19/11