
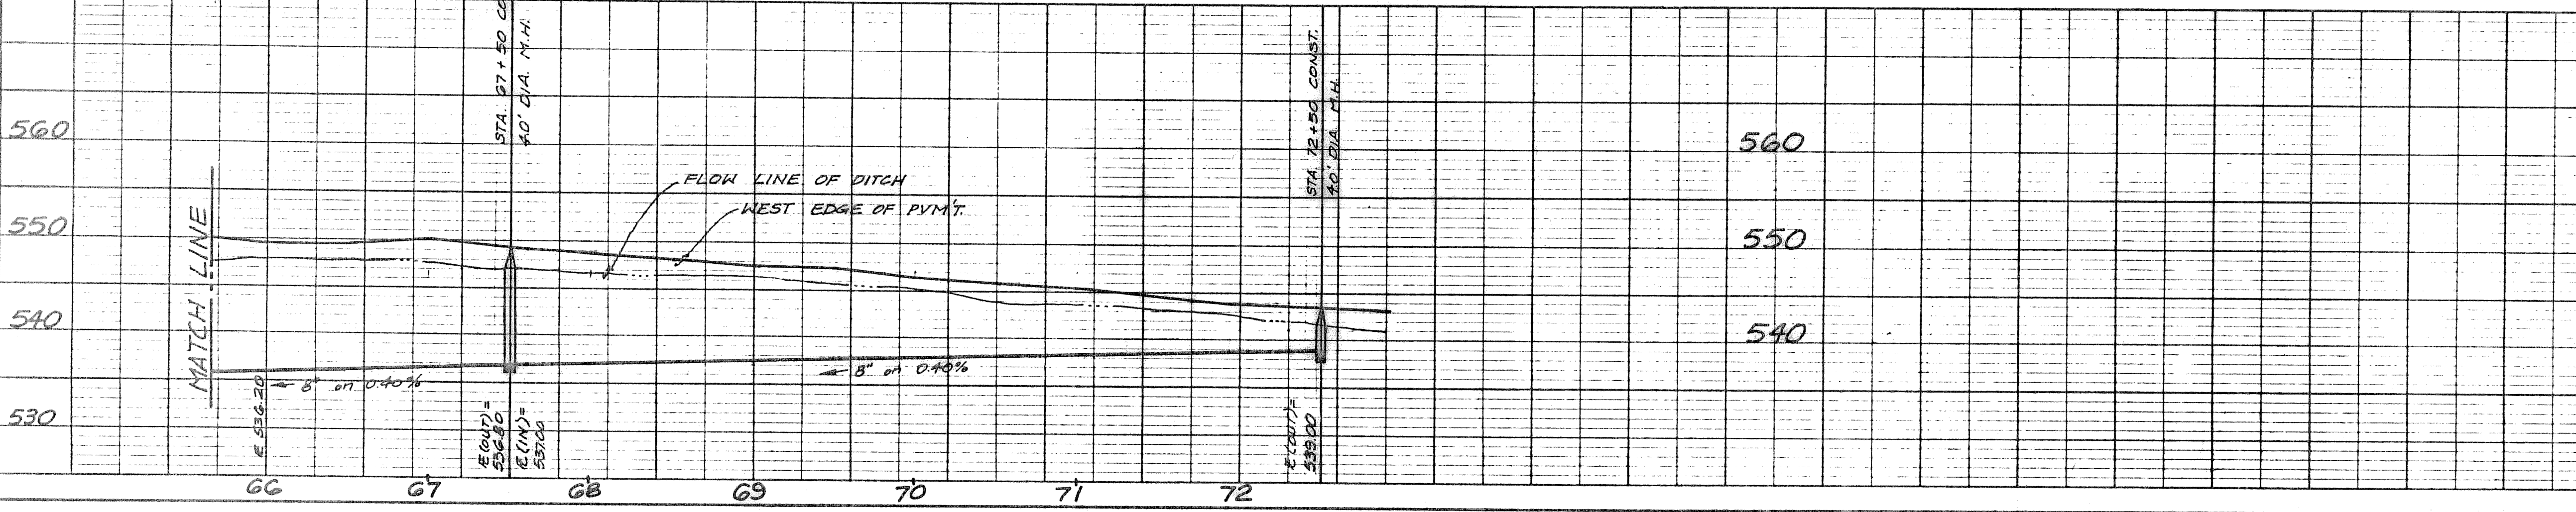
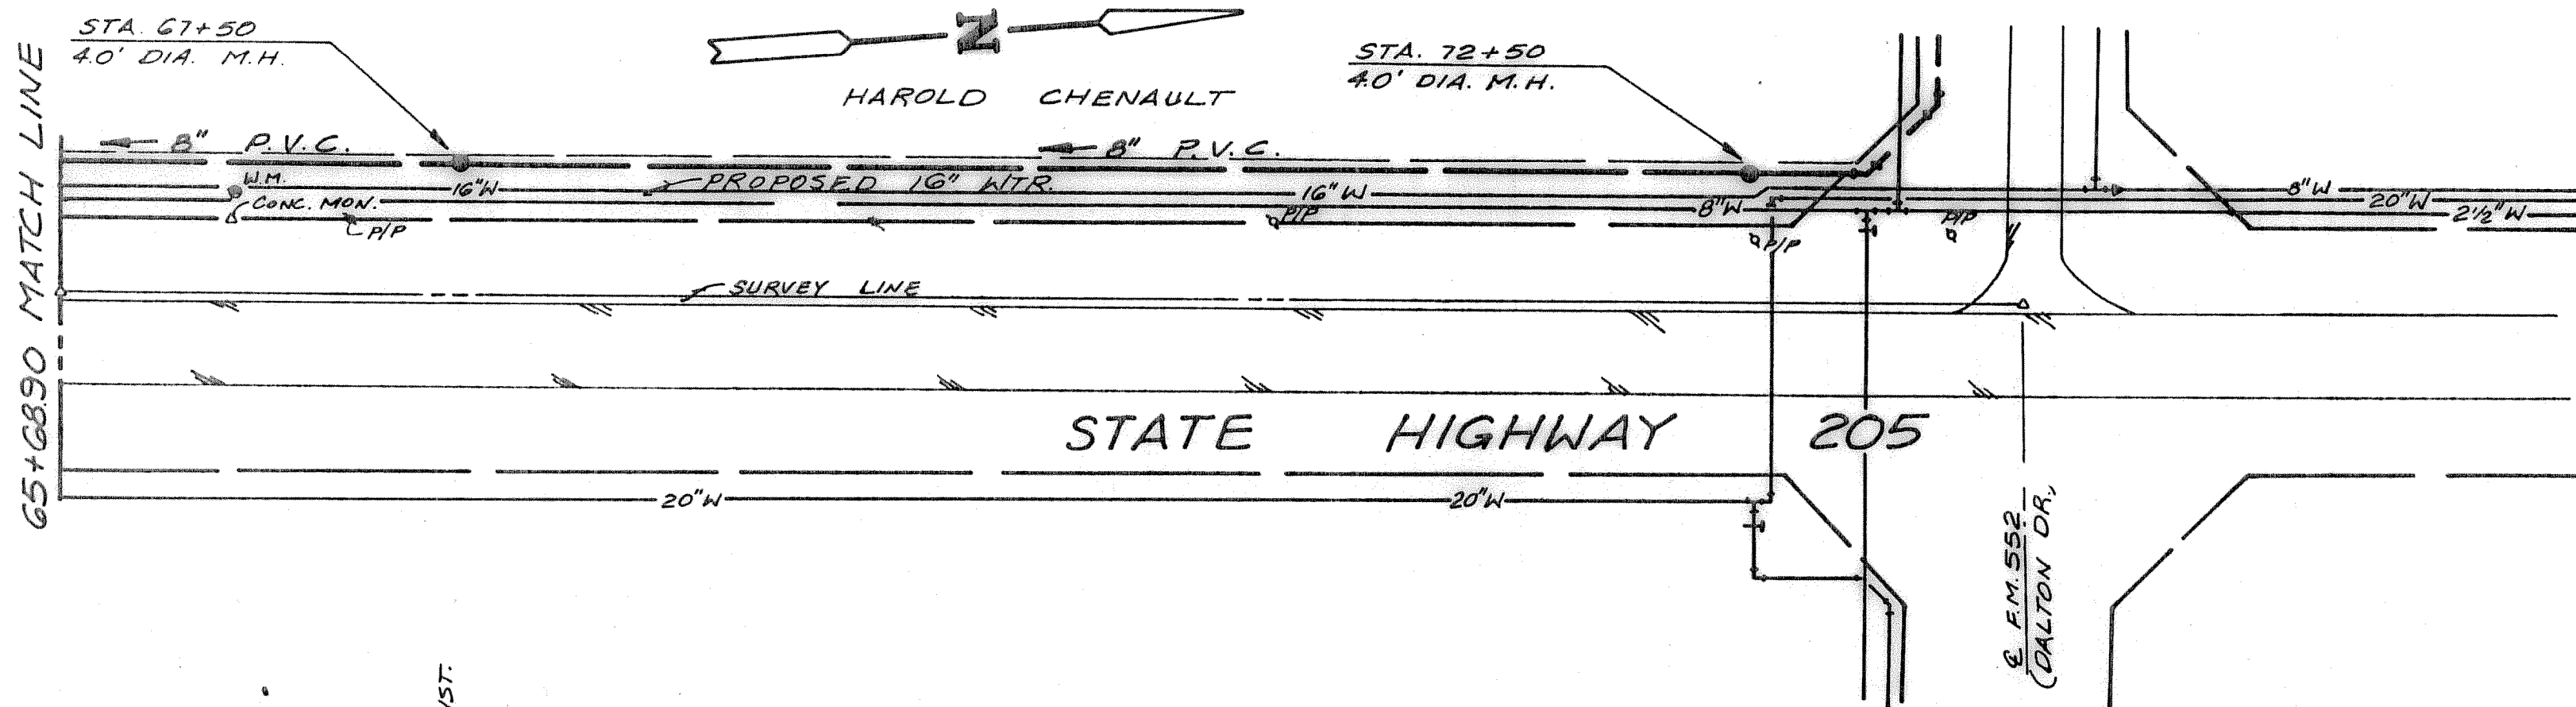
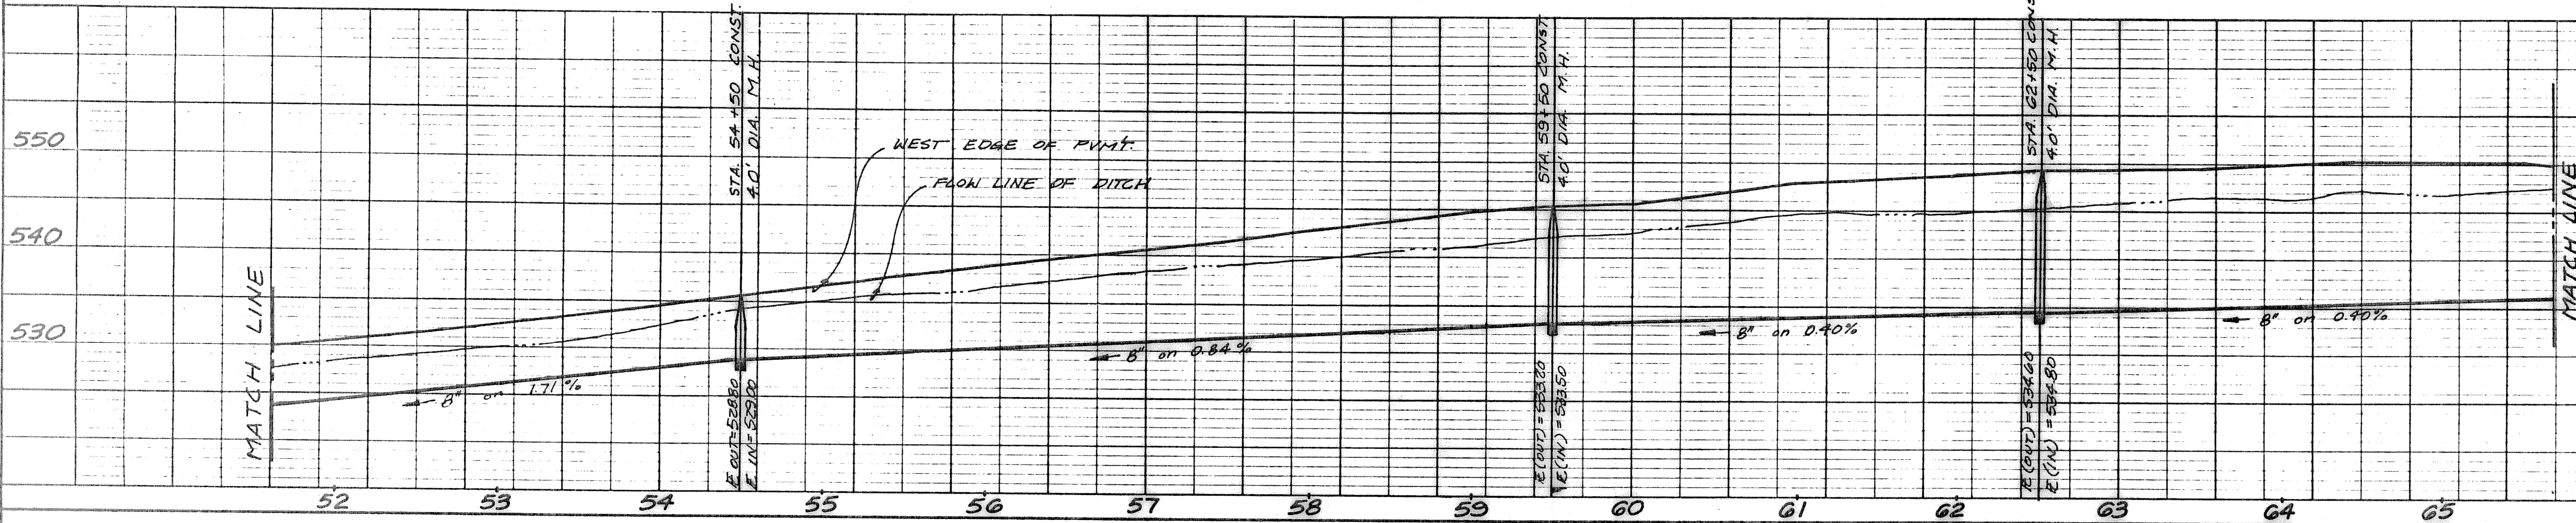


PLAN
 CHECKED BY: []
 DATE: []
 NO. []

PROFILE
 CHECKED BY: []
 DATE: []
 NO. []

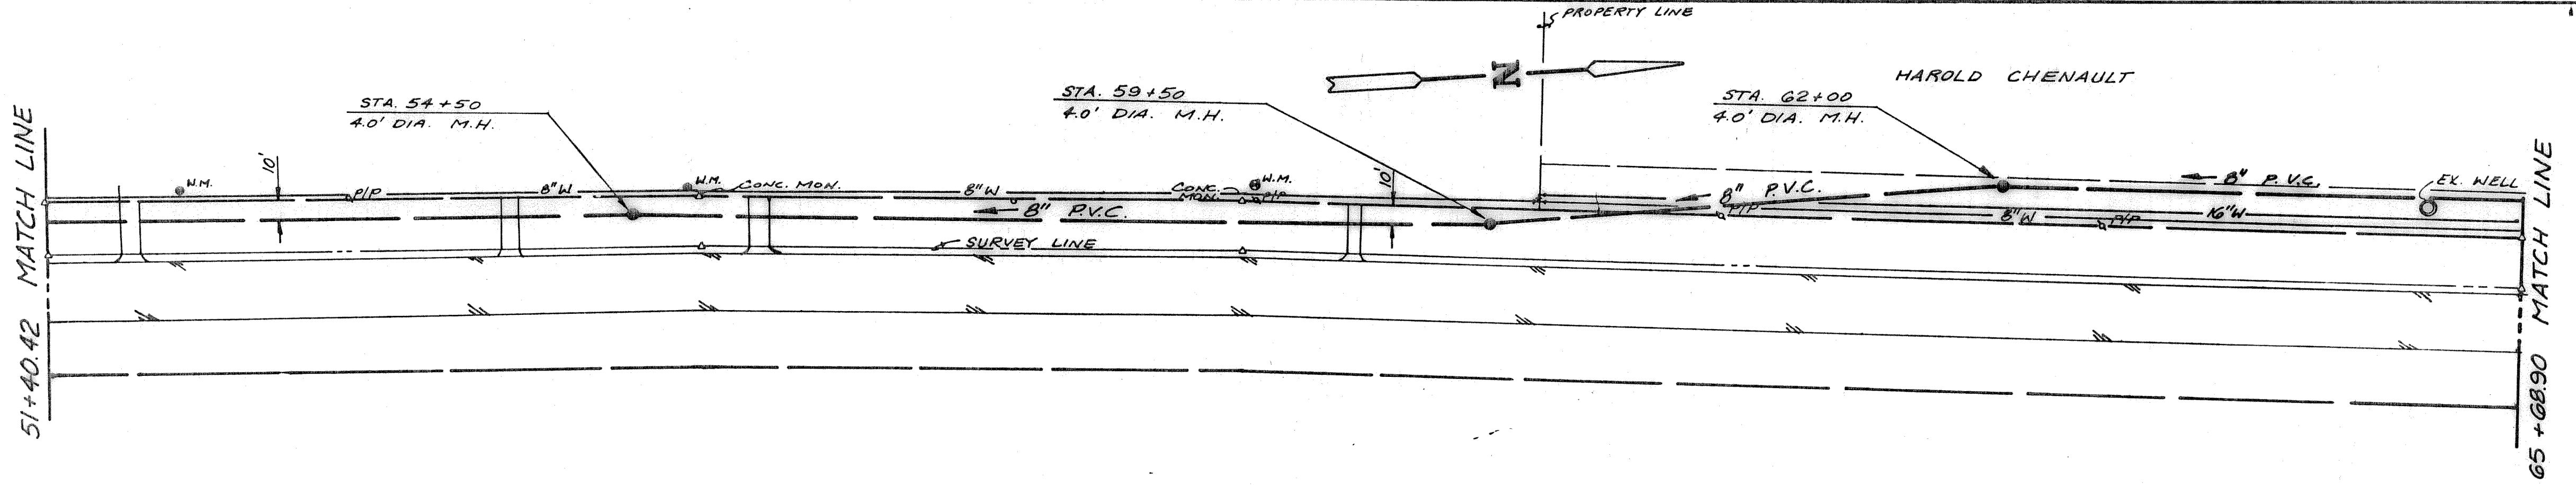

SAN SEWER IMPROVEMENTS
 FOR HARLAN PARK - PHASE ONE
 CITY OF ROCKWALL
 ROCKWALL COUNTY, TEXAS

HAROLD L. EVANS - CONSULTING ENGINEER

DESIGN	DRAWN	DATE	SCALE	NOTES	FILE	NO.
H.L.E.	B.D.W.	6-13-85	1" = 60' H 1" = 10' V			89213