


\$PLOTDRVSYS

\$MODELNAMES


\$USERS\$CLIENTS\$FILES

\$DATES \$TIMES

STORM LINE 'A'

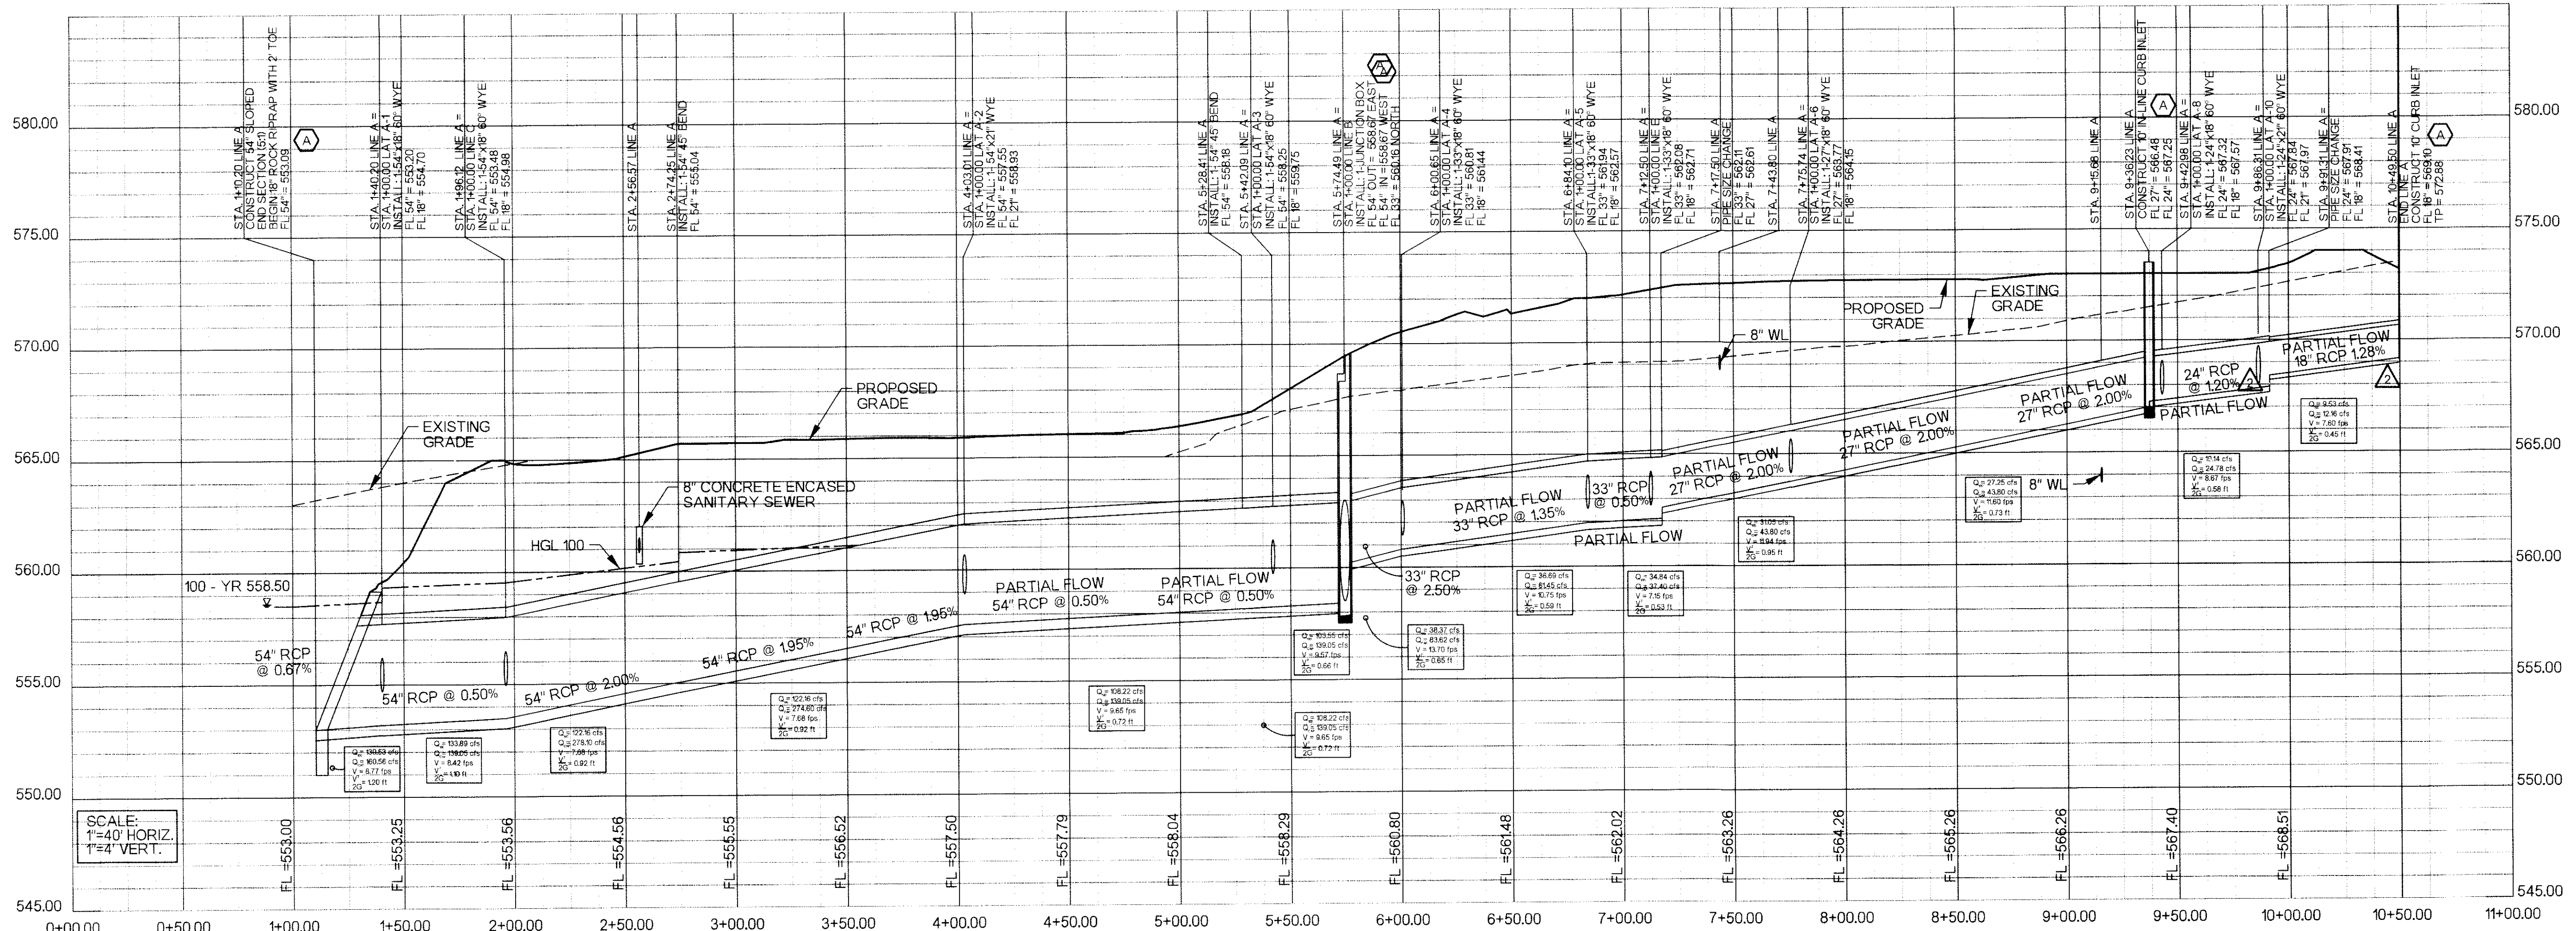

STORM LINE 'B'

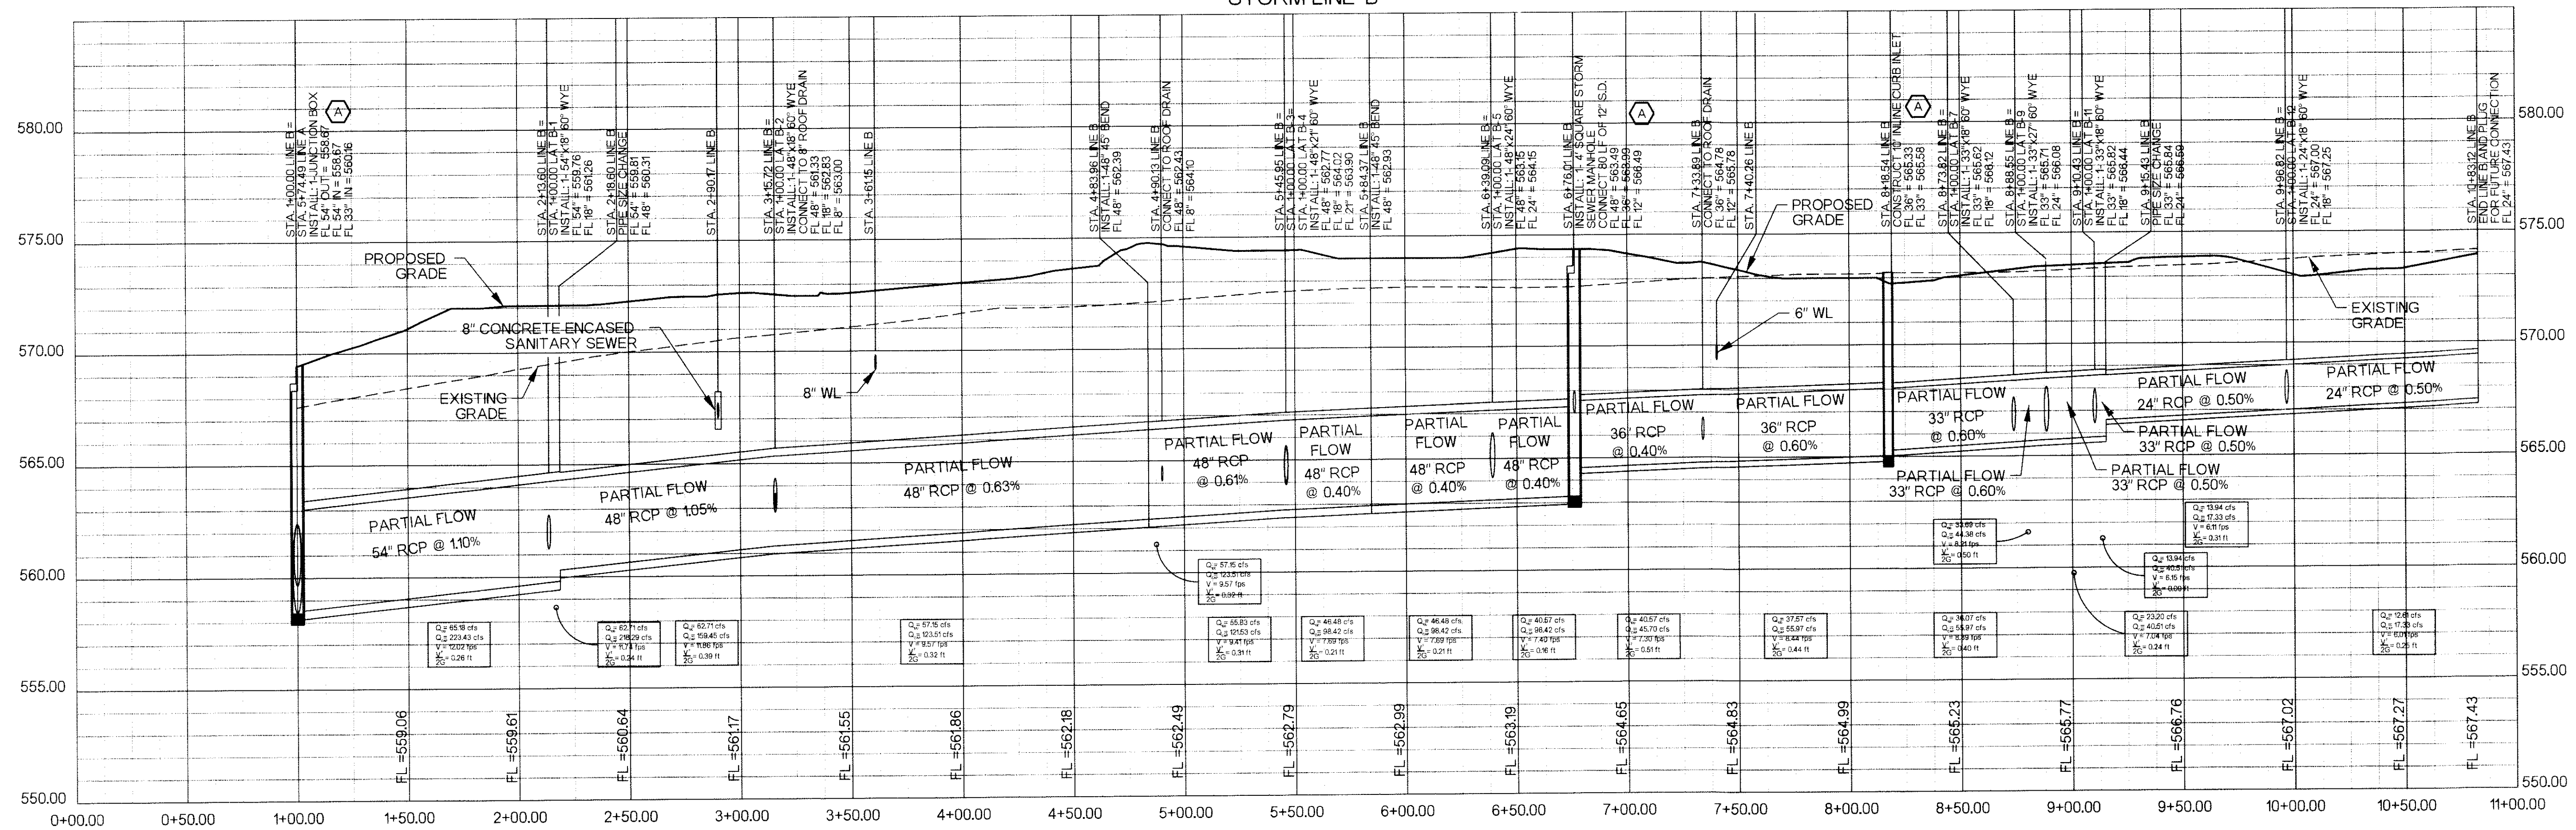


ROCKWALL COUNTY
COURTHOUSE
 ROCKWALL COUNTY
 ROCKWALL, TEXAS



Revision No.	Date	Description
1	04/06/2010	SITE PLAN REVISIONS
2	04/13/2010	PIPE MATERIAL CHANGE
3	07/12/2010	FROM HDPE TO RCP
4	03/29/2011	CHANGE HDPE TO RCP AS BUILT ELEVATIONS

RECORD DRAWING

APRIL 2011
 These Record Documents have been prepared based upon information provided by Manhattan Construction. The Design Professional has not verified the accuracy and / or completeness of this information and shall not be responsible for any errors or omissions which may be incorporated herein as a result of Design Consultant: Half Associates, Inc.
 RECORD DRAWING SUBMITTAL

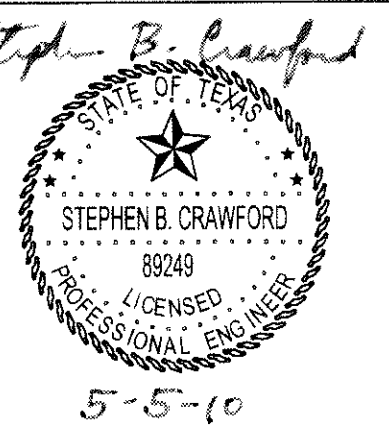

Project No.:	26244
Issued:	APRIL 2011
Drawn By:	BJG
Checked By:	SBC
Scale:	AS NOTED
Sheet Title:	STORM DRAIN PROFILES
Sheet Number:	C5.05