
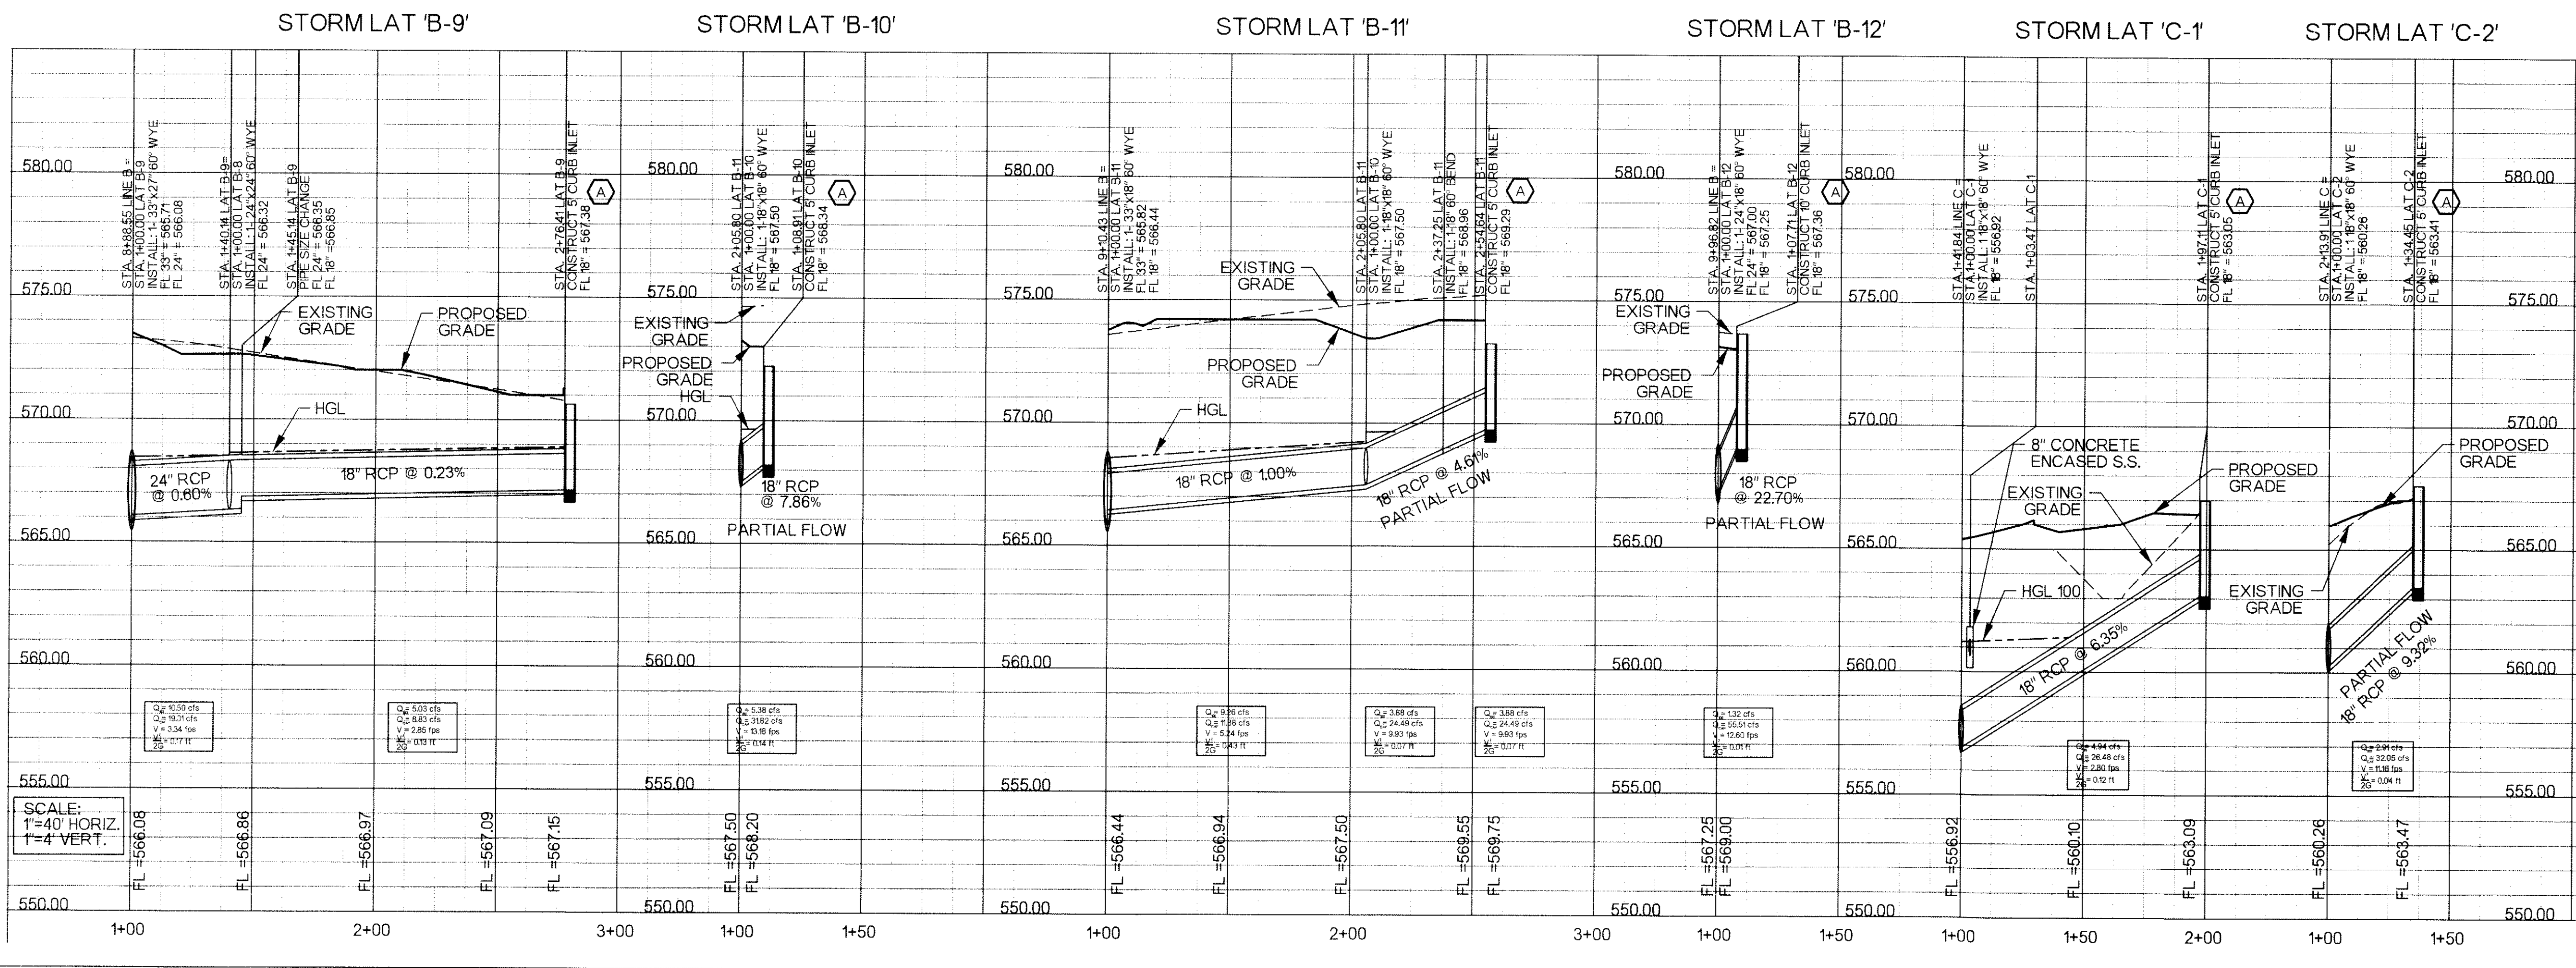


SPLTDRVSS

SMODELNAME

SSTATES STIMES SUBERSCLIENTS FILELES

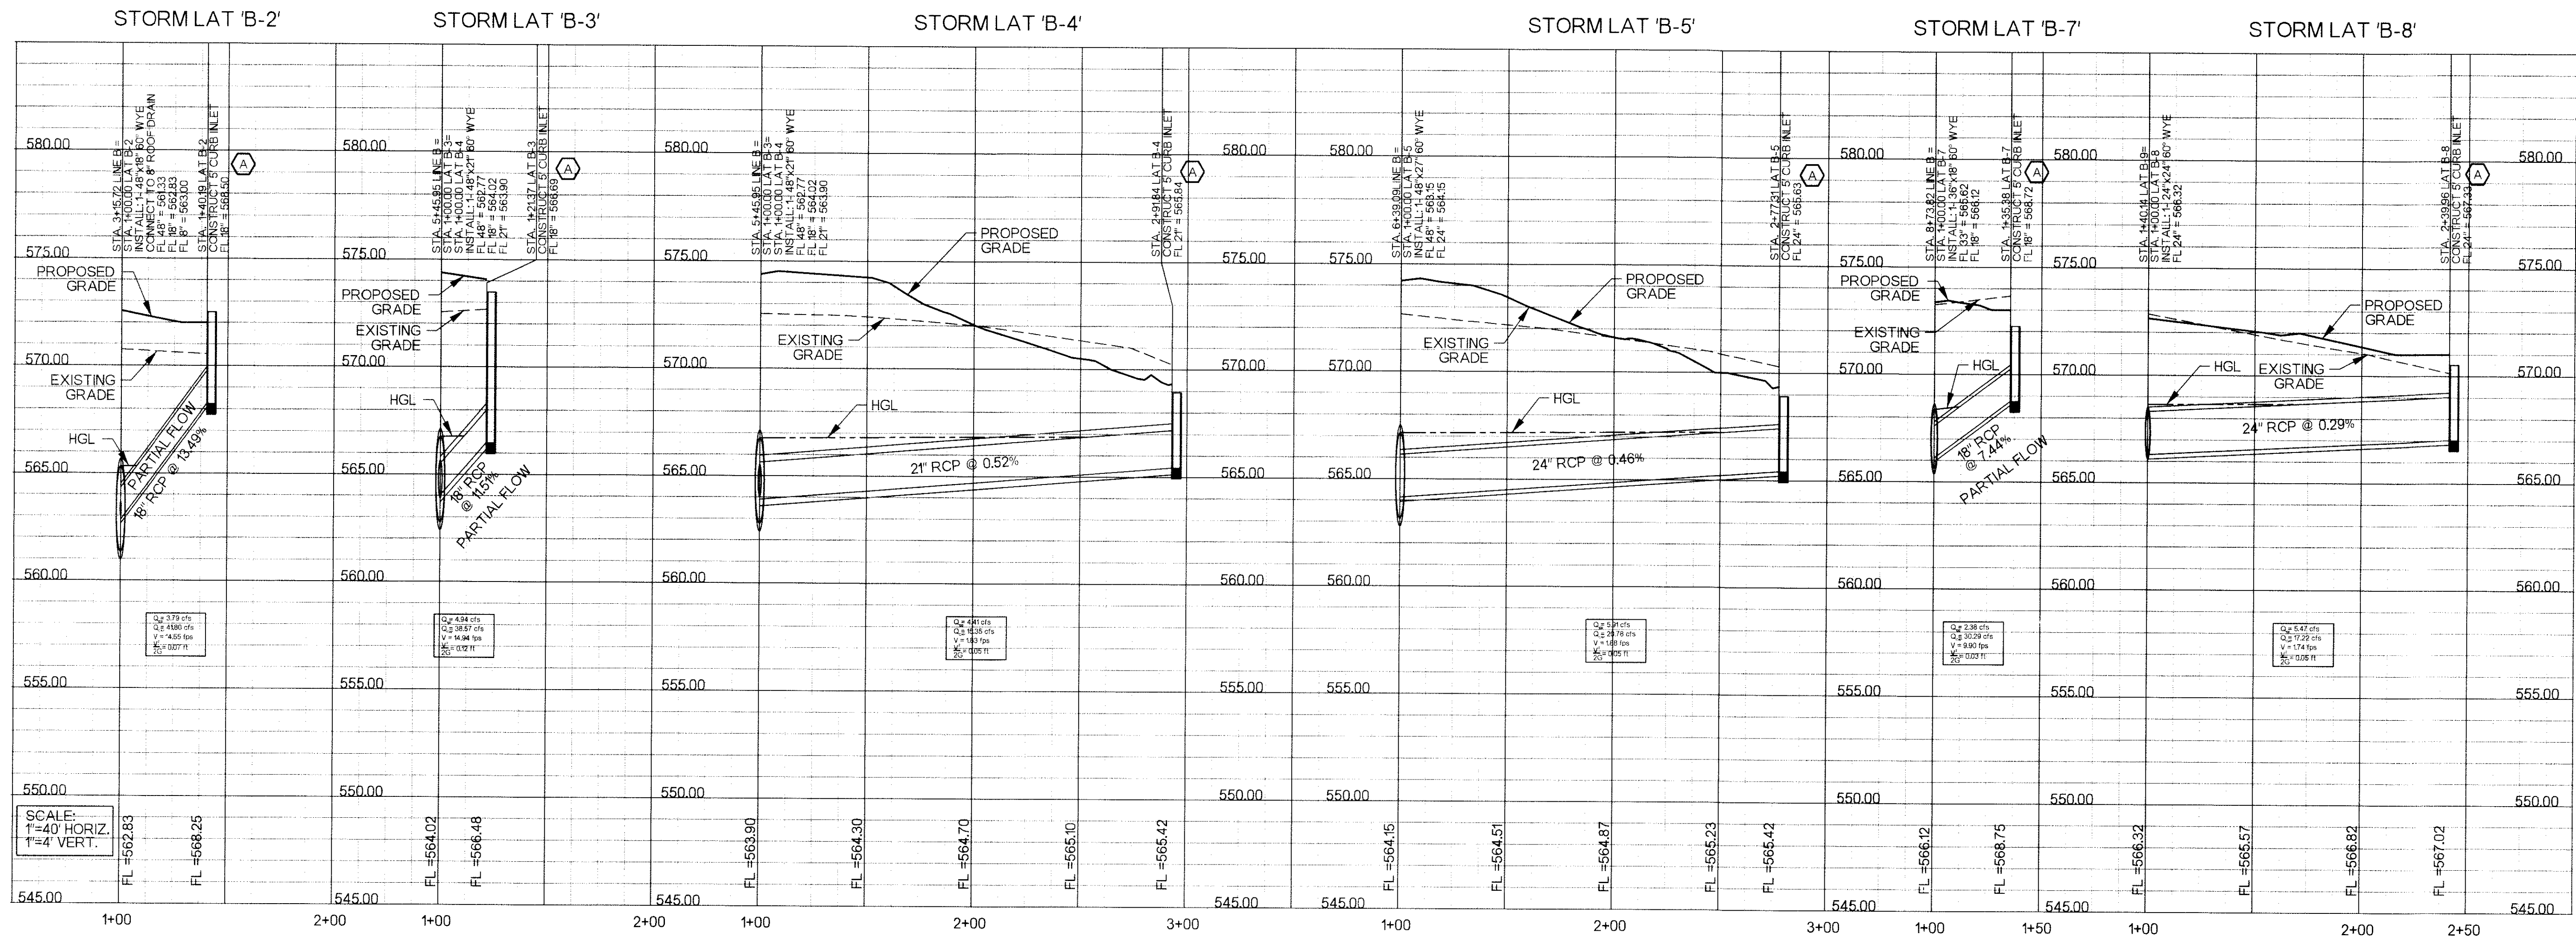


ROCKWALL COUNTY  
COURTHOUSE  
ROCKWALL COUNTY  
ROCKWALL, TEXAS



Revision No.	Date	Description
1	04/06/2010	SITE PLAN REVISIONS
2	07/12/2010	CHANGE HDPE TO RCP
3	03/28/2011	AS-BUILT ELEVATIONS

**RECORD DRAWING**  
APRIL 2011  
These Record Documents have been prepared based upon information provided by Manhattan Construction. The Design Professional has not verified the accuracy and / or completeness of this information and shall not be responsible for any errors or omissions which may be incorporated herein as a result. Design Consultant: Half Associates, Inc.  
RECORD DRAWING SUBMITTAL

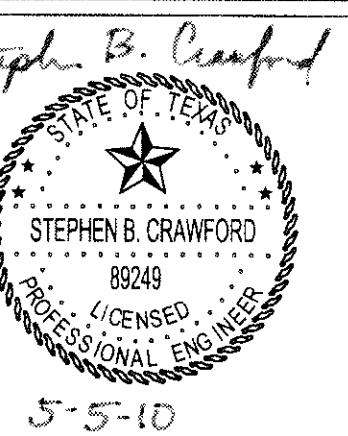

Project No.: 26244  
Issued: APRIL 2011  
Drawn By: BJG  
Checked By: SBC  
Scale: AS NOTED  
Sheet Title: STORM DRAIN PROFILES

**C5.06B**  
Sheet Number